


SEE 1

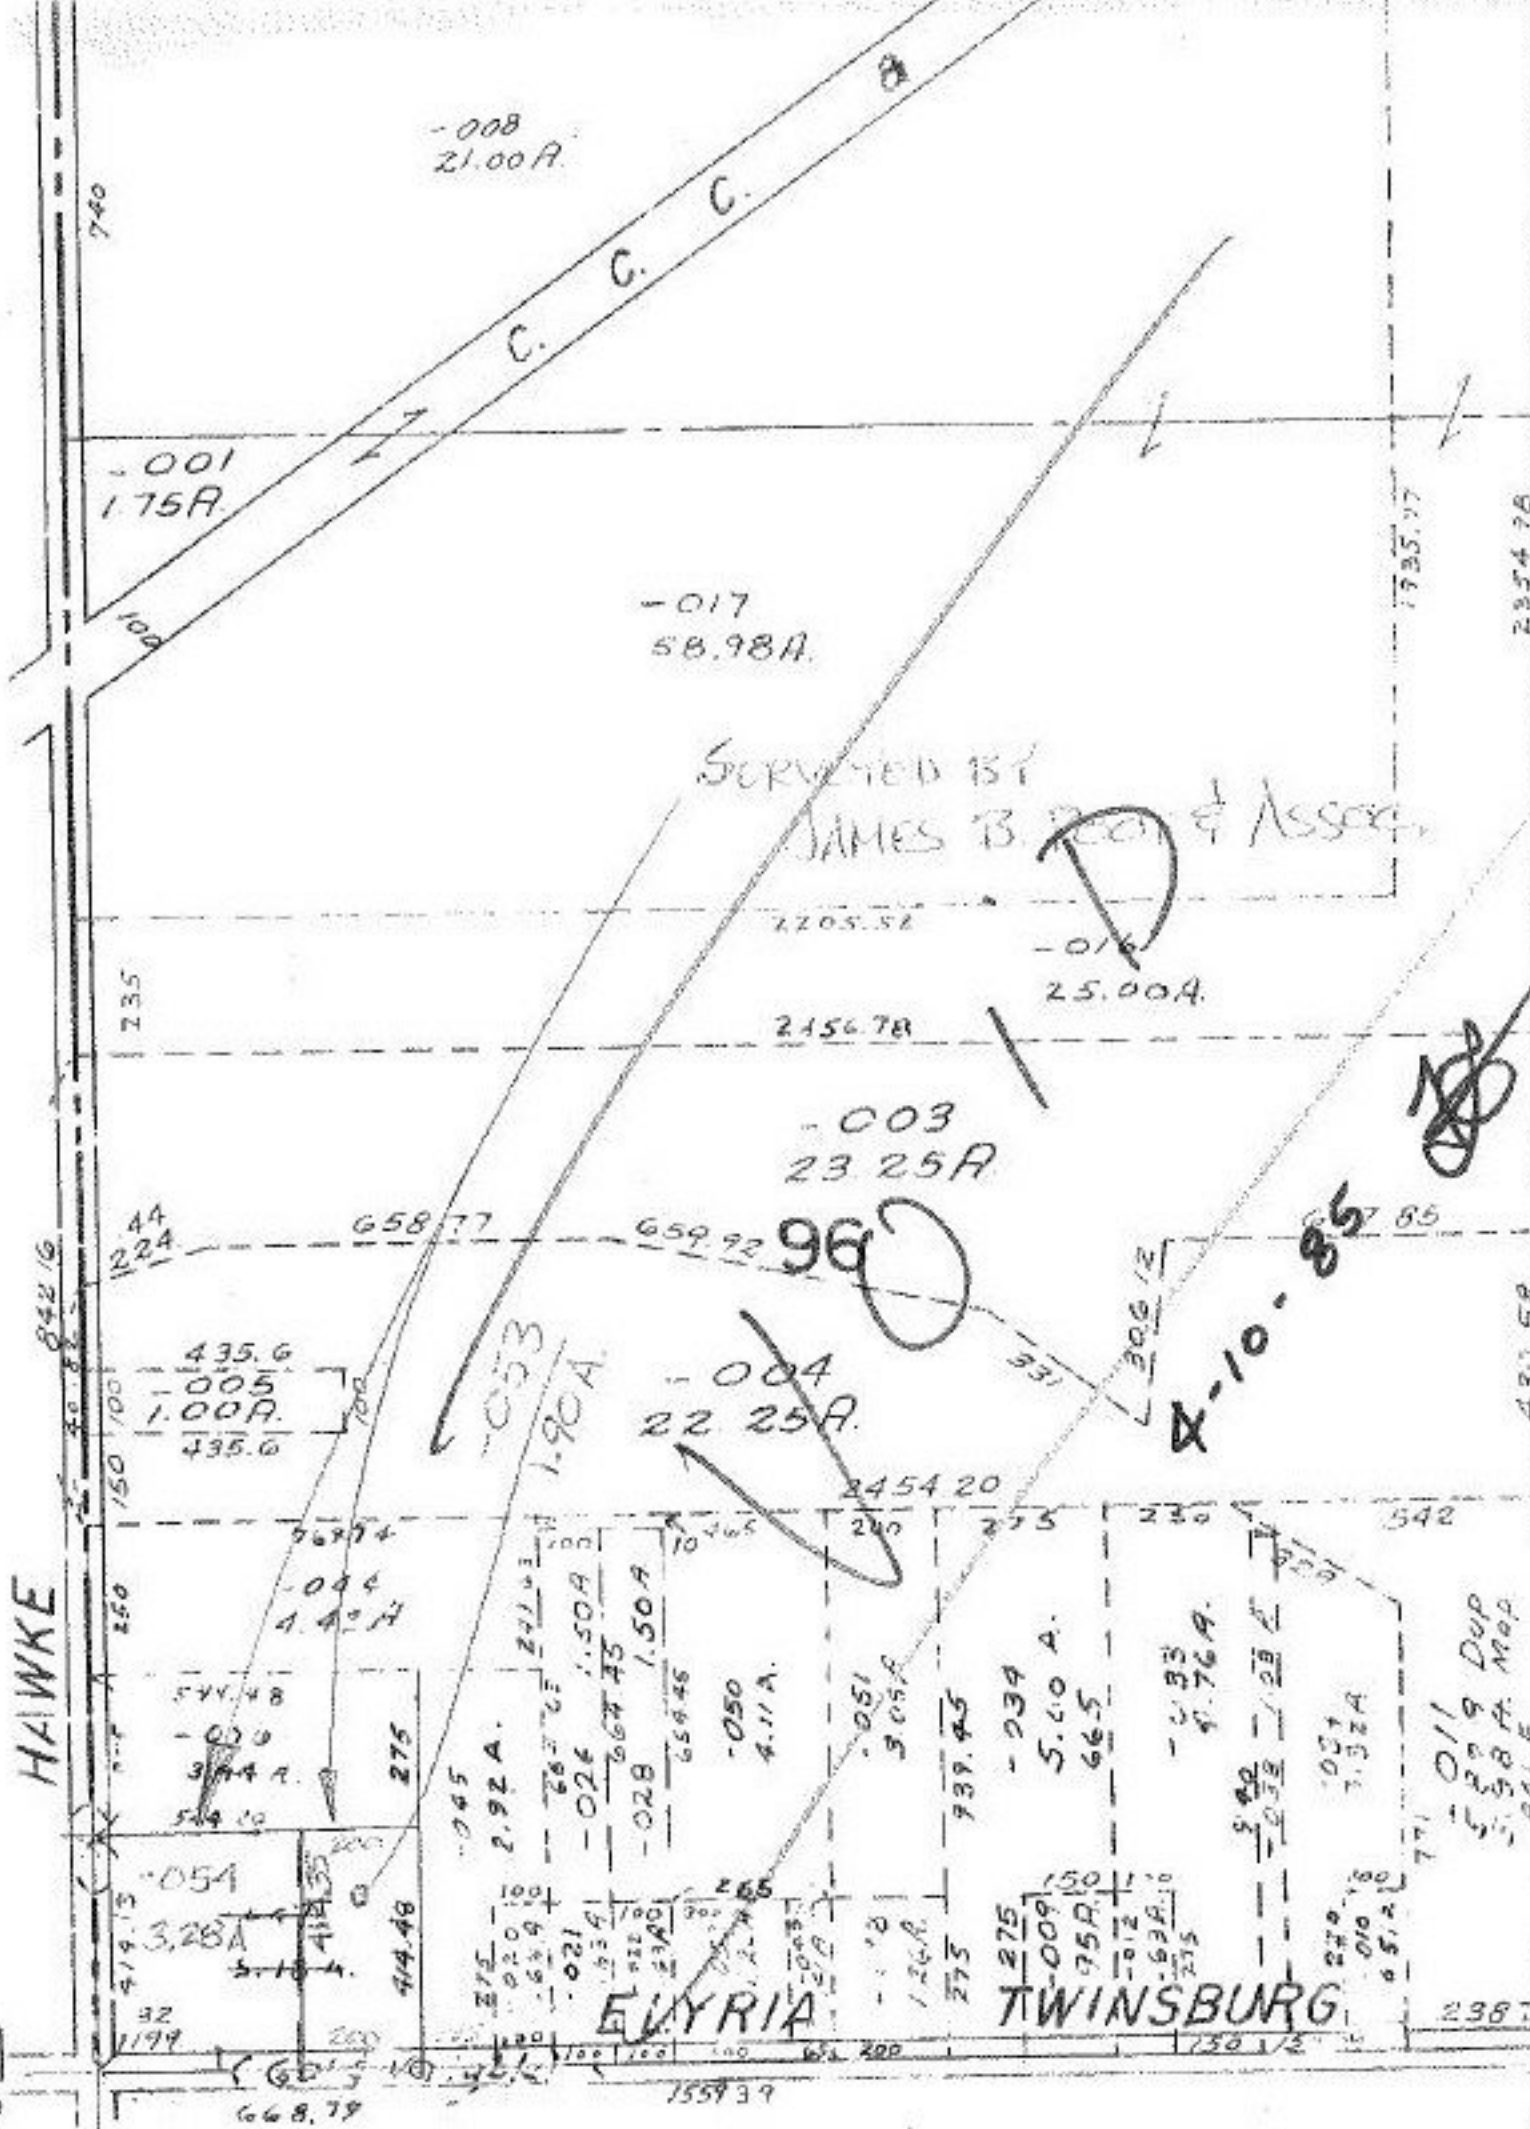

SURVEYED BY
JAMES B. [unclear] & Assoc.

D

2-10-85

HAWKE

Elyria

Twinsburg

#16020

APPROVED
LORAIN CO.
MAP DEPT.

DATE 2-19-85

PAGE 12-A

BY T. McMain

VOID
IF

LOTS 76 THRU 85, 96 THRU 100

5.18
1.90
3.28

3.27
1.90
5.17

-002
25.00A

-001
24.96A

430.58
805.20

1935.77

2354.76

-016
25.00A

2156.78

-017
58.98A

-001
1.75A

-008
21.00A

-003
23.25A

-004
22.25A

435.6
-005
1.00A
435.6

-044
4.40A

544.48
-030
3.44A
544.10

-054
3.28A

-045
2.92A

-026
1.50A

-028
1.50A

-050
4.11A

-051
3.05A

-034
5.40A

-033
4.76A

-007
1.32A

011
5.89 Dup
5.98A Map
941.5

771
010
05.210

238

740

100

235

44
224

150
100

250

92
1199

668.79

1559.39

2205.52

2156.78

658.77
659.92

2454.20

240

275

230

542

306.12

331

1935.77

2354.76

430.58

805.20

542

771

238

2