


NOTE * CHANGE 4-00-017 A. ALSO * 7A

102

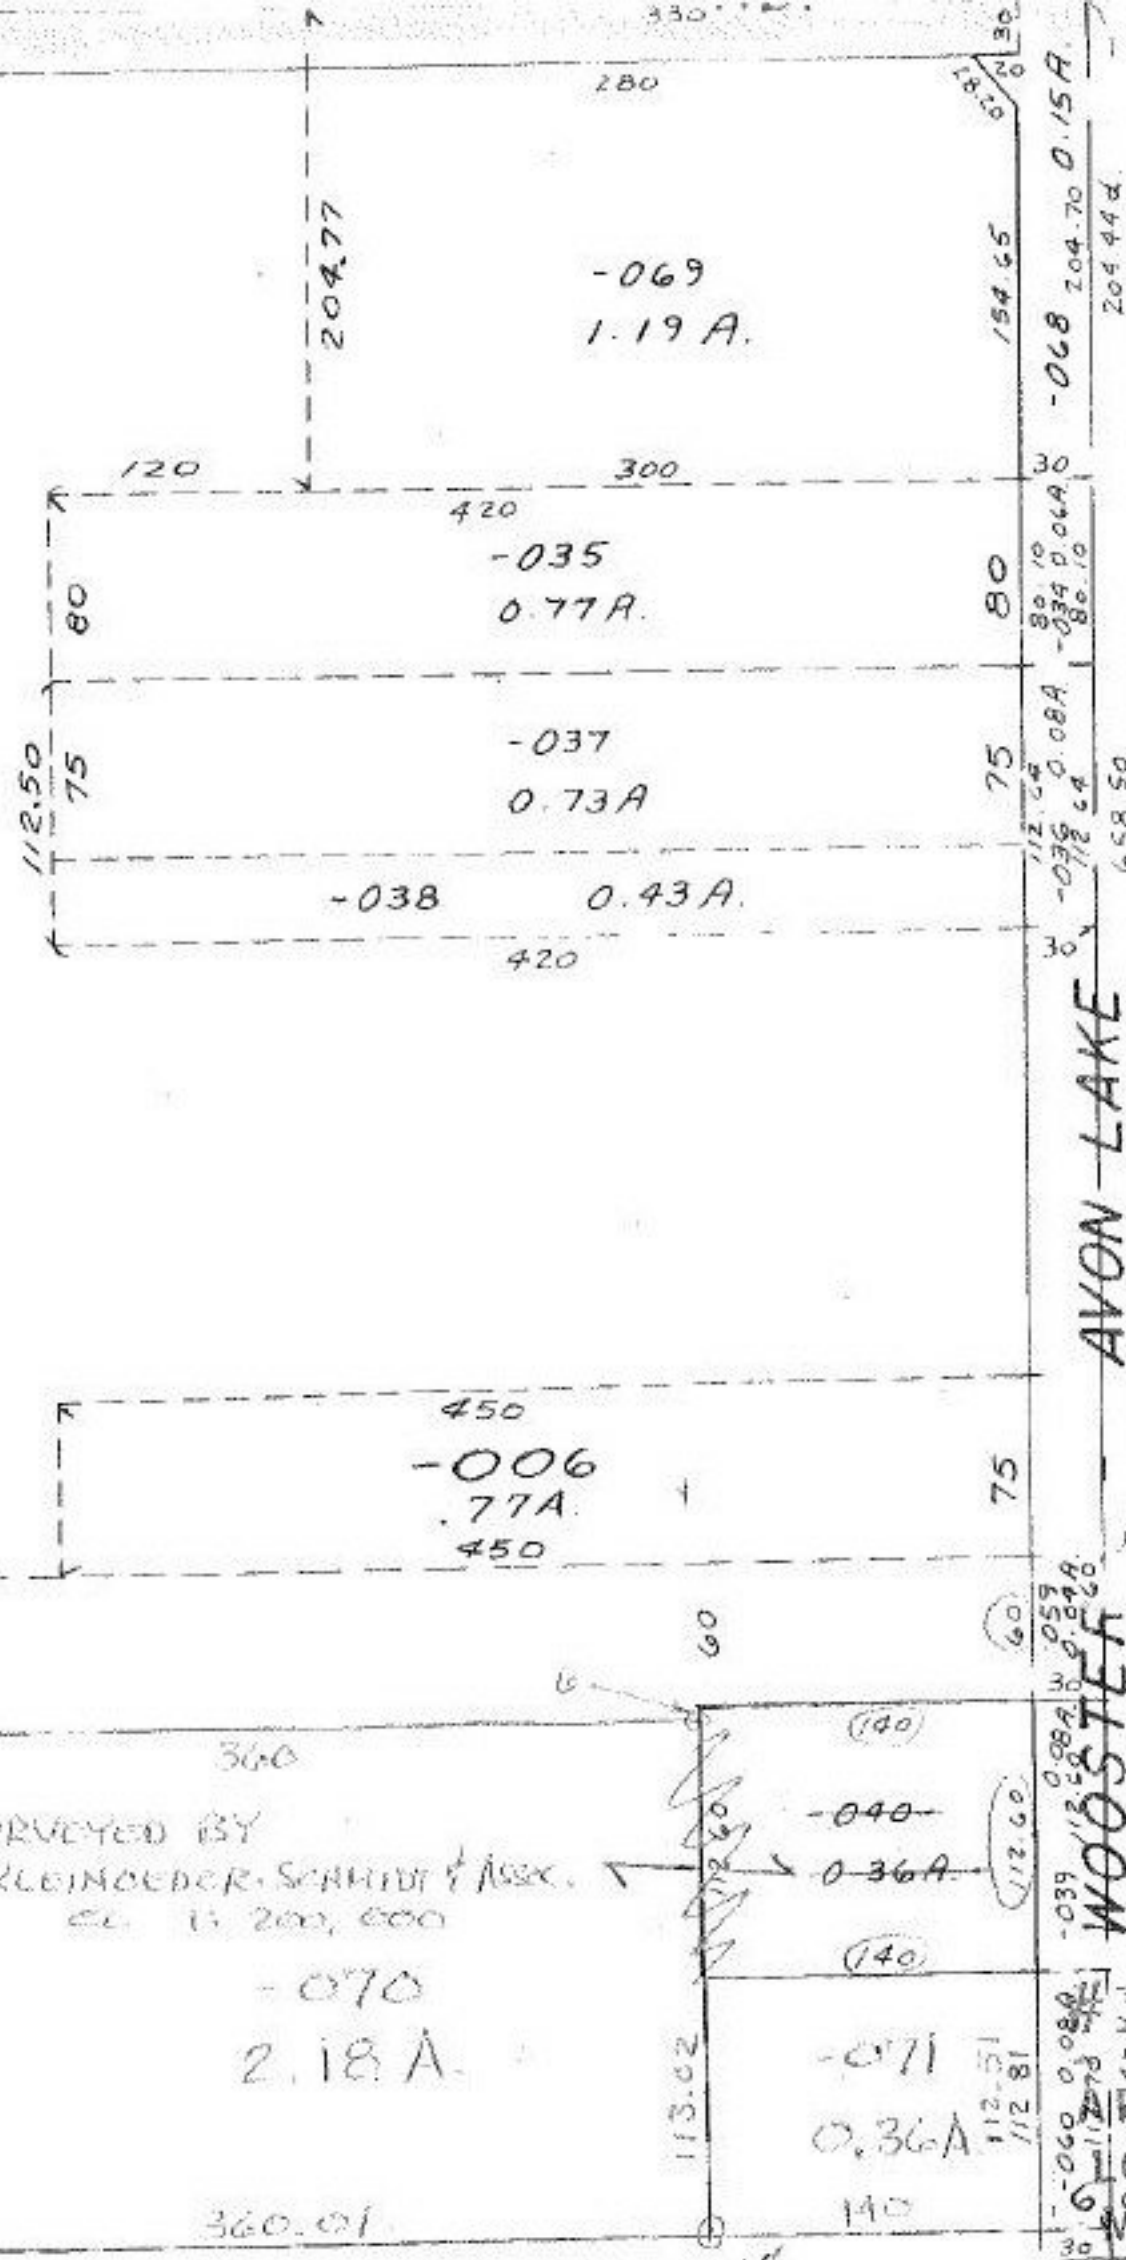

SURVEYED BY
KLEINODER, SCHMIDT & ASSOC.
CL. 15,200,000

Pt. 061
Pt. 14.84 A.

SEE 4-00-017-F

CL. 1,100,000

* ALSO CHANGE
4-00-017-A

6024
APPROVED
LORAIN CO.
MAP DEPT.

DATE 2-14-85
PAGE 4-00-017-E
BY T.H. McNamee
VOID
T.H.
3/21/85