


SEE SURVEY  
 N. R. HURA & Assoc  
 1527.777

PUT ON PAGE  
 5-00-060-A

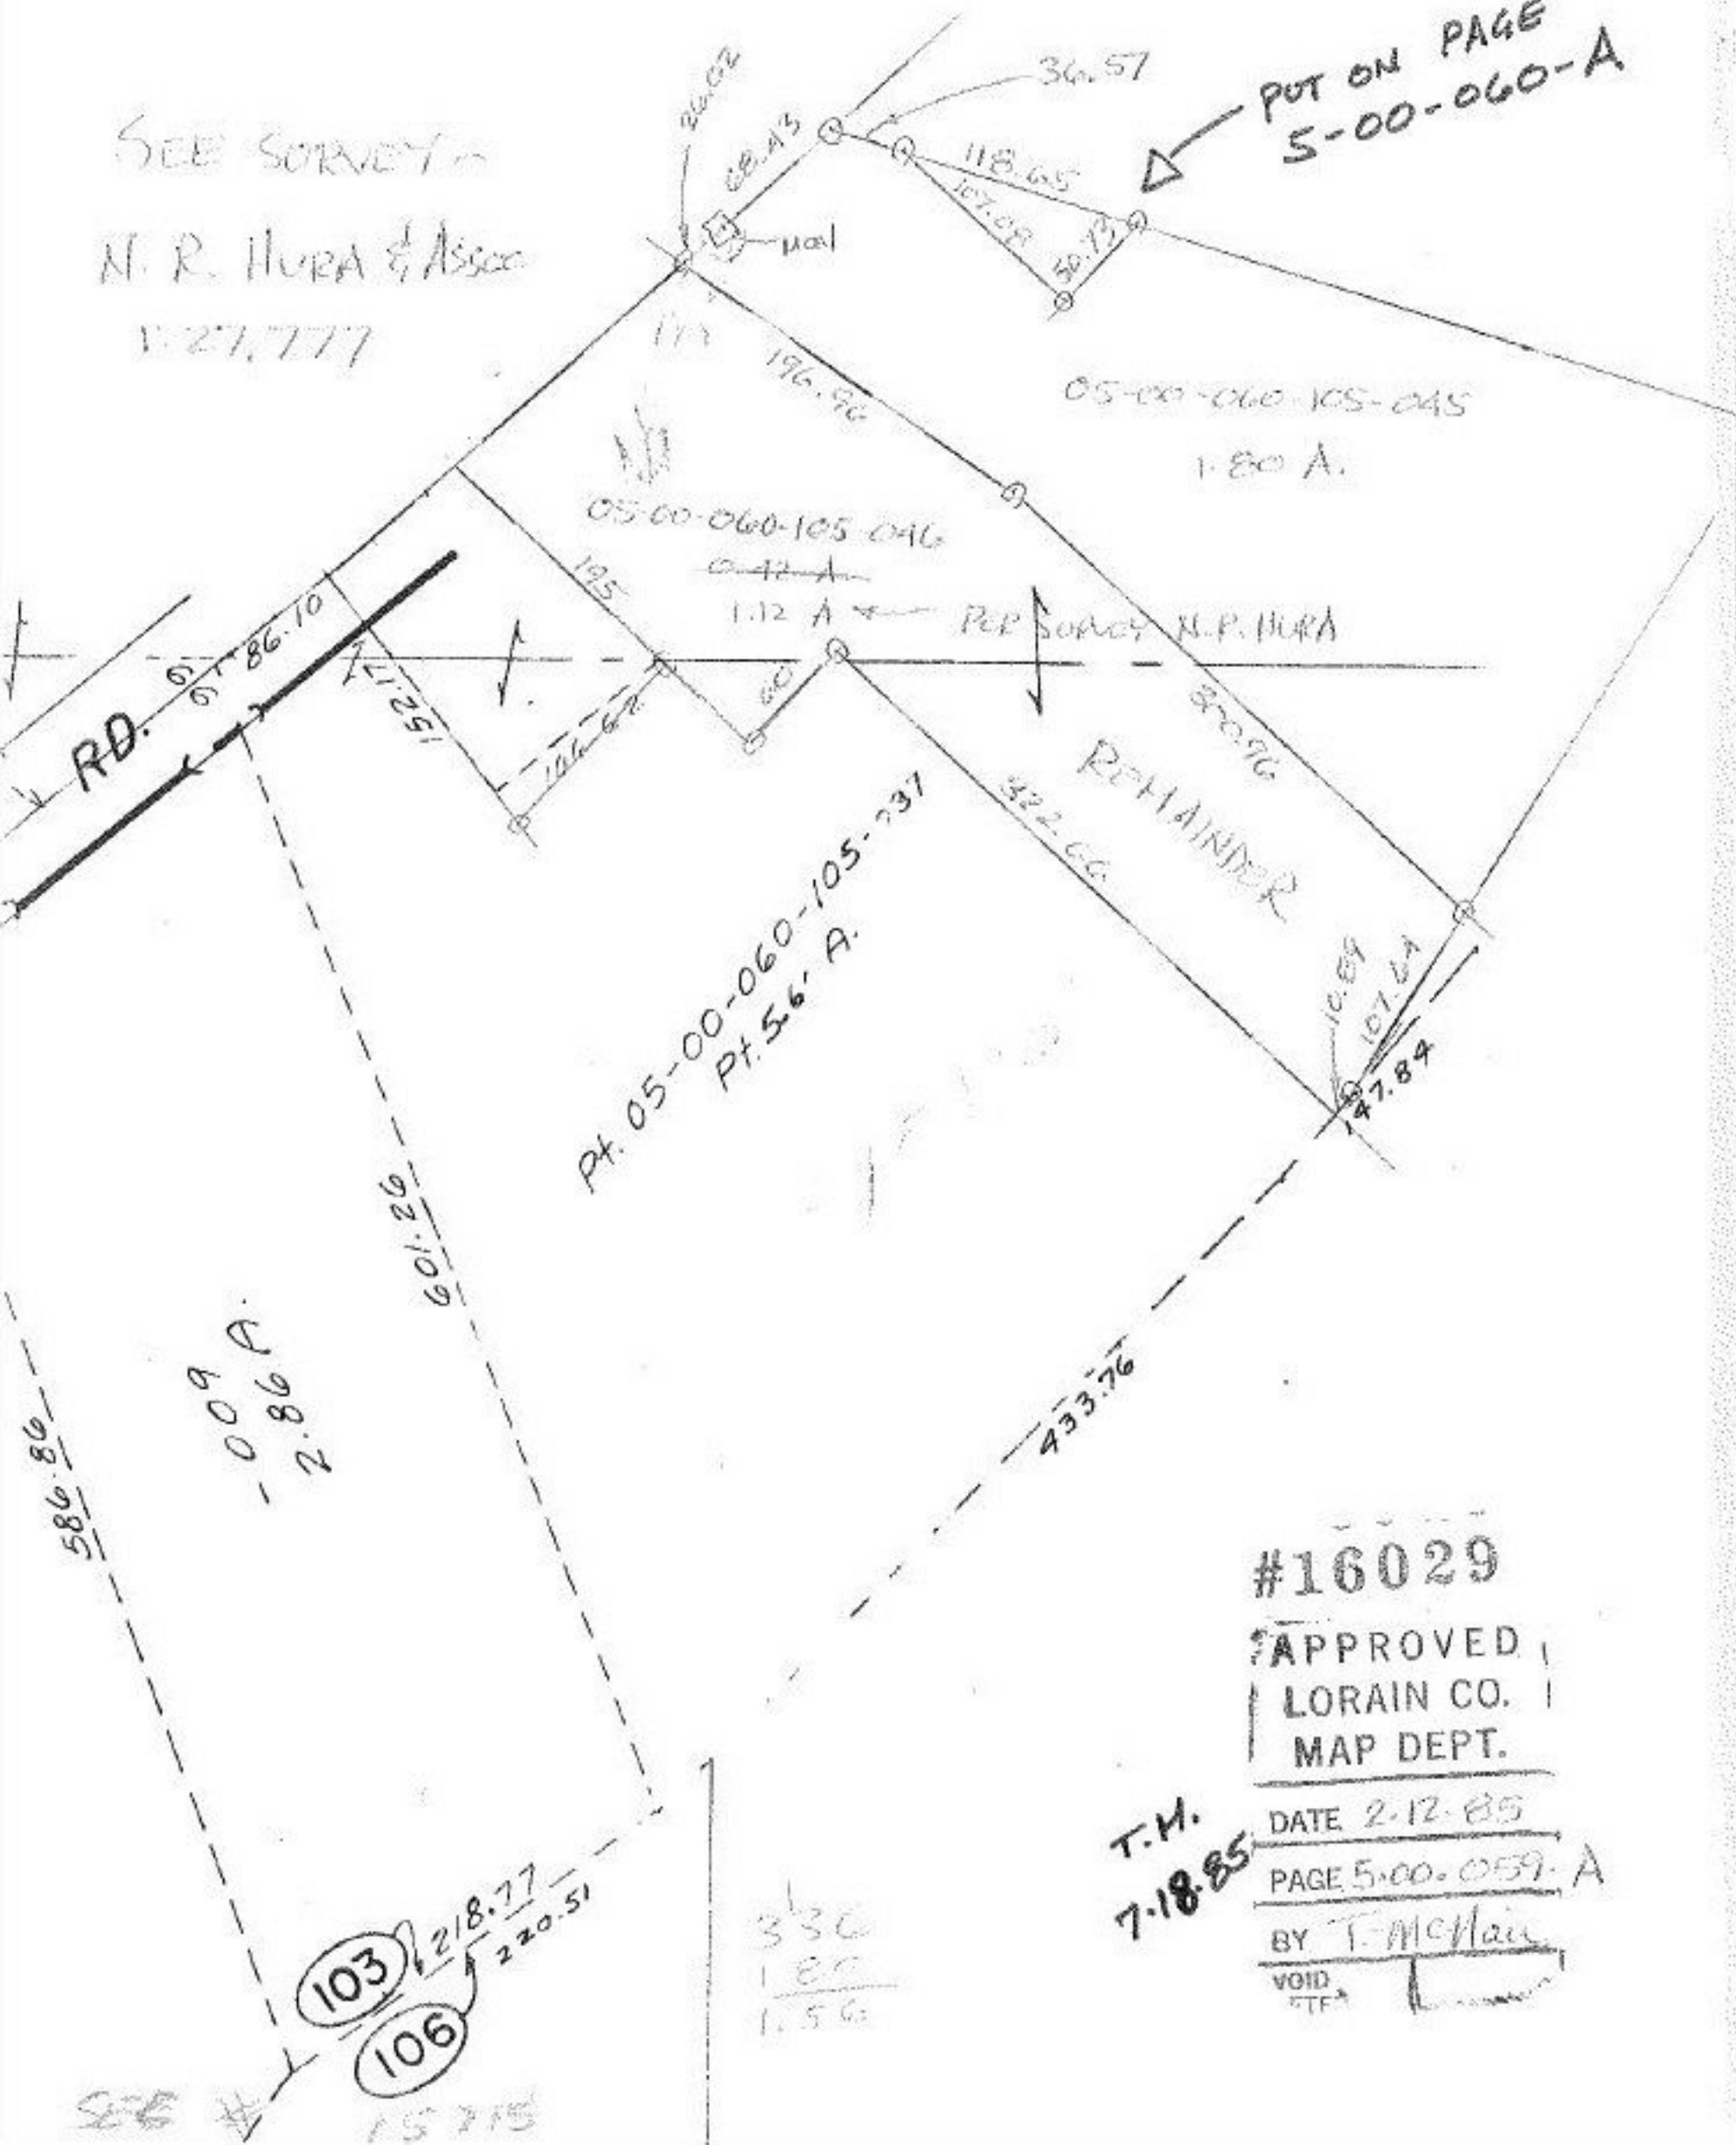

#16029

APPROVED  
 LORAIN CO.  
 MAP DEPT.

T.M.  
 7-18-85

DATE 2-12-85  
 PAGE 5-00-059-A  
 BY T. McHain  
 VOID  
 STE