


SEE 4-00

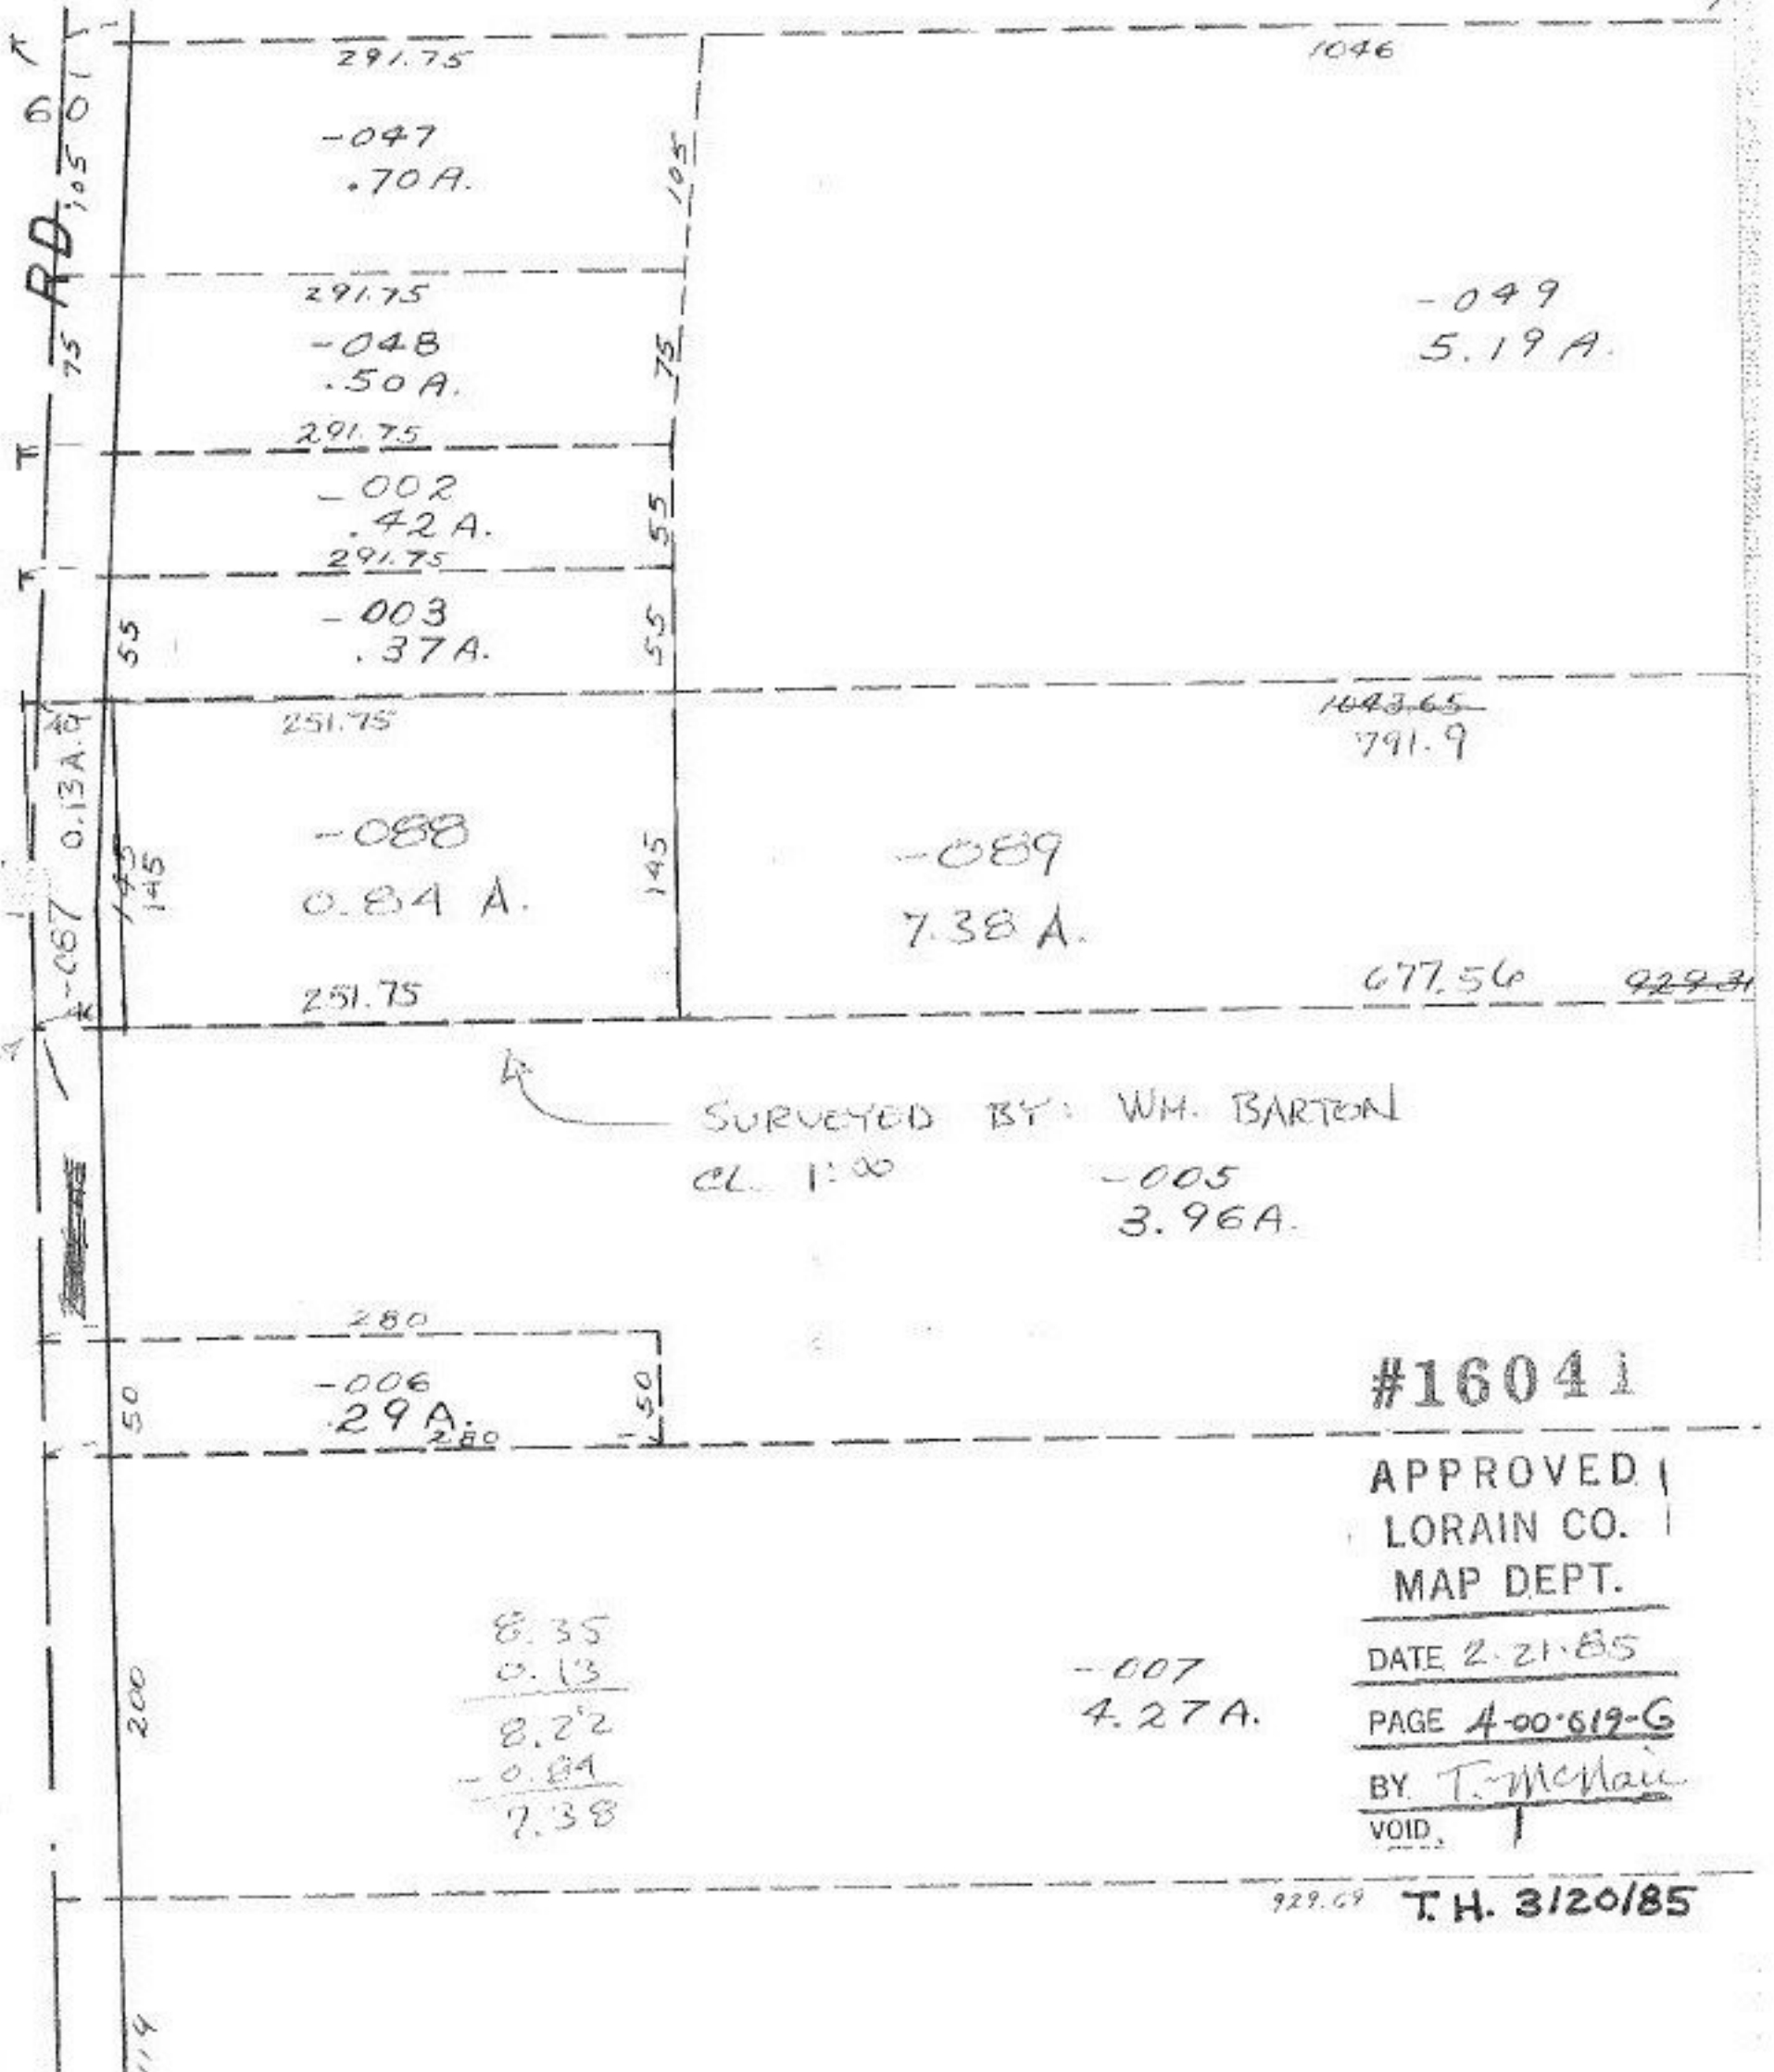

291.75
-047
.70 A.

291.75
-048
.50 A.

291.75
-002
.42 A.

291.75
-003
.37 A.

251.75
-088
0.84 A.
251.75

280
-006
2.9 A.
280

8.35
 0.13

 8.22
 - 0.84

 7.38

1046

-049
5.19 A.

1043.65
791.9

-089
7.38 A.

677.56 929.31

SURVEYED BY: WM. BARTON
CL. 1:00

-005
3.96 A.

#16041

APPROVED
LORAIN CO.
MAP DEPT.

DATE 2-21-85

PAGE 4-00-619-G

BY T. McNamee
VOID

-007
4.27 A.

929.69 T.H. 3/20/85

RD 105 0 1 1

0.067 0.13 A. 145

55

105

75

55

55

145

50

50

200

114