


399.85

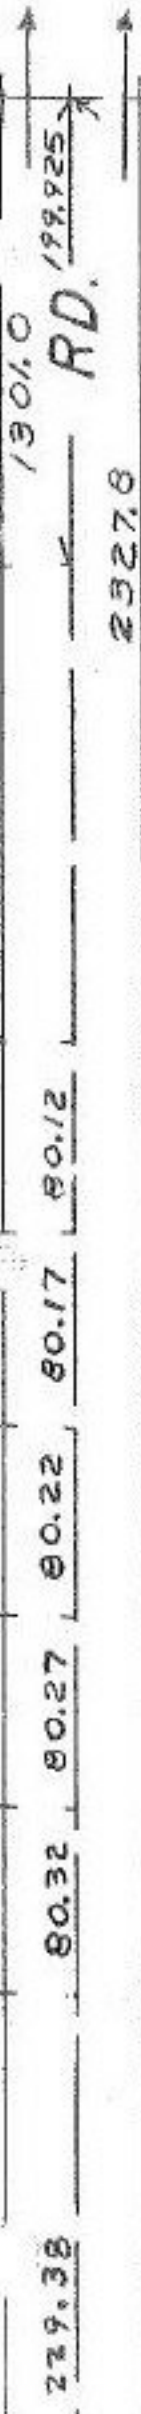

~~032~~
~~29.49 A.~~

Pt. - 078
 Pt. 29.36 A.

102

#16057
 APPROVED
 LORAIN CO.
 MAP DEPT.

DATE 3.1.85
 PAGE 4.00.017. A
 BY T. McMain
 VOID
 'EFF'
 T.H. 4/30/85
 2322.52
 2321.6