


PYLE SOUTH AMHERST

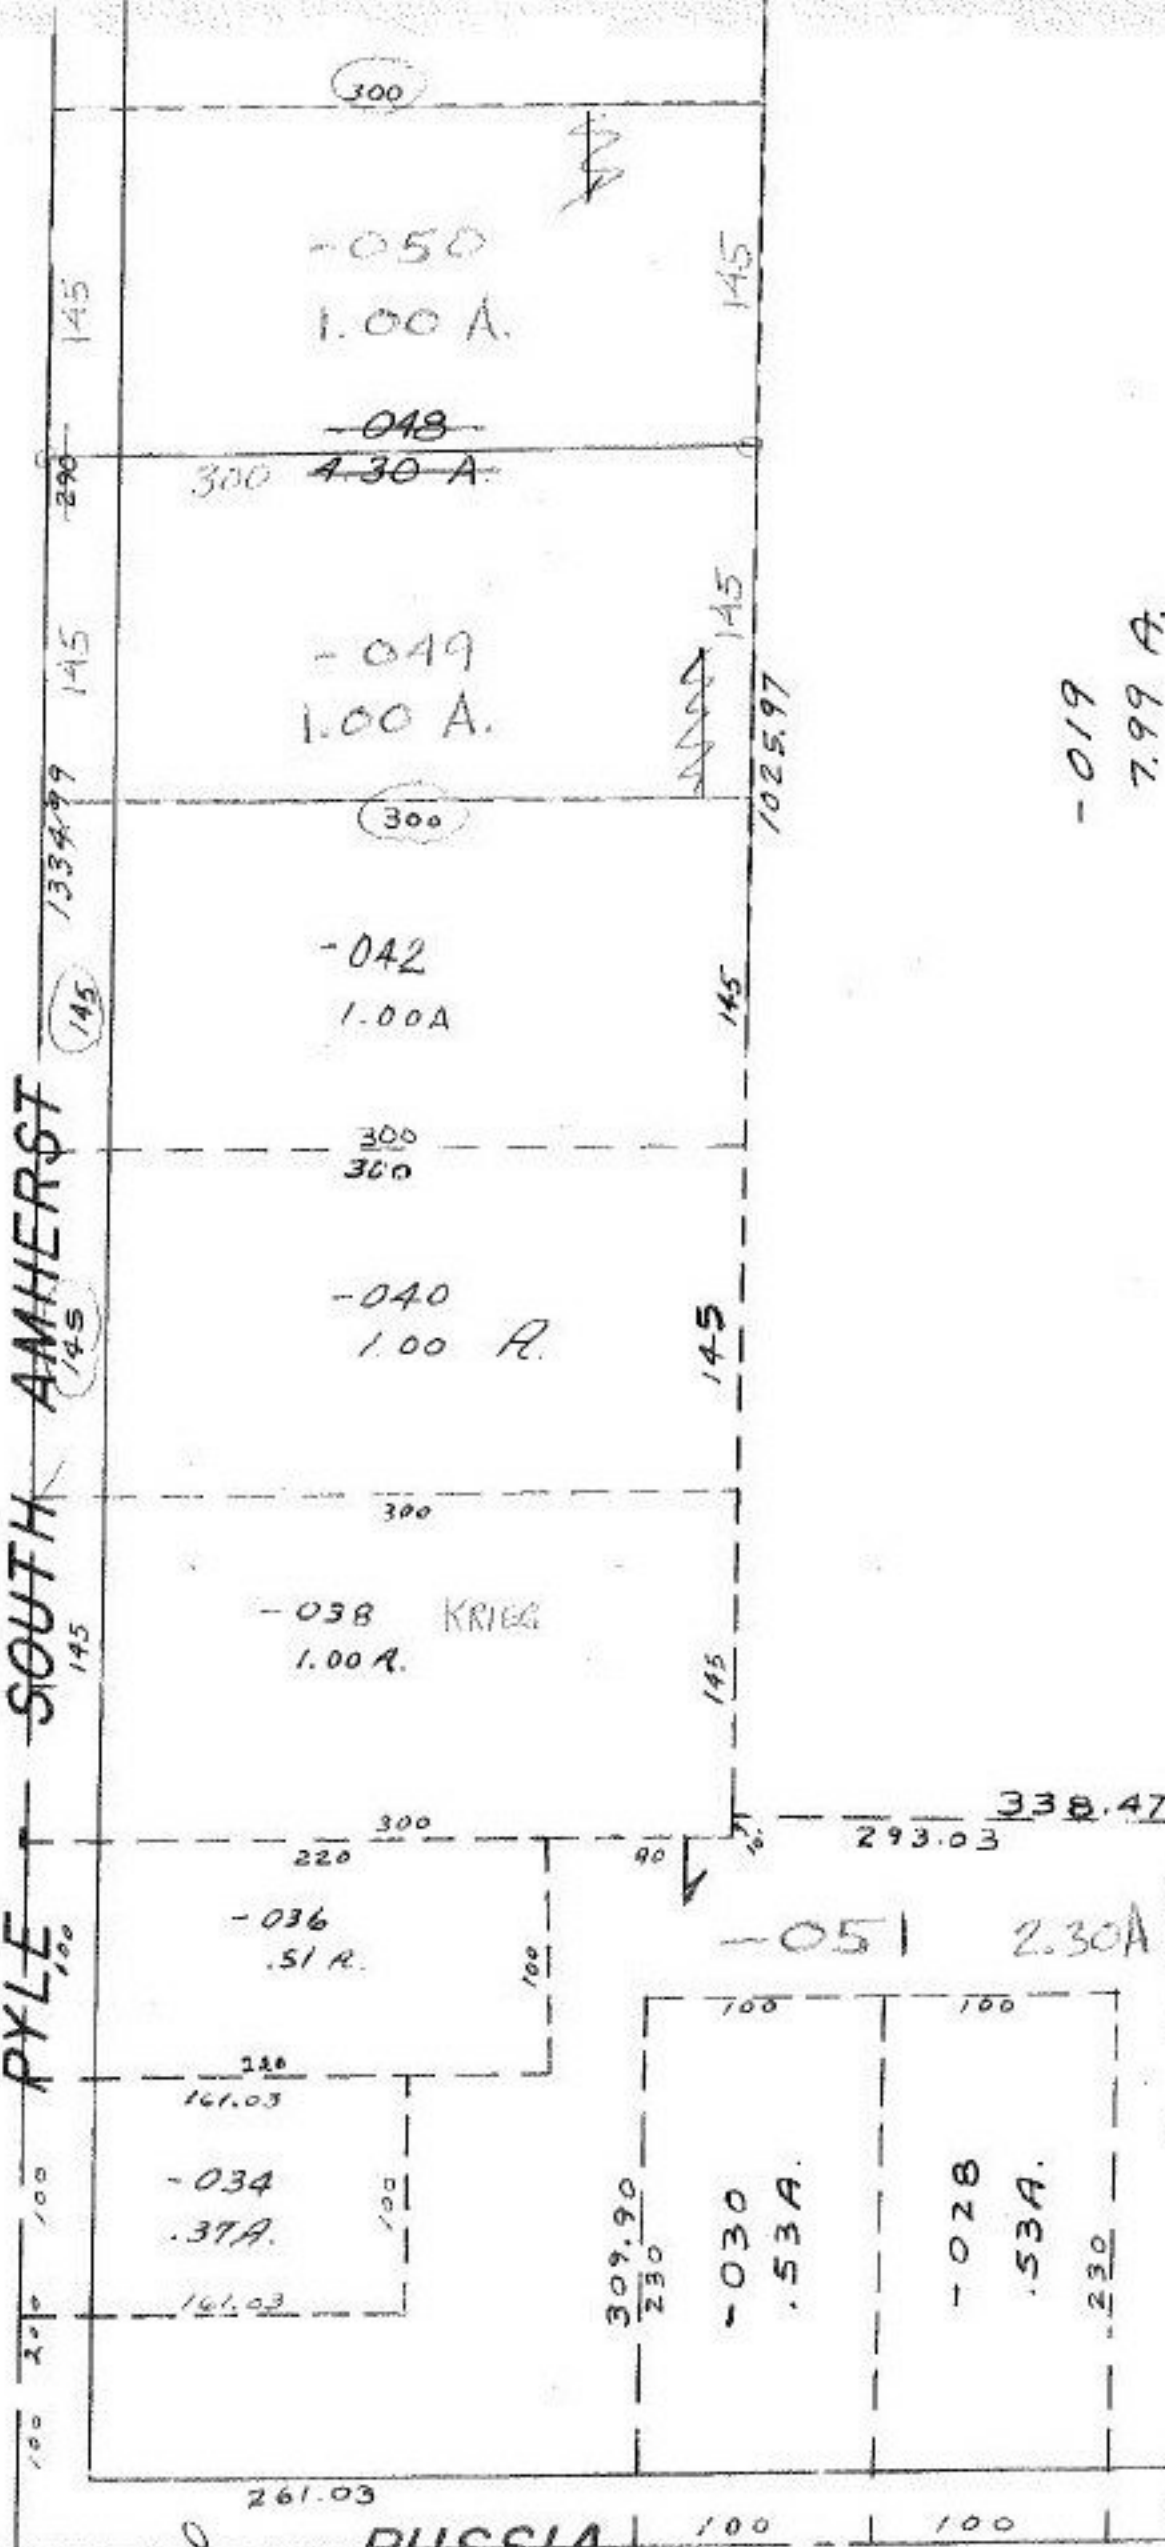

-019
7.99 A.

#16078
APPROVED
LORAIN CO.
MAP DEPT.

DATE 3.12.85

PAGE 900-013-B

BY T. McManis

VOID
RENDER

4.9
300

-020
.58 A.
297.34

1334.14

RUSSIA