


S

101

RD.

60

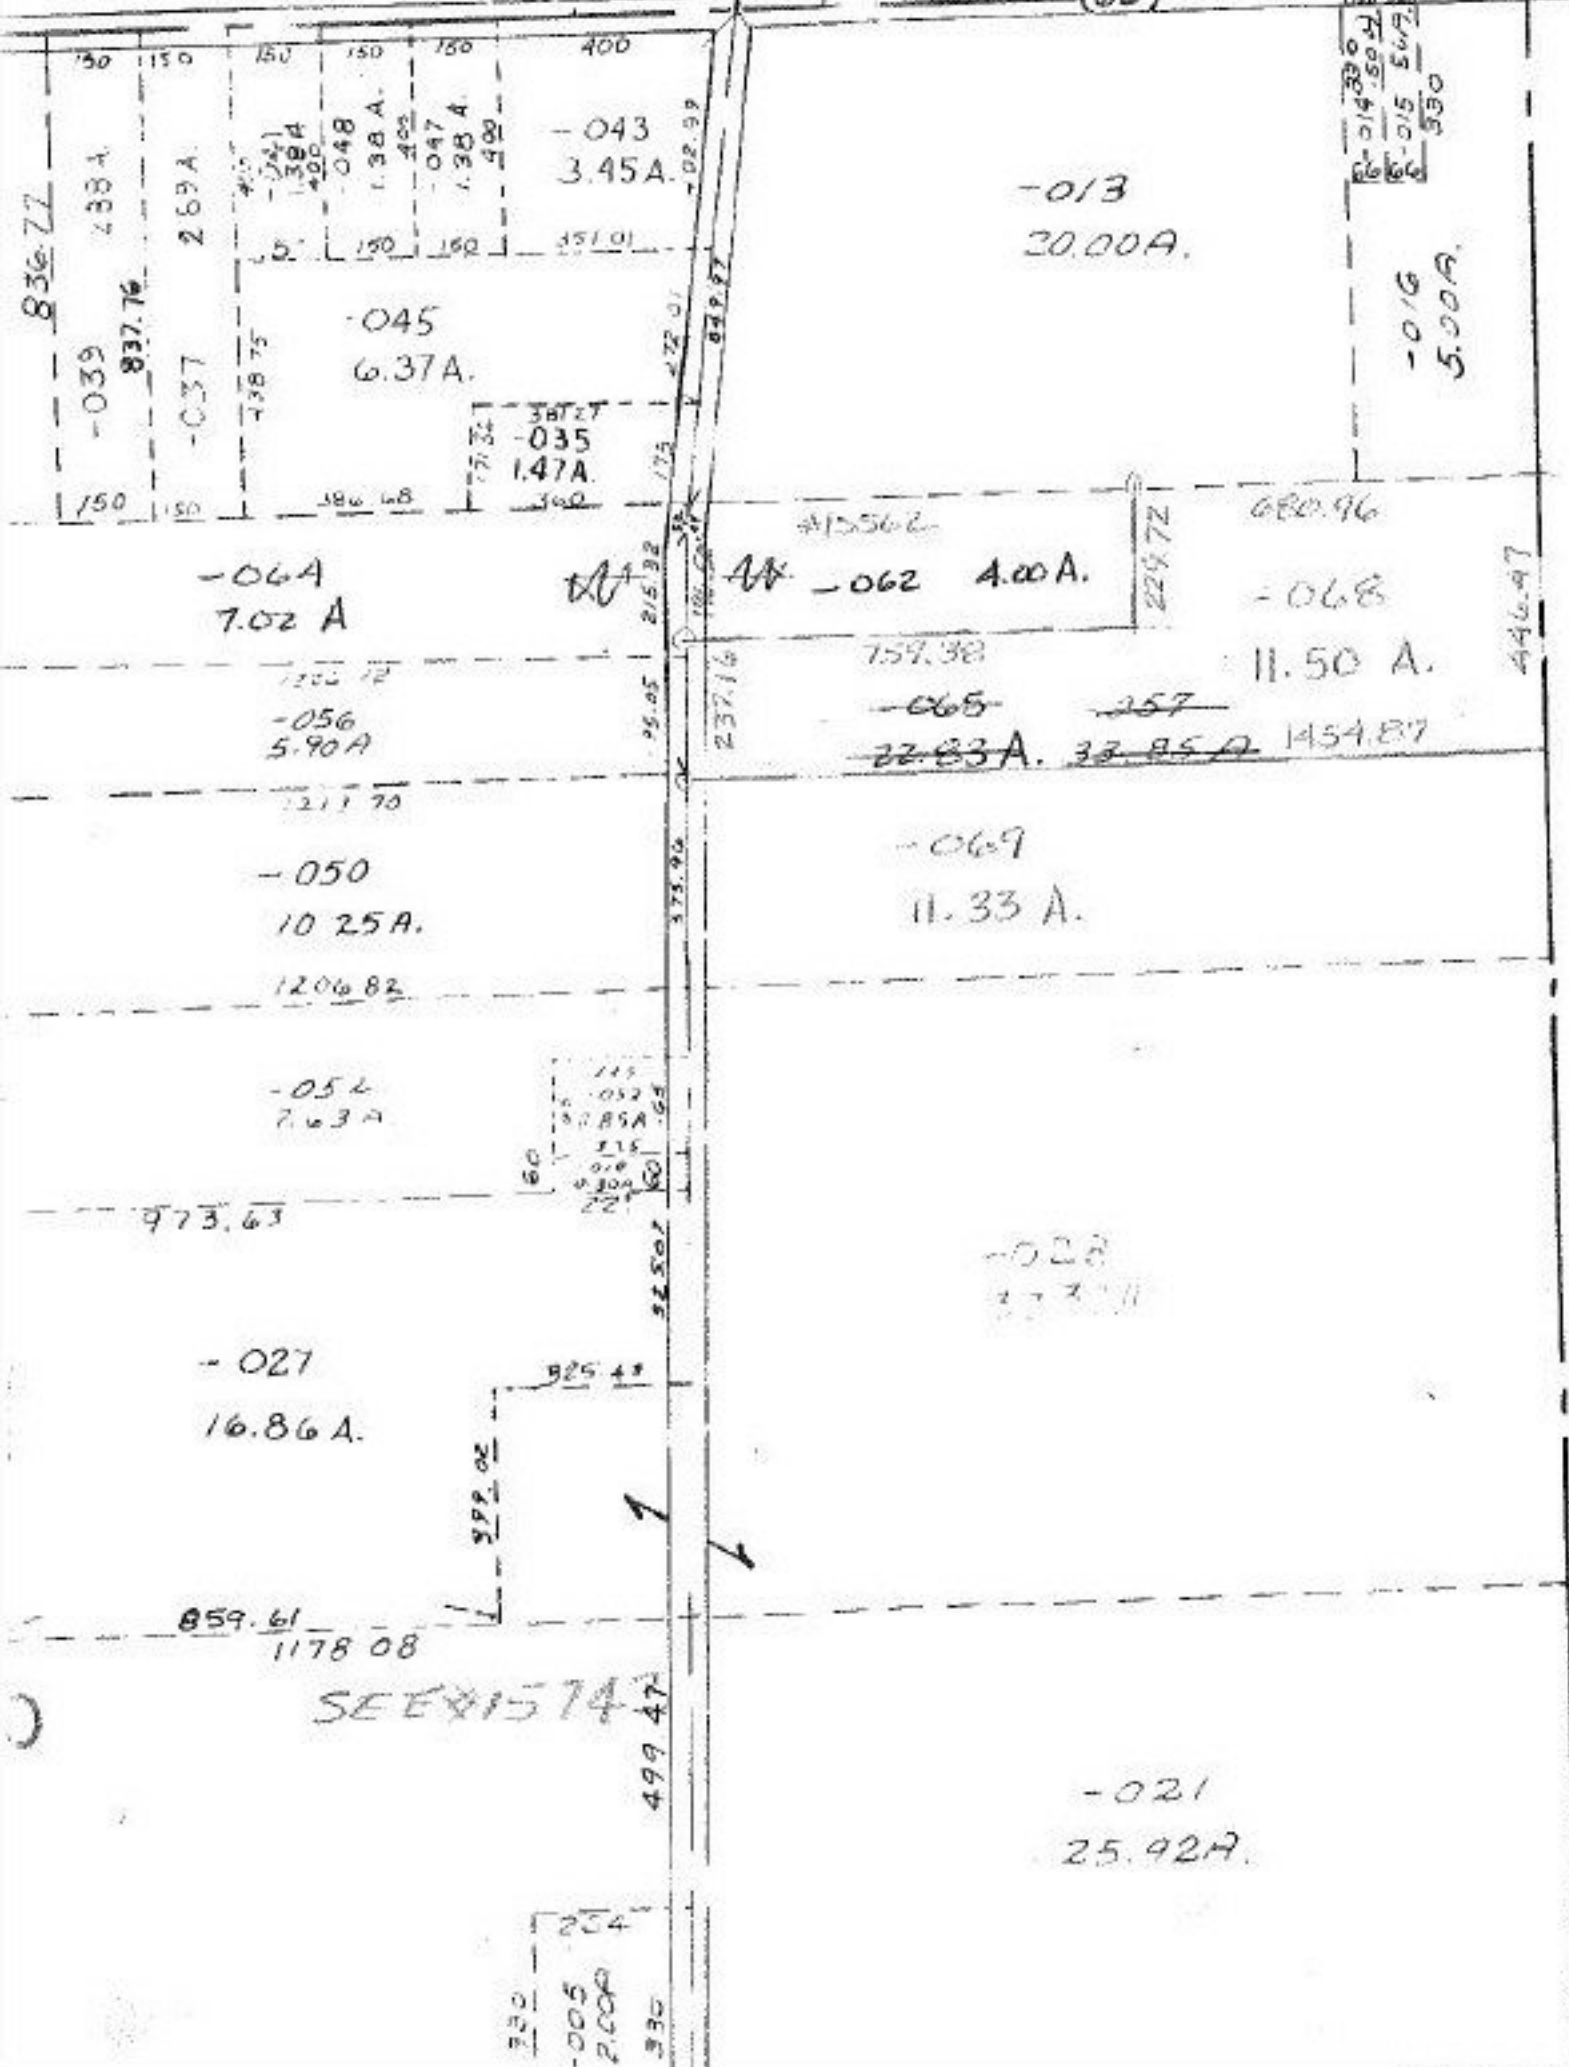

SEE
 SURVEY MAP
 REINOLDO R. SCHMIDT
 1:1000, 000

#16090
 APPROVED
 LORAIN CO.
 MAP DEPT.
 DATE 3-28-85
 PAGE 10-A
 BY T. McHain
 VOID
 9-24-85