


ES-28-8706

010
4490



Route 20

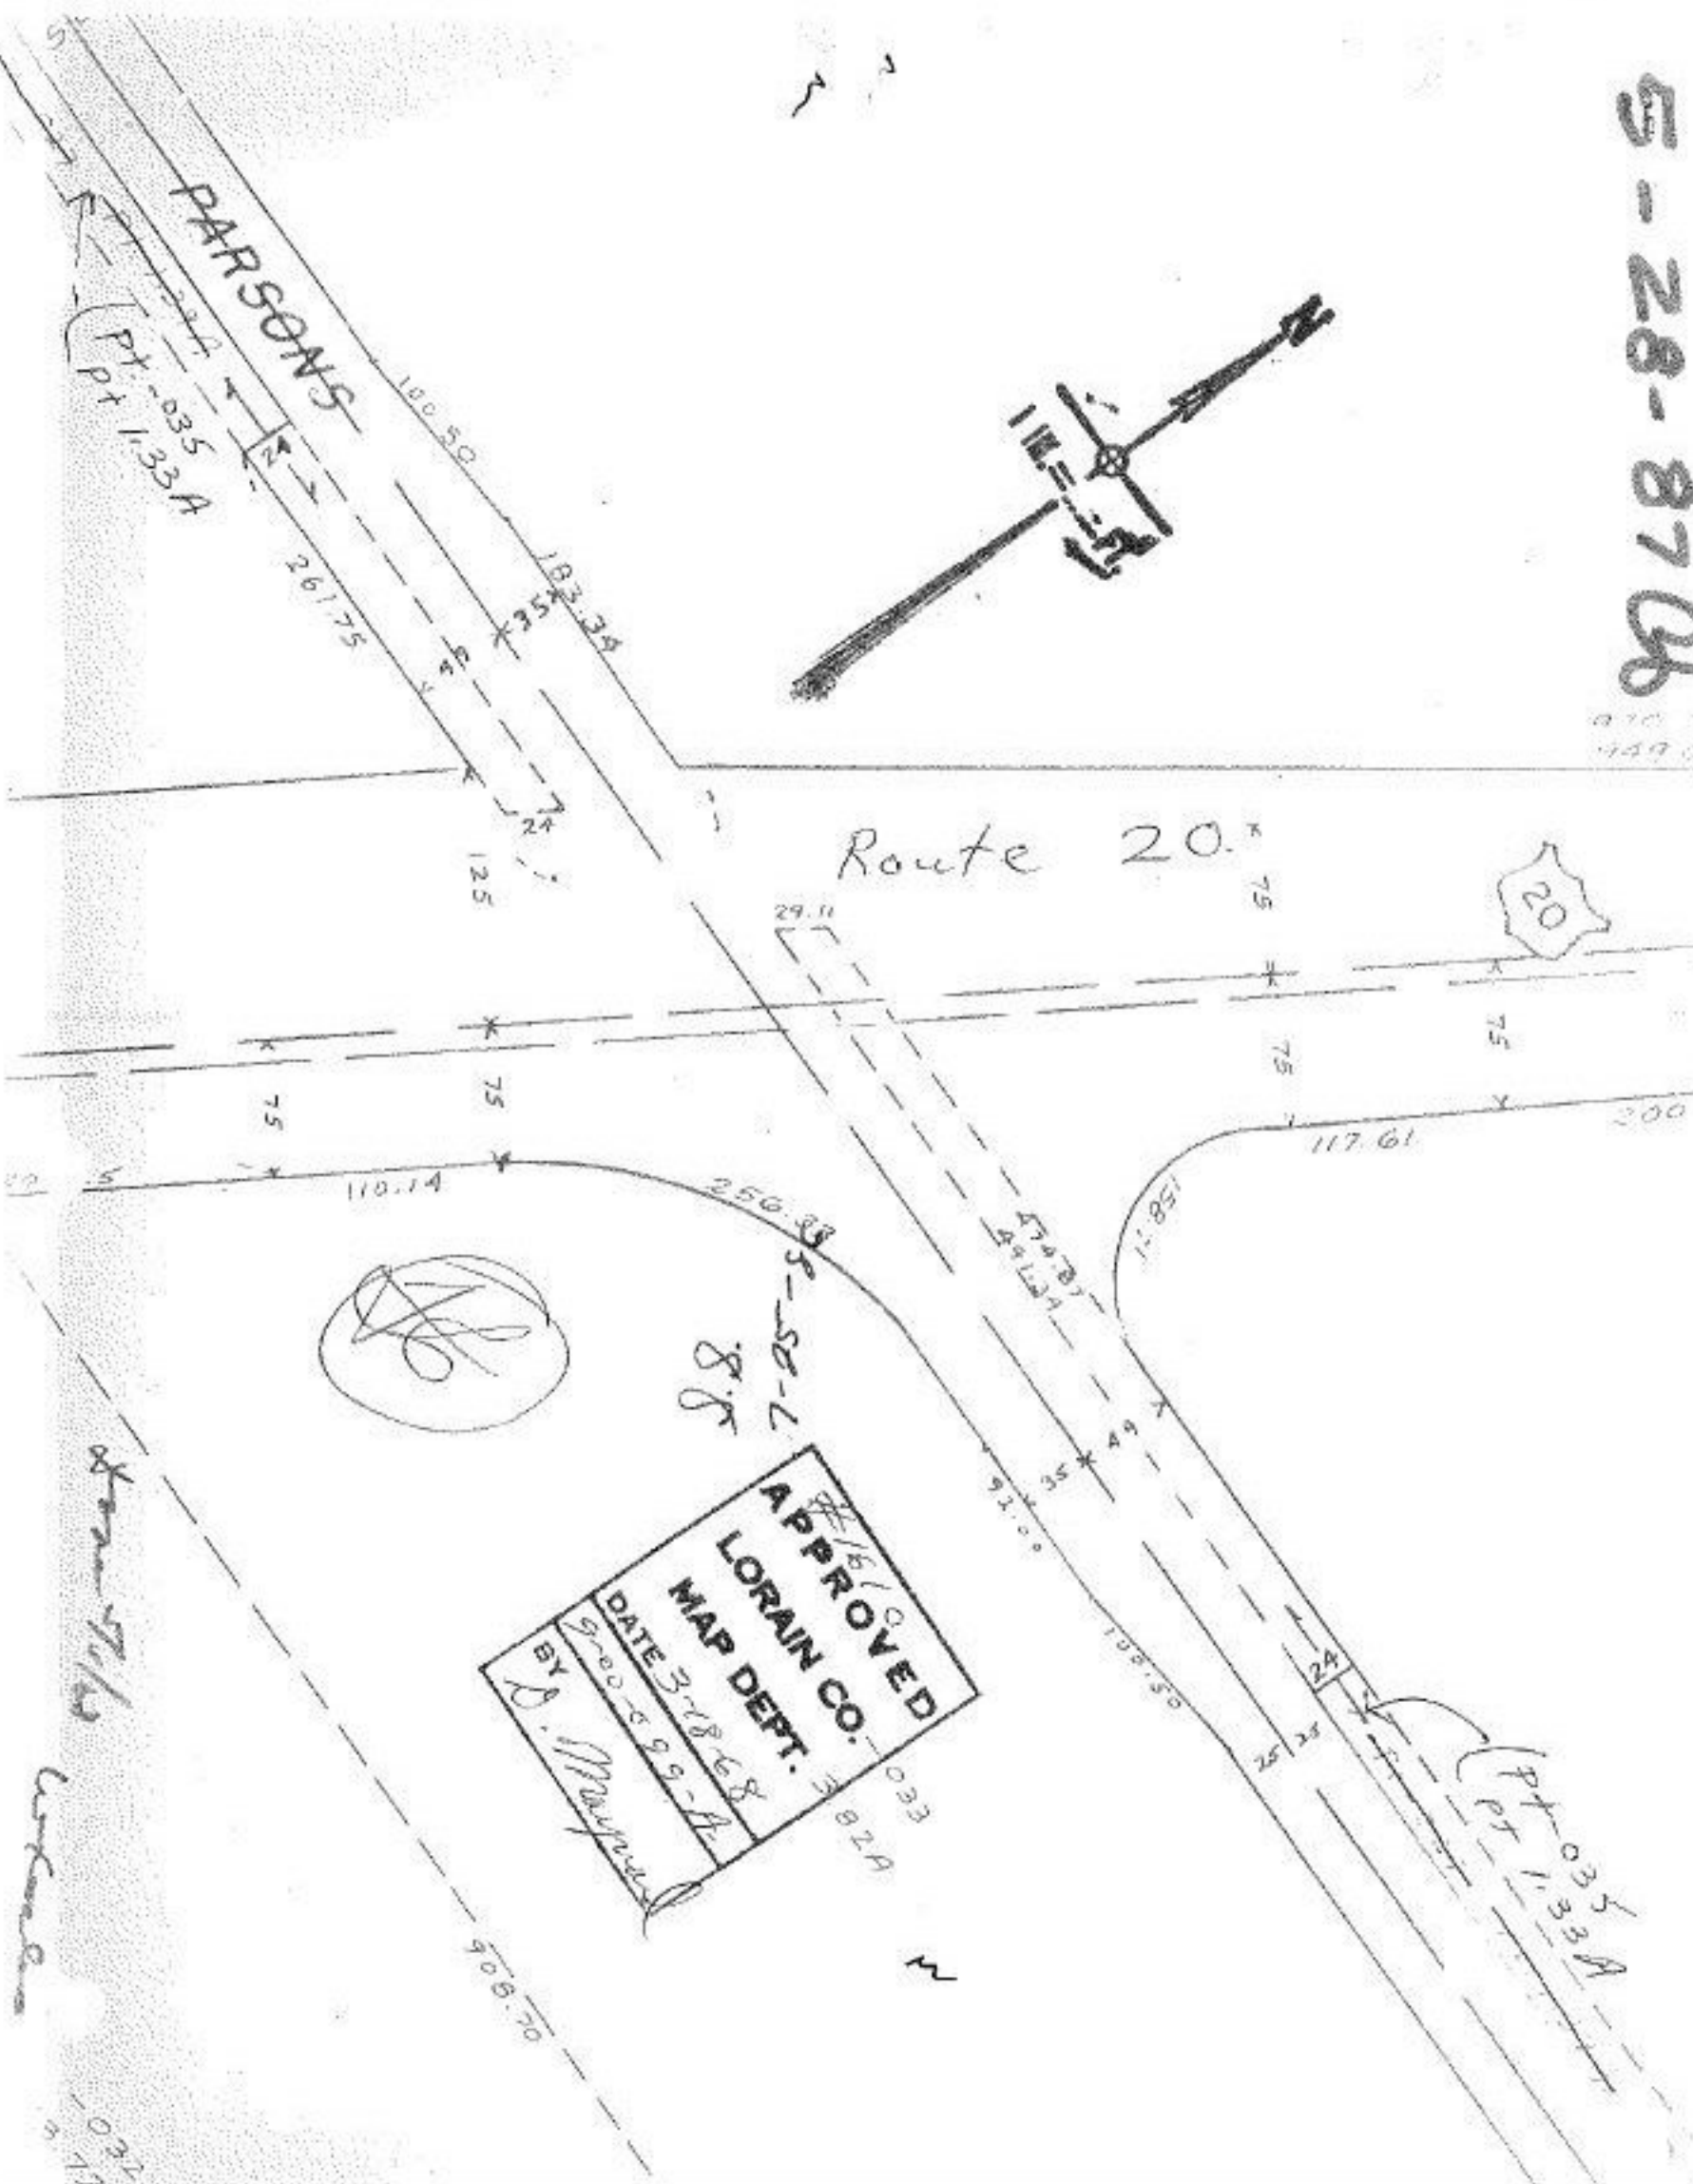

APPROVED
 LORAIN CO.
 MAP DEPT.
 DATE 3-18-68
 BY *[Signature]*



Done 7/6

Curran

11.0
0.37