


ESTNUT RIDGE

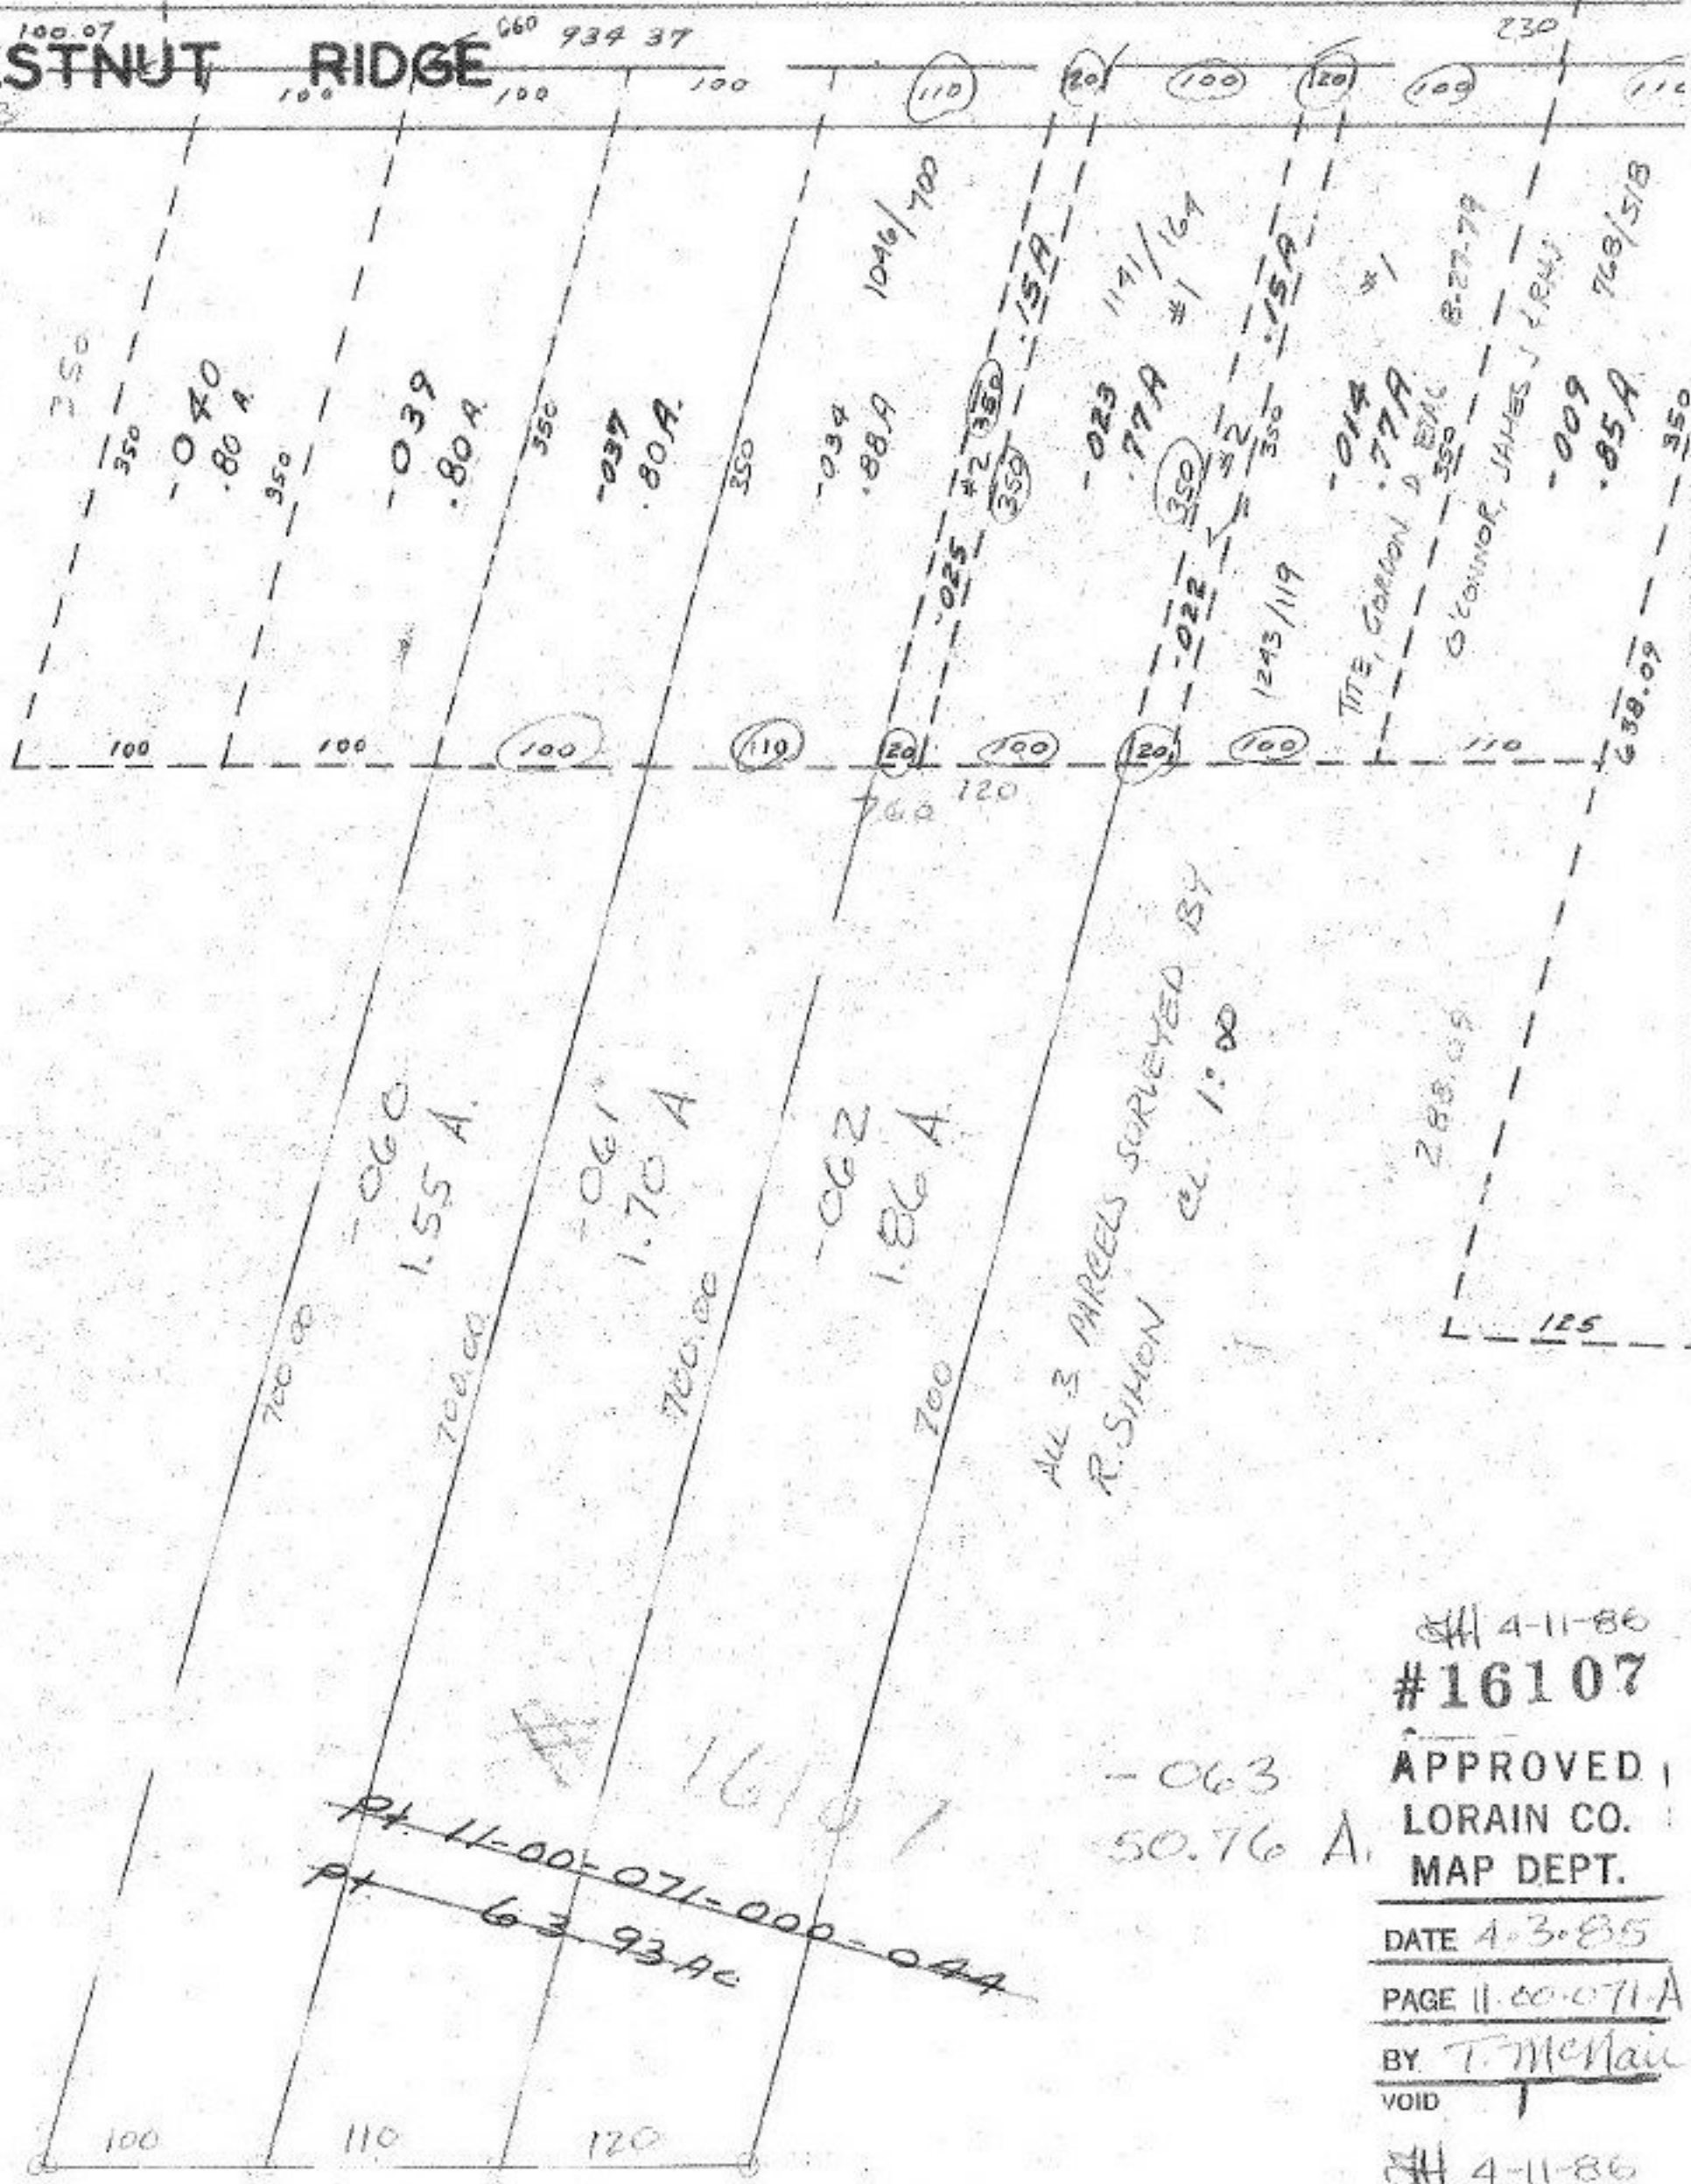

ALL 3 PARCELS SURVEYED BY
R. SIMON
CL. 1:00

4-11-86
#16107
APPROVED
LORAIN CO.
MAP DEPT.

DATE 4-3-85
PAGE 11-00-071-A
BY T. McNeil
VOID

4-11-86