


#1611  
**APPROVED**  
**LORAIN CO.**  
**MAP DEPT.**  
 DATE 3-18-68  
 L-K  
 BY *D. Maguire*

5-29-87  
 1611  
 1000-013  
 1007-66  
 971.52  
 200 7.100  
 118.04  
 207.85  
 365.20  
 155 + 175

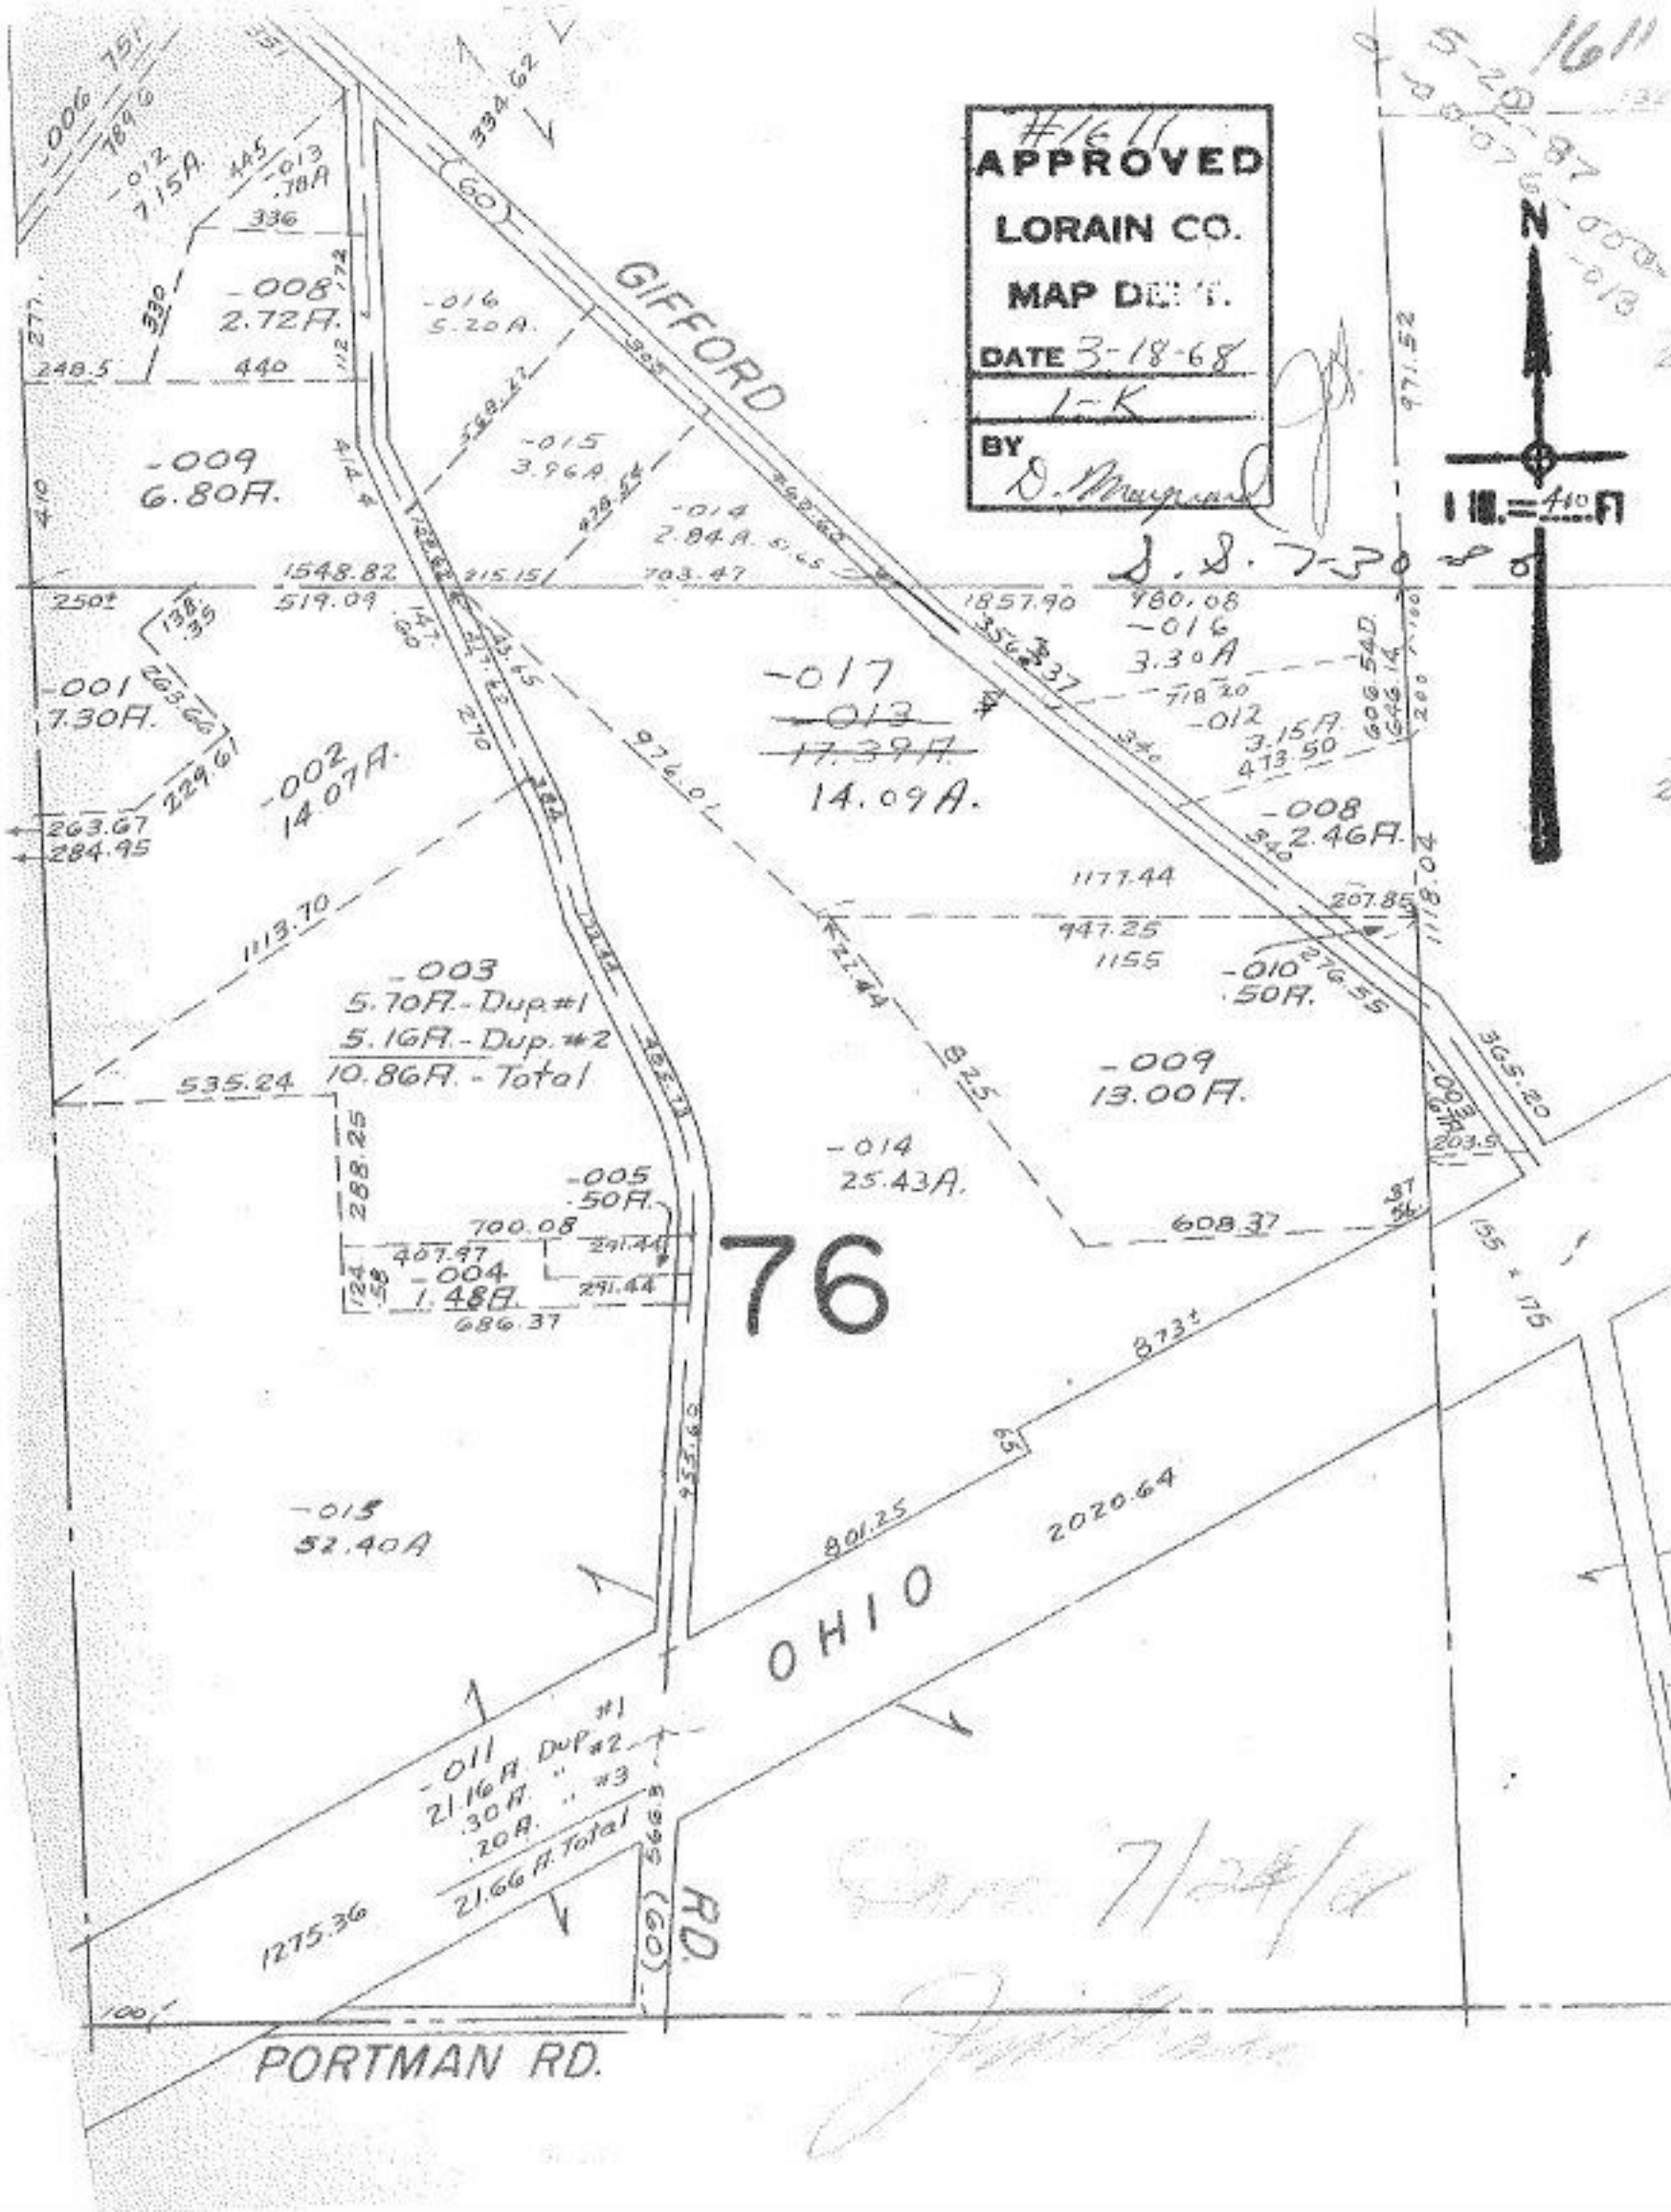

76

*7/24/68*  
*[Signature]*