


00-004-A

SEE MAP BY
A. KOEPP EC 1.10

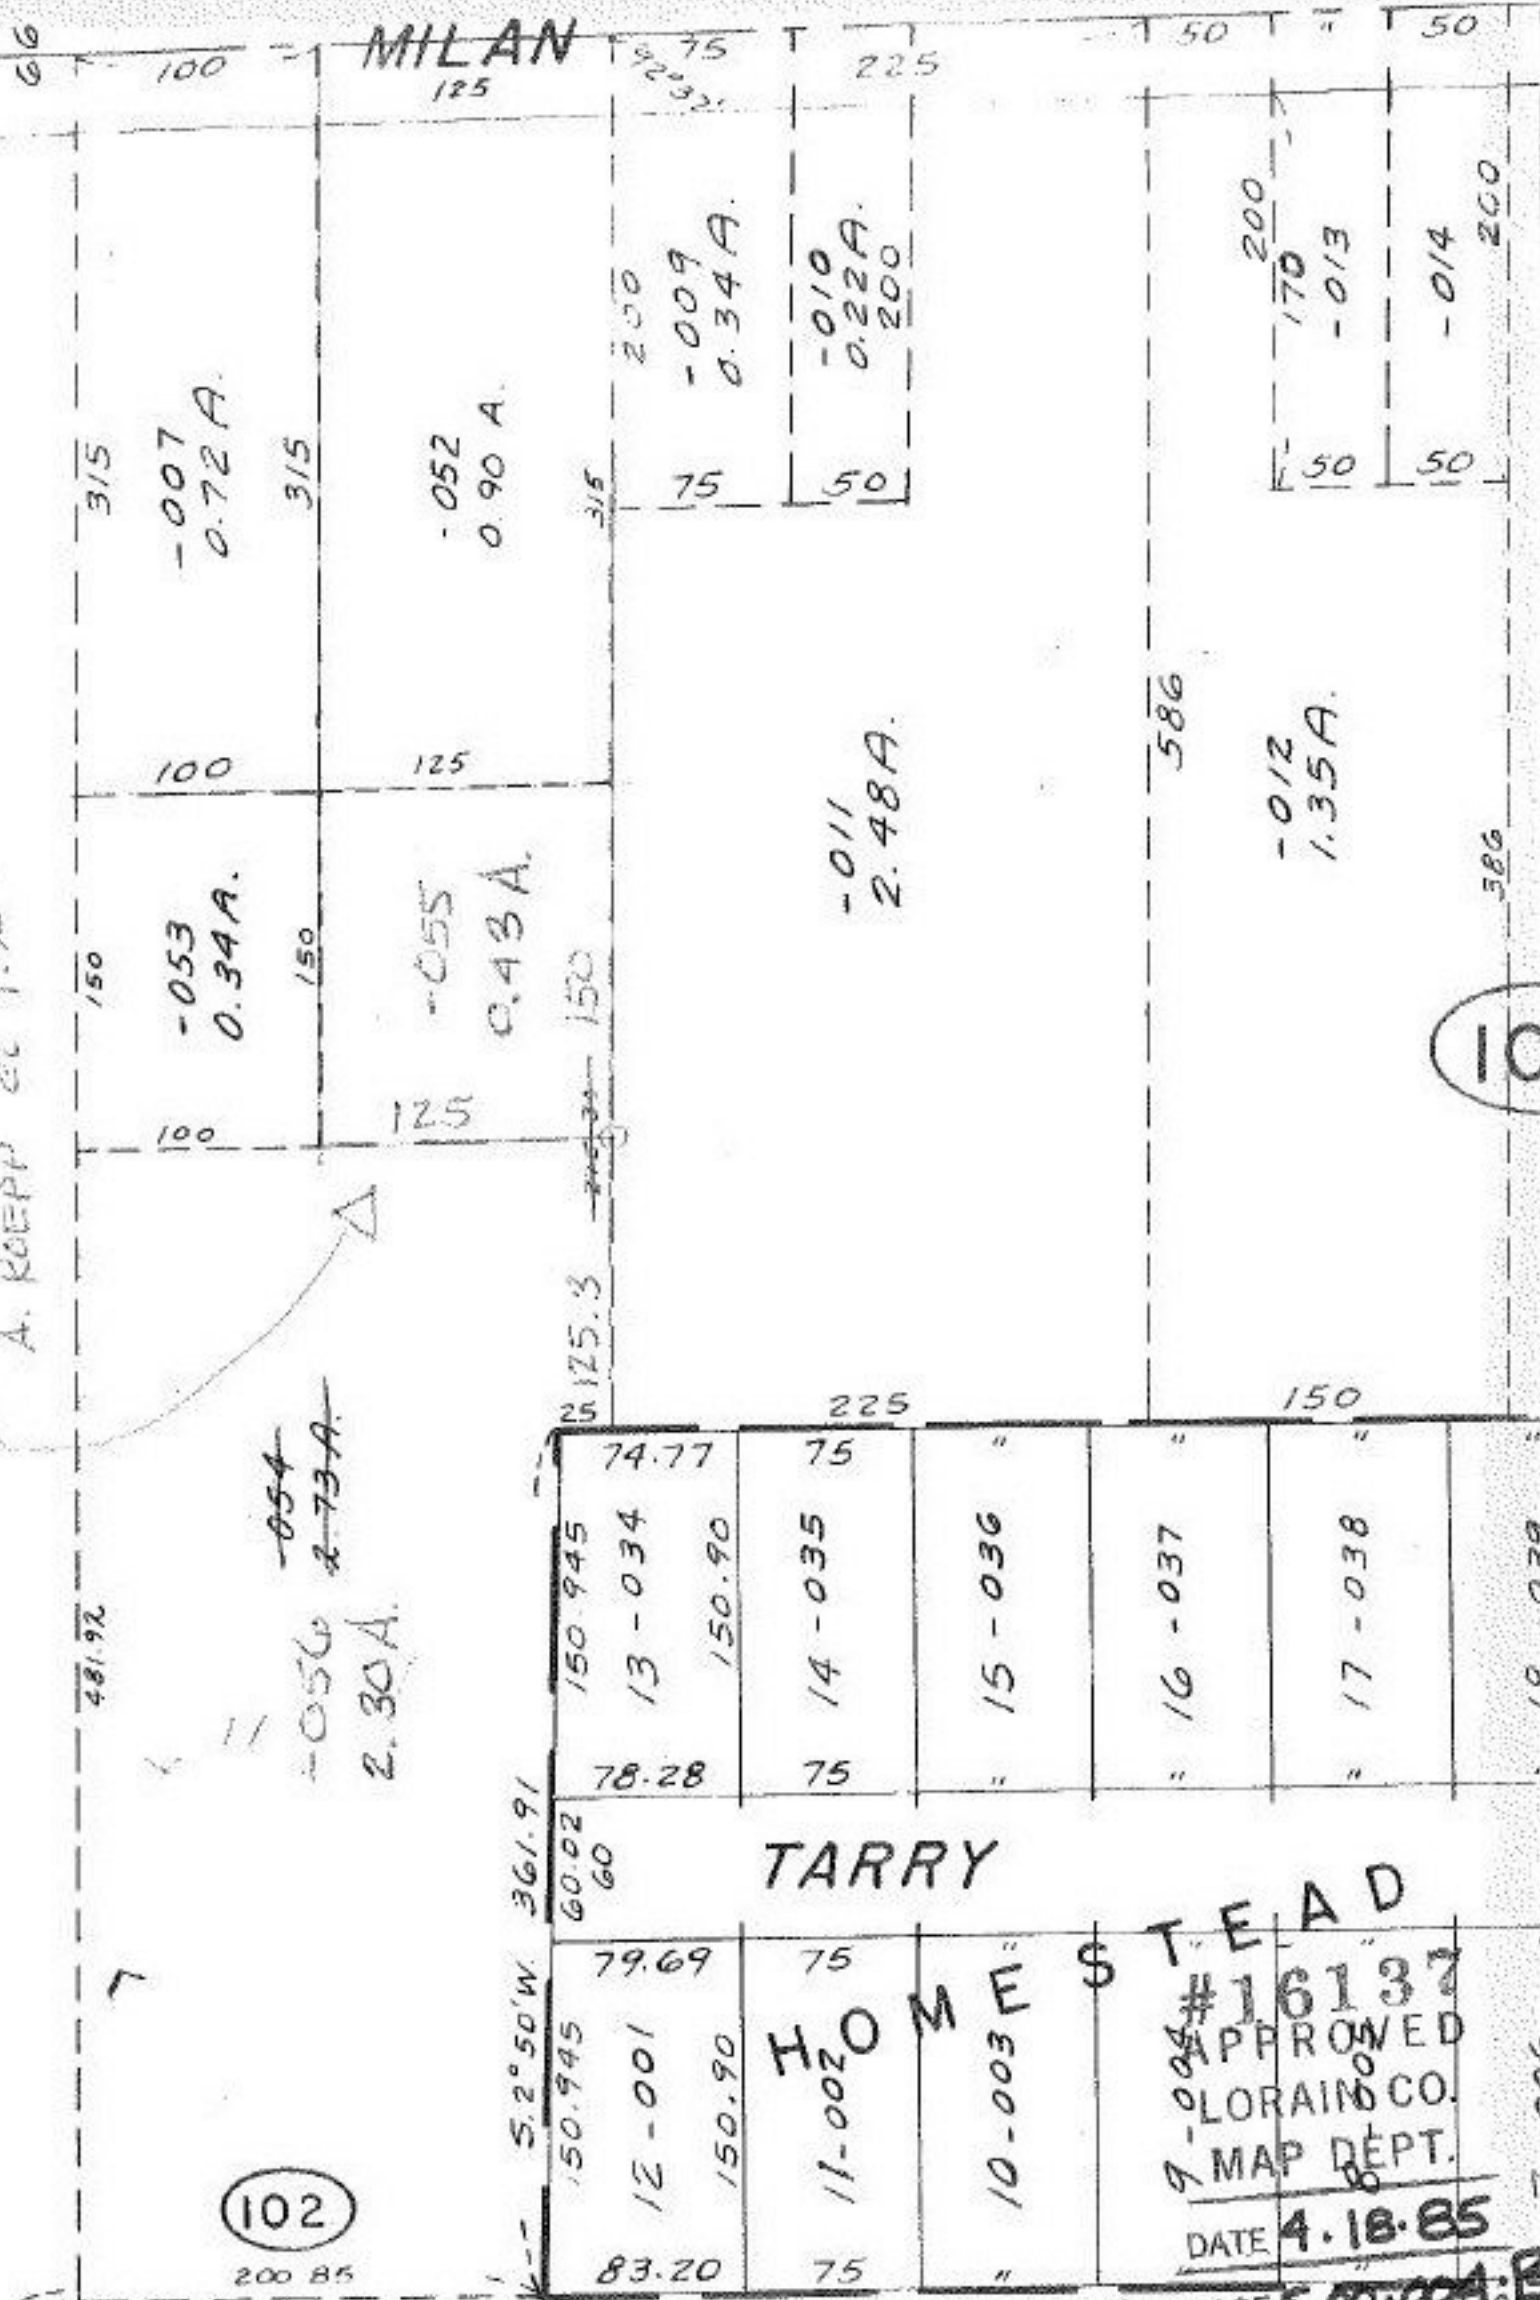

(102)
200 85

(103)

79.69	74.77	75	75	75	75
150.945	150.945	13-034	14-035	15-036	16-037
150.90	150.90	150.90	150.90	150.90	150.90
12-001	11-002	10-003	HOMESTEAD		
83.20	75	75	75	75	75

APPROVED
LORAIN CO.
MAP DEPT.
DATE 4.18.85

BY T. McVain
VOID J. Minwell
3-31-86

(10)