

SEE 7-00-005-A

Should be
Drawn from
695 Side line

20

CENTER RIDGE
306
45

283.30

467.67

95.31

Pt - 041
Pt 40.05 A

467.45

BY <i>D. Murray</i>
7-00-006-C
DATE 3-19-68
MAP DEPT.
LORAIN CO.
APPROVED
#1614
7-15-86 RMS

1259.37

236.51
236.51

12.93 A
-040

~~Pt-001~~
~~Pt-52.987~~

SEE 7-

159.28


108.35

101

177.85

262.61

139.29

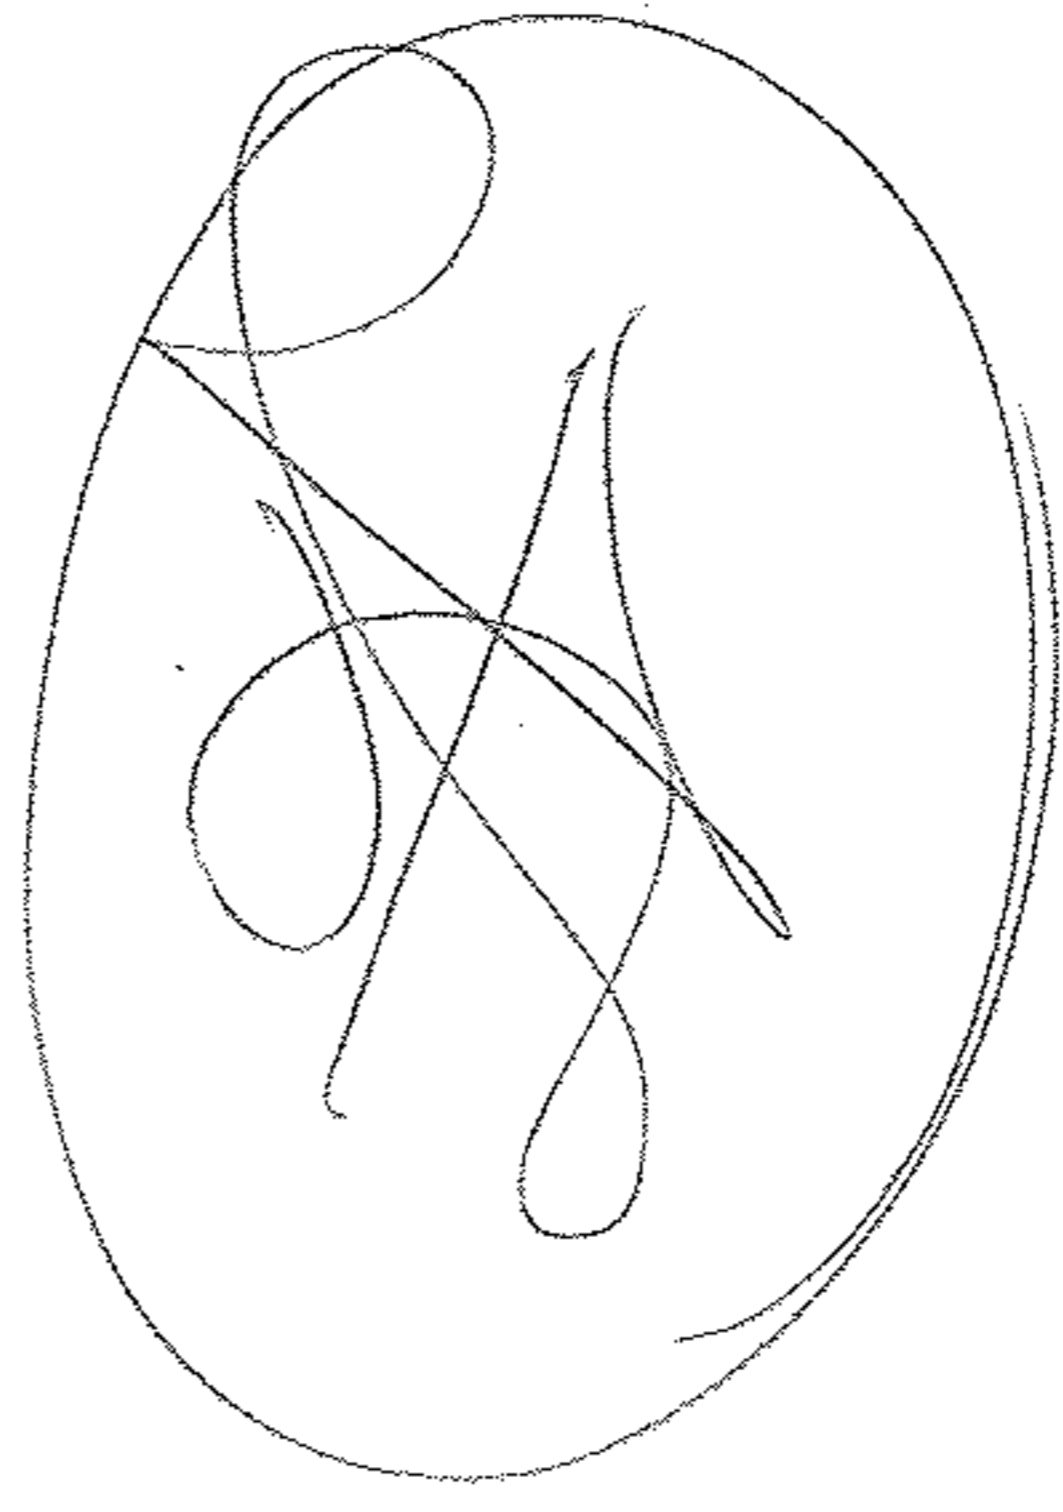

SEE 7-00-006-A

Pt-002