




COMBINATION

081-A



SEE

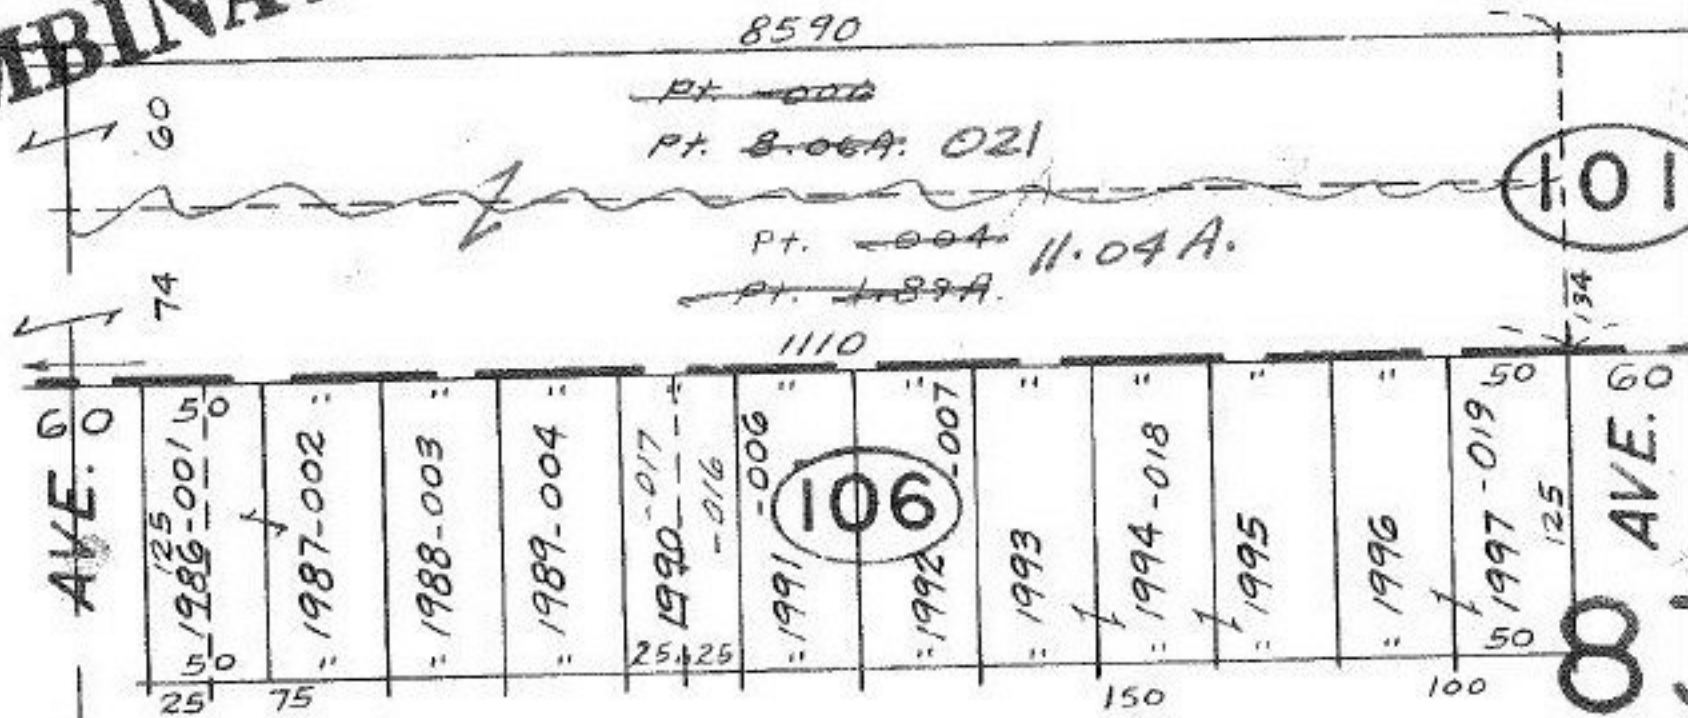

80 28th

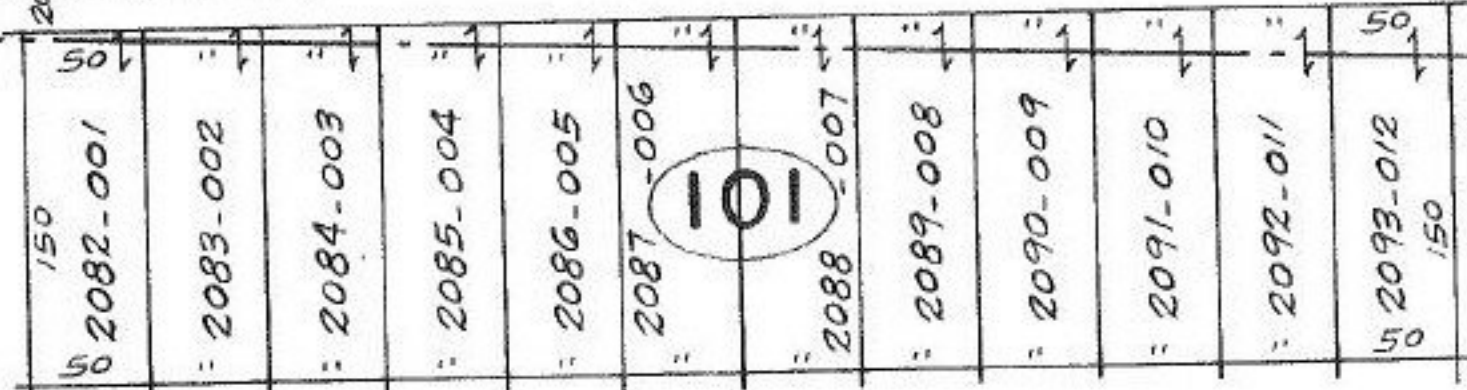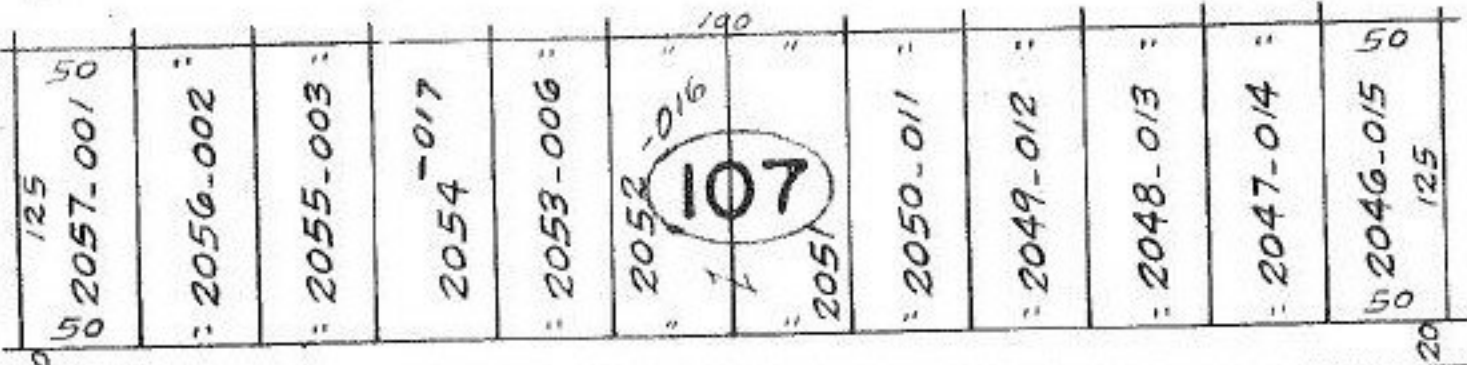

80 29th

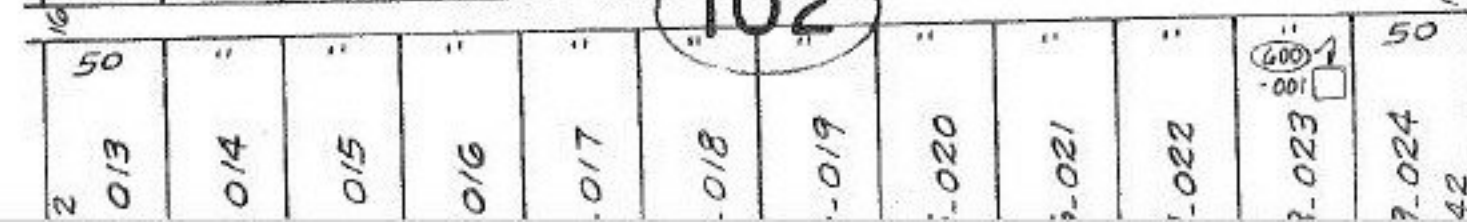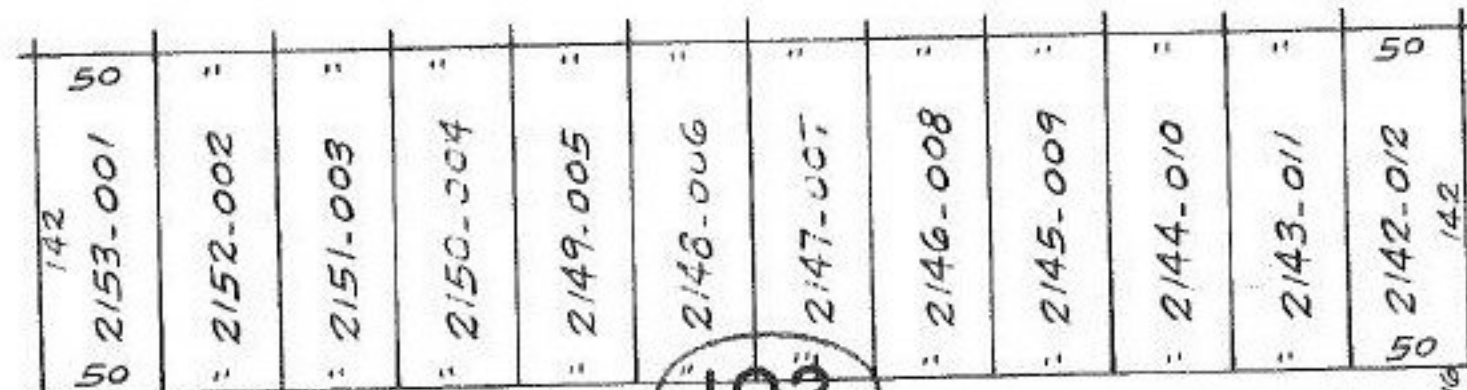

T.M.
 7.31.85

#16153

| | |
|---------------|----------------|
| APPROVED | |
| LORAIN CO. | |
| MAP DEPT. | |
| DATE 5-6-85 | |
| AGE 3-00-081A | |
| BY | <i>Ralbert</i> |
| VOID AFTER | 16153 |