


094-B

SEE 3-F

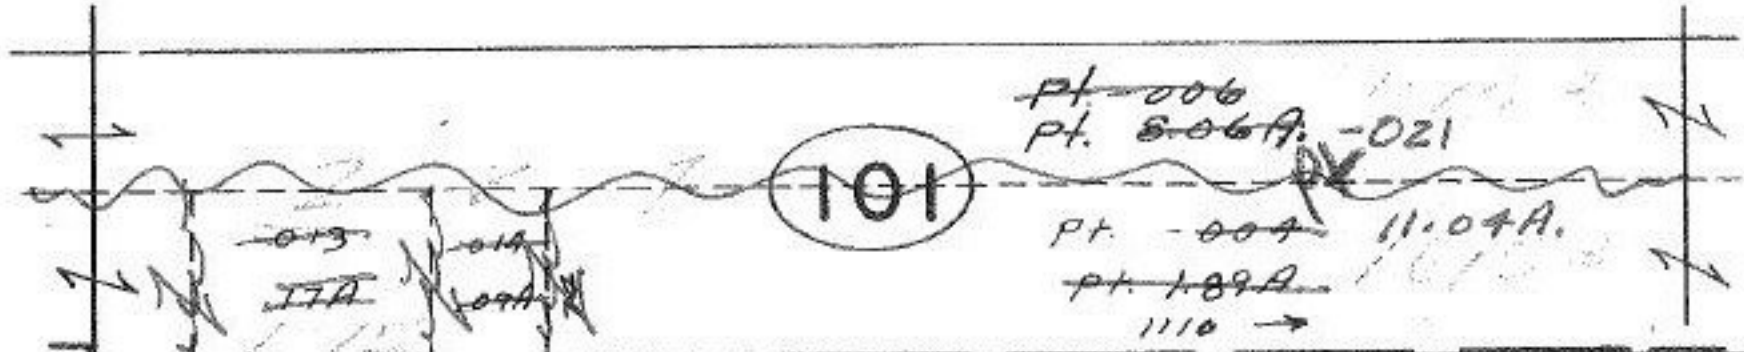

40	125 1974-001 50	" 1975-002 "	" 1976-003 "	" 1977-004 "	" 1978-005 "	1979 83 104 1980-007	" 1981-008 "	" 1982-009 "	" 1983-010 "	" 1984-011 "	50 125 1985-012 30
----	-----------------------	--------------------	--------------------	--------------------	--------------------	-------------------------------	--------------------	--------------------	--------------------	--------------------	-----------------------------

AVS.

AVE.

80 28th

COMBINATION

.59 24	100.41 125 2069-001 50	100.11 -003 2068-002	49.89 2067-013	2066-004	2065-005	2064 105 2063-006 2063-007	2062-008	2061-009	4 2060-010	2059-011	2058-012 125
-----------	---------------------------------	----------------------------	-------------------	----------	----------	-------------------------------------	----------	----------	---------------	----------	-----------------

T.M.
7.31.85

16153

20	135 40 2070-001 40	40 2071-002 40	70 2072-003 70	135 15 50 2073-004	" 2074-005 "	" 2075-006 108 2076-007	" 2077-008 "	" 2078N-009 O "	" 2079-010 "	" 2080-011 "
----	-----------------------------	----------------------	----------------------	-----------------------------	--------------------	----------------------------------	--------------------	--------------------------	--------------------	--------------------

80 29th

ST.

15	135 70 2163-001 70	40 2164-002 40	" 2165-003 "	60.06 2166-004	142 15 50 2162-007	" 2161-008 "	" 2160-009 "	" 2159-010 "	" 2158-011 "	" 2157-012 "	" 2156-013 "	" 2155-014 "	50 142 2154-015 16
----	-----------------------------	----------------------	--------------------	-------------------	-----------------------------	--------------------	--------------------	--------------------	--------------------	--------------------	--------------------	--------------------	-----------------------------

APPROVED	
LORAIN CO.	
MAP DEPT.	
DATE	5-6-85
PAGE	3-00-094B
BY	[Signature]
VOID AFTER	16153