


COMBINATION

096-B

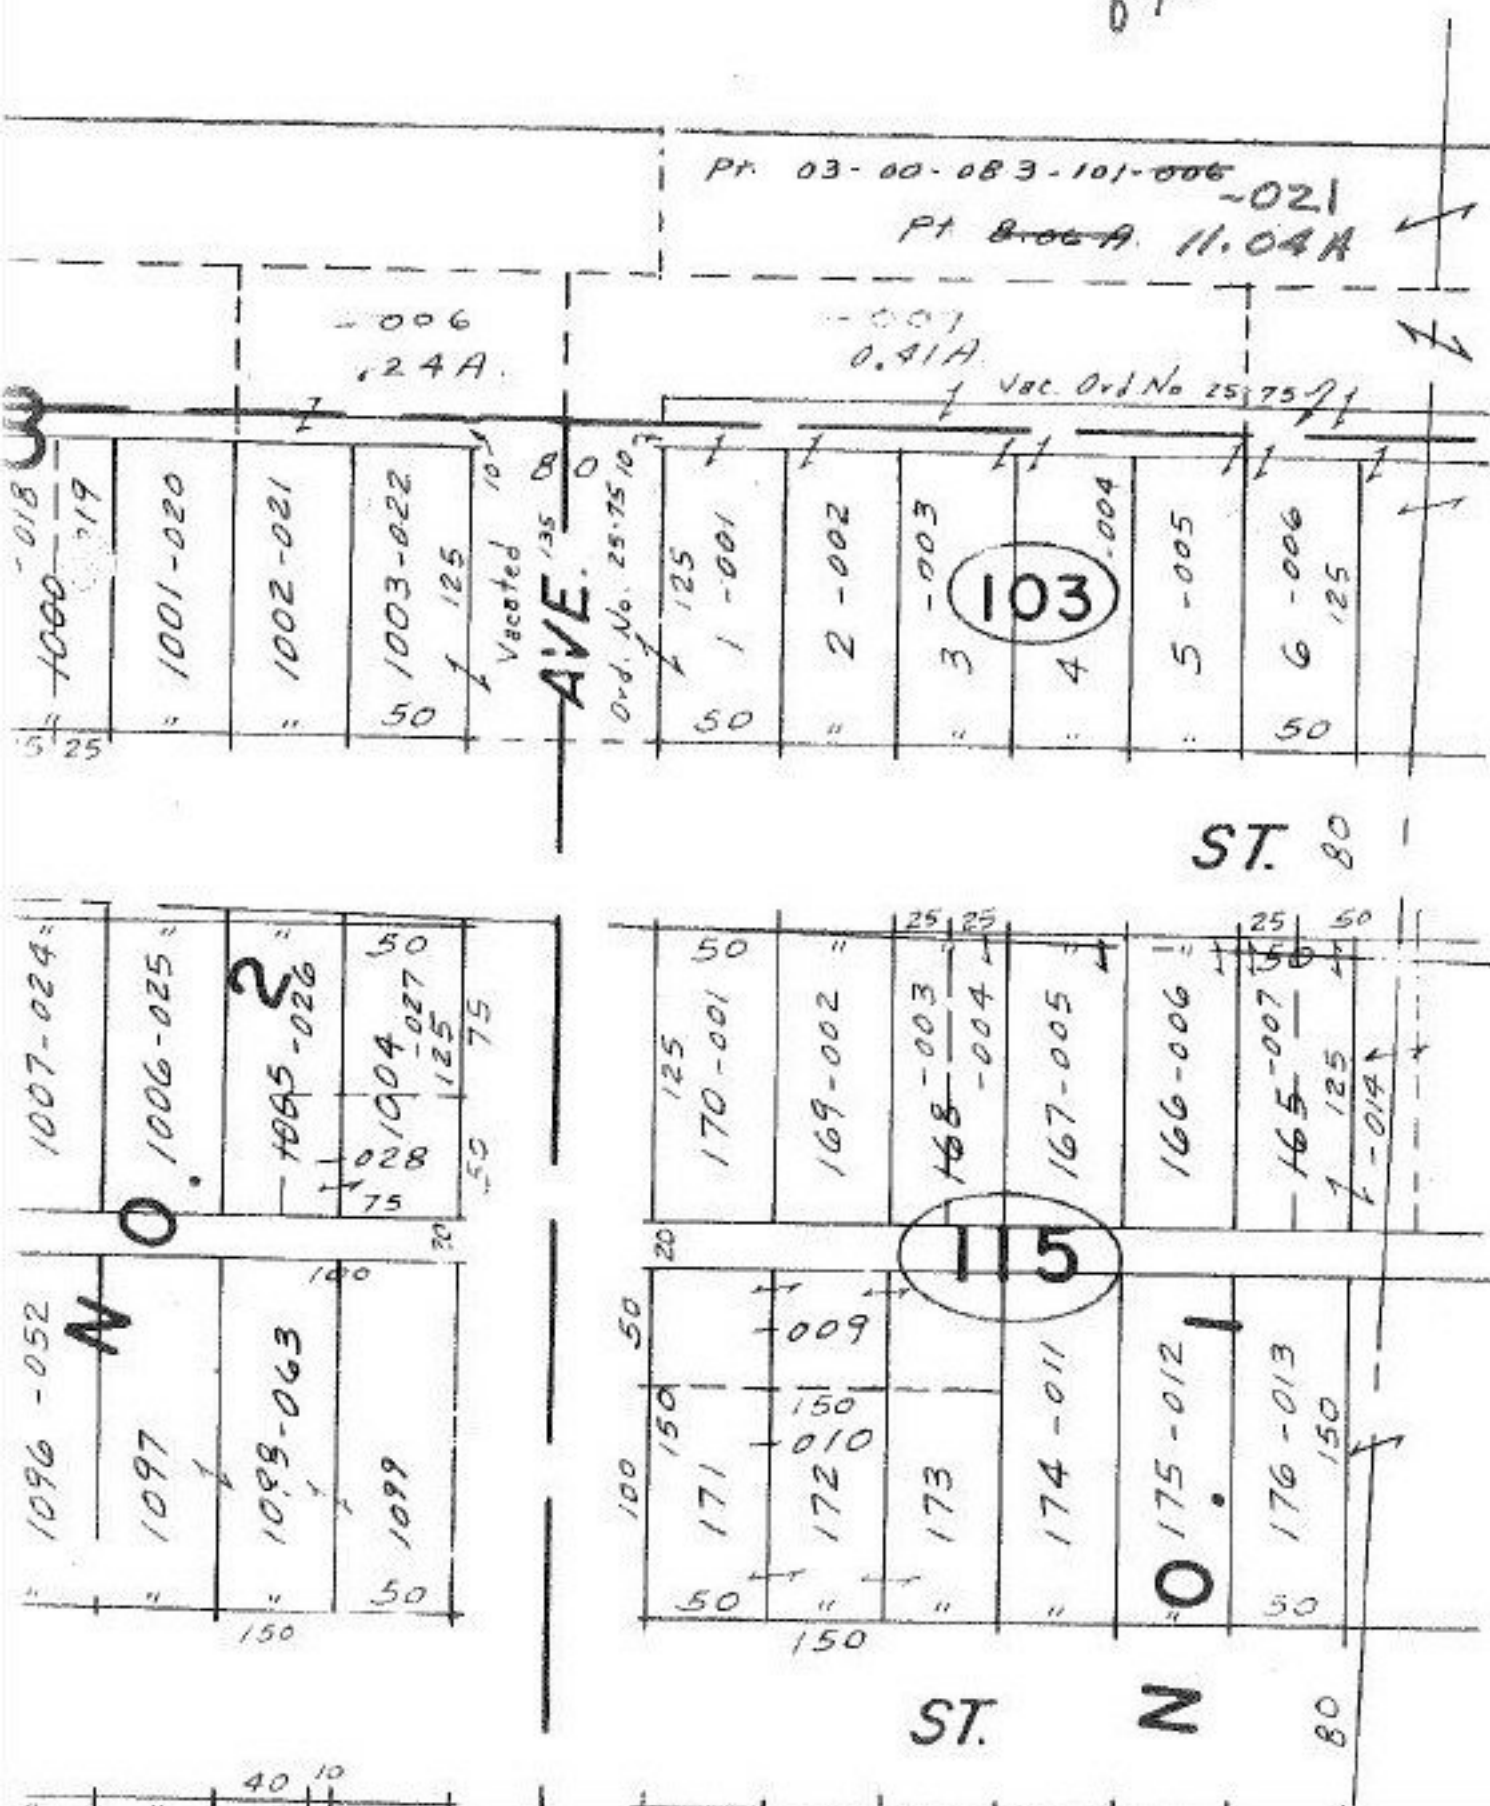

16153

APPROVED	
LORAIN CO.	
MAP DEPT.	
DATE 5-6-85	
PAGE 3-00-096B	
BY	<i>[Signature]</i>
VOID AFTER	16153

T.M.
8-1-85