
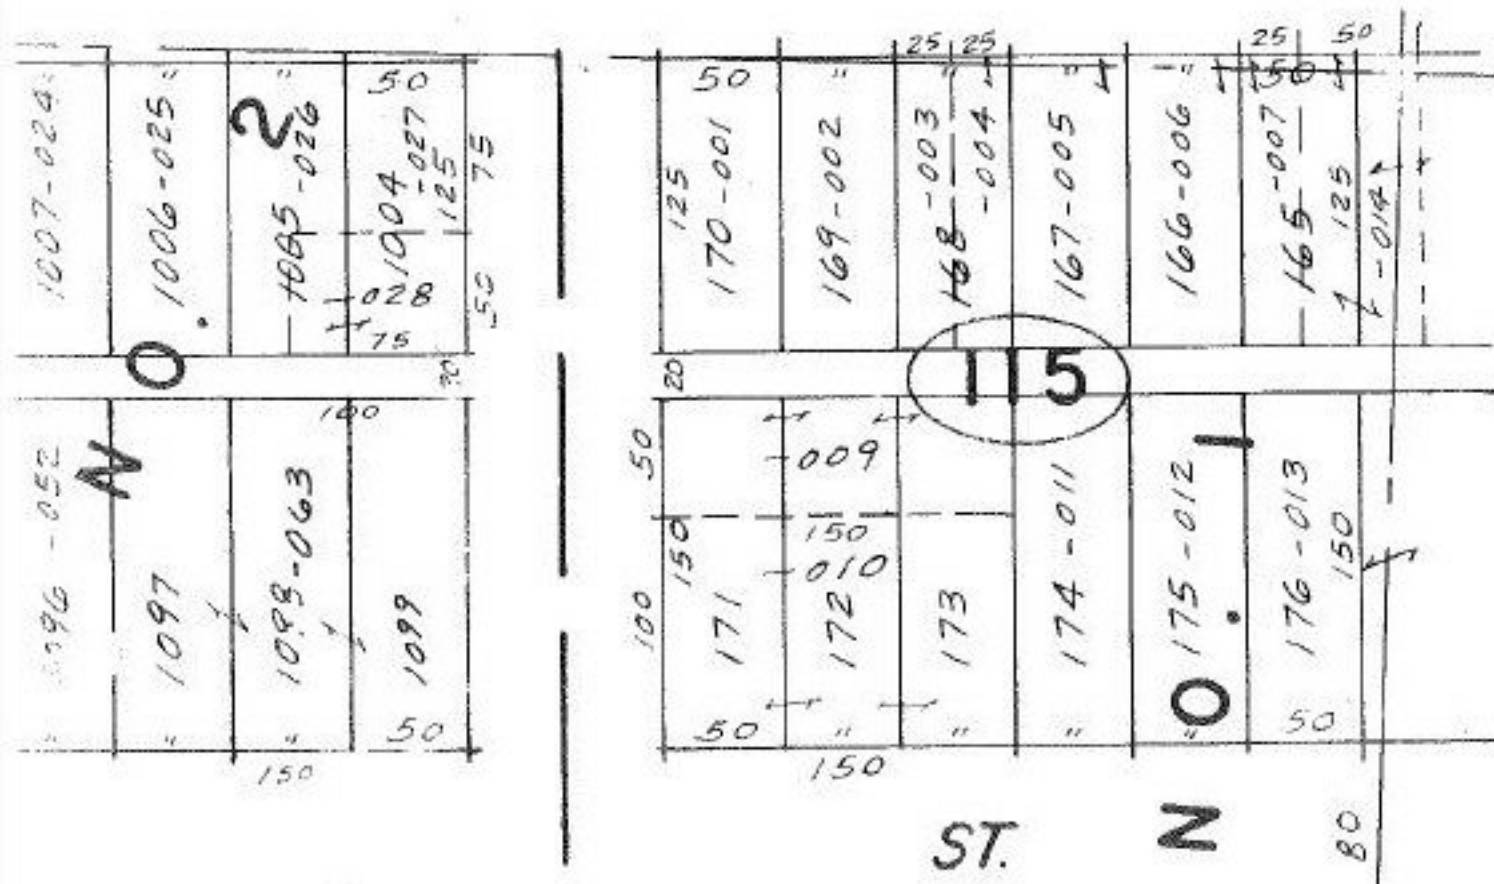


COMBINATION

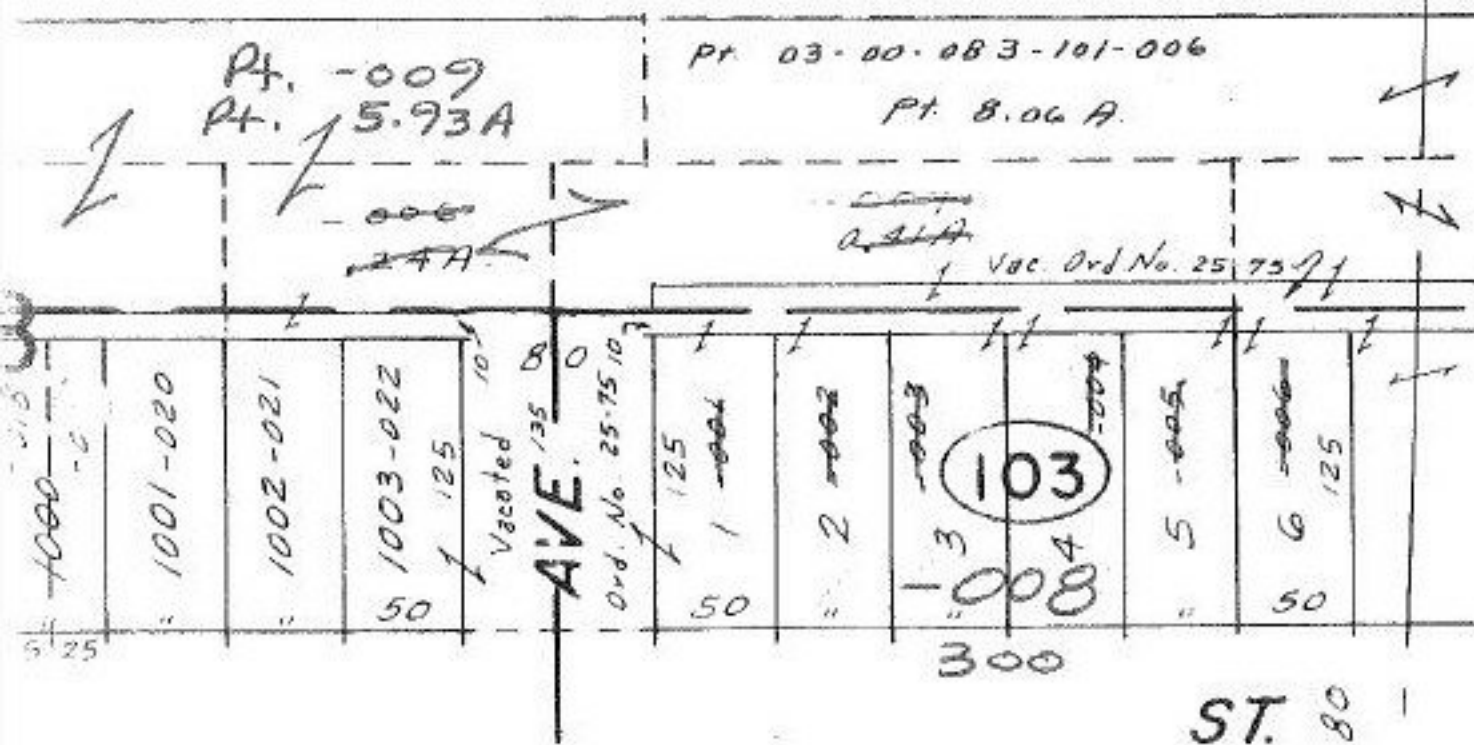

T.M.
7.31.85

#16155

APPROVED LORAIN CO. MAP DEPT.	
DATE 5-6-85	
PAGE 3-00-096B	
BY <i>[Signature]</i>	
VOID AFTER	16155