
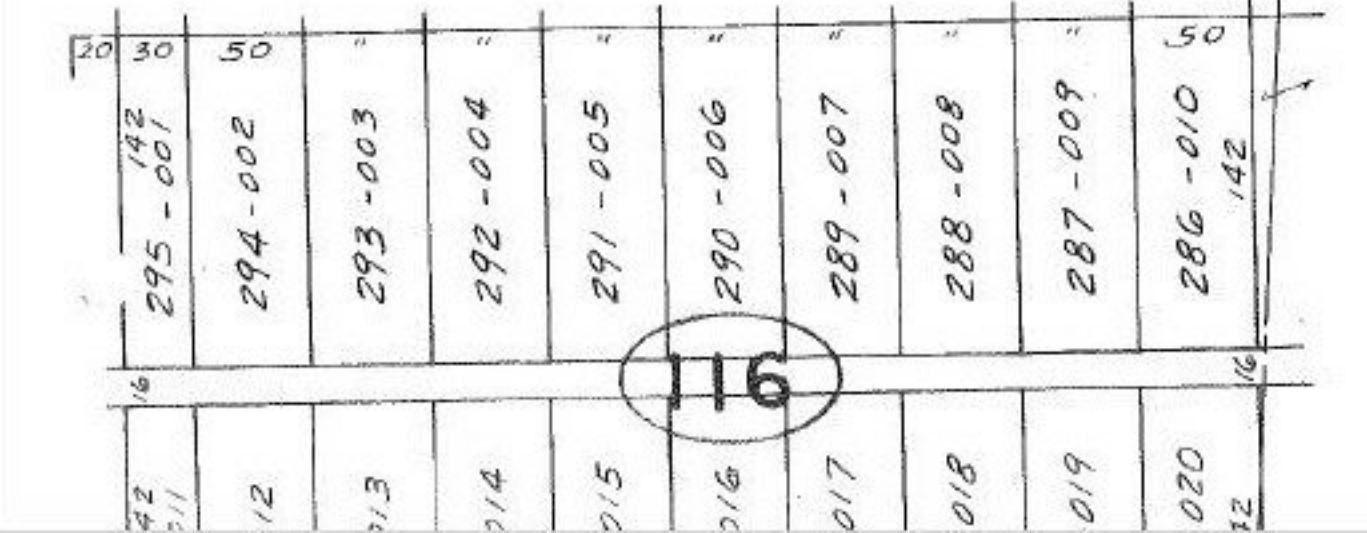
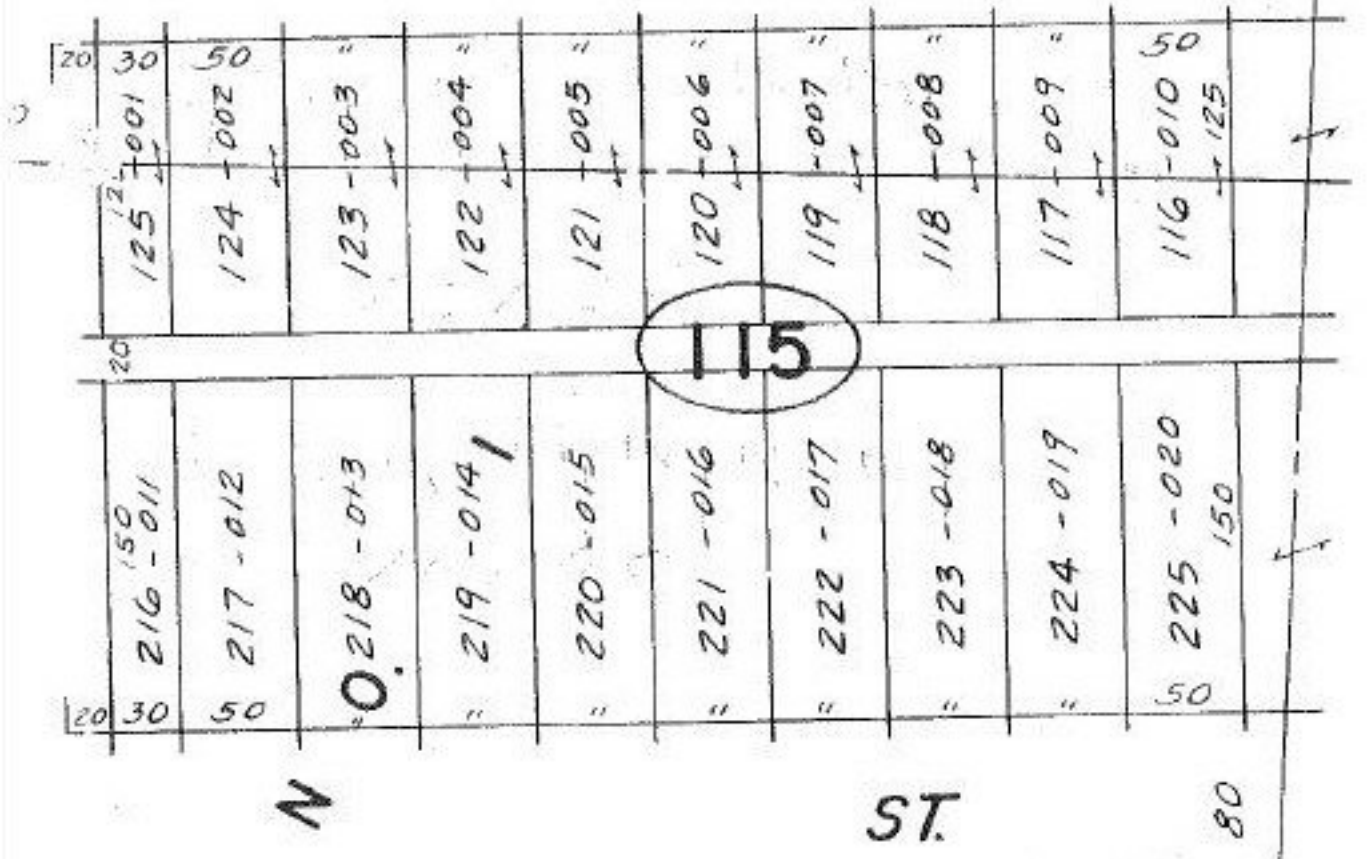


03-00-083-101-006
Pt. 806h.

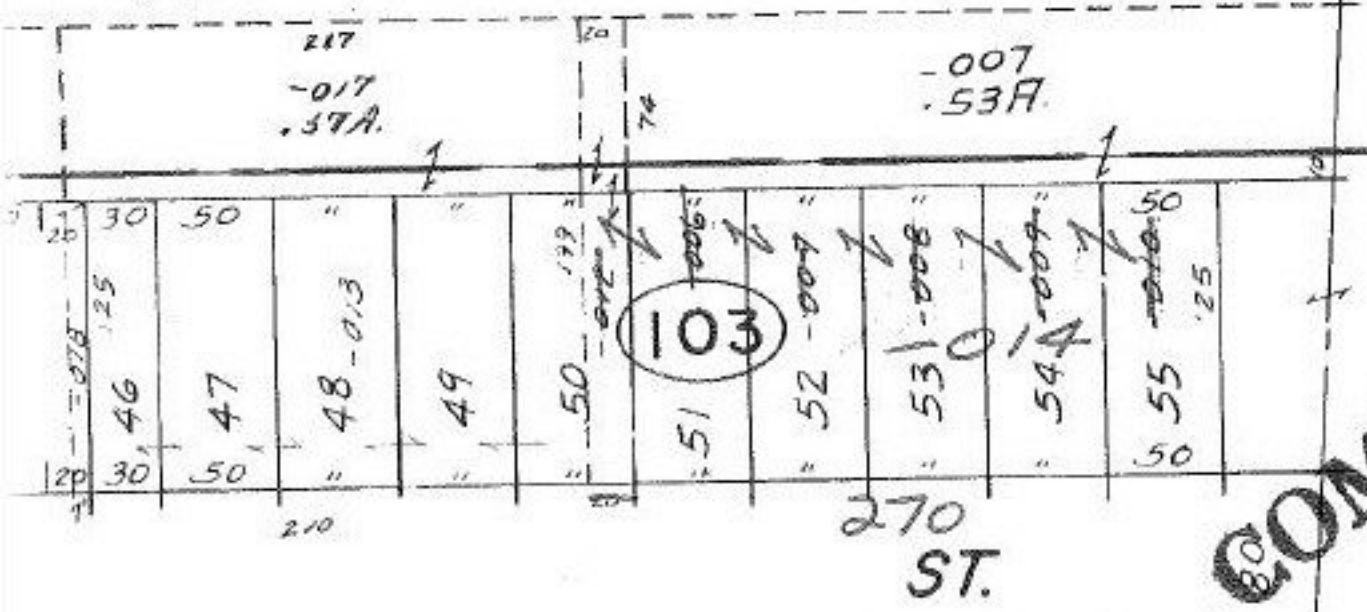

COMBINATION

T.M.
7.31.85

#16157
APPROVED
LORAIN CO.
MAP DEPT.
 DATE 5-6-85
 PAGE 3-00-095B
 BY *[Signature]*
 VOID AFTER 16157