

747.28

146

49.5

165  
135

289

-024  
1.00 A.

66

366.96  
-020  
.50 A

Pt. -027  
Pt. 26.72 A.

# COMBINATION

0.75  
0.0

Pt. -002  
Pt. 3.09 A.


-004  
.92 A.

PROFESSOR

#16165

APPROVED
LORAIN CO.
MAP DEPT.
DATE 5-3-85
PAGE 9-00-065 B
BY <i>J. Lambert</i>
VOID AFTER 16165

20.0

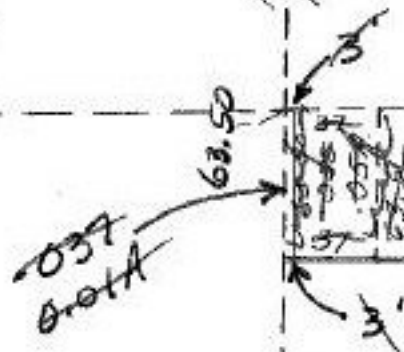

300  
260  
~~005~~  
38 A. 0.44 A.  
300  
260

Pt -003  
Pt. 8.99 A.

-038  
1.15 A.

~~036~~  
1.16 A.

132

15.75

300

SEE 9-00-075-3