


SEE 5-00-009-A

7.30
7.22

101

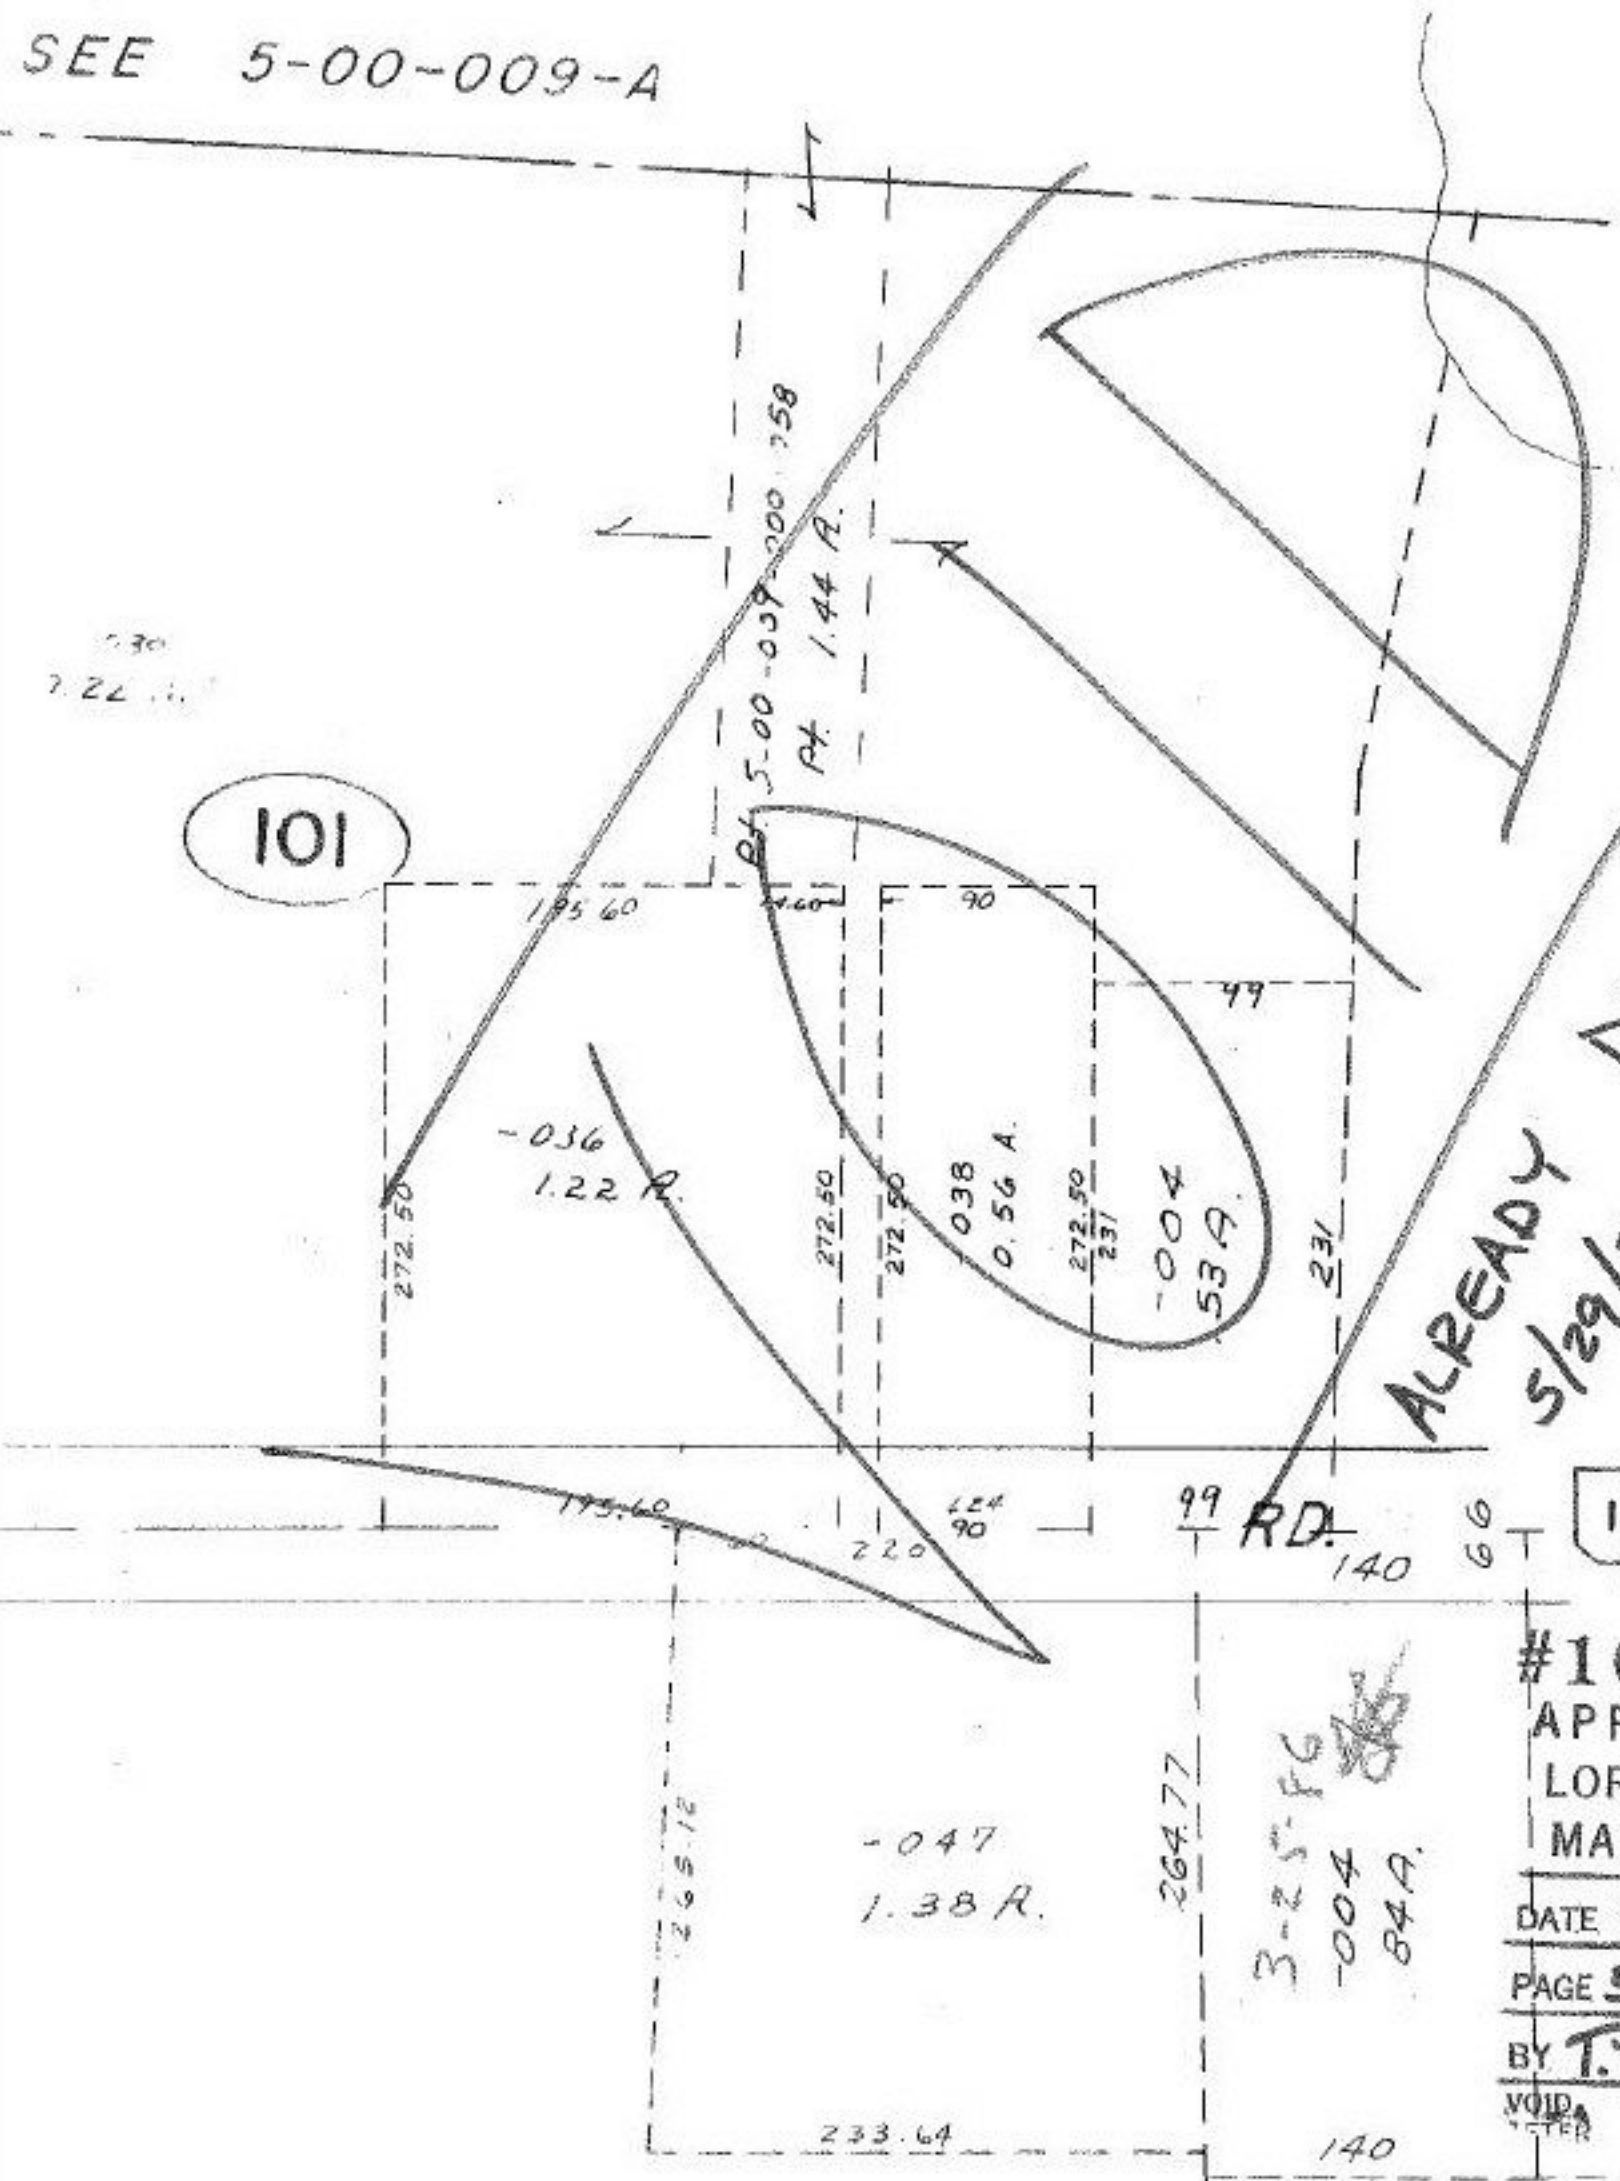

ALREADY DONE
5/29/74 #2009
T.M.



RD. 140

#16178
APPROVED
LORAIN CO.
MAP DEPT.

DATE 6.4.85
PAGE 5.00.010.A

BY T. McMan

VOID AFTER

3-25-FG
-004
84A.

20-010-B

98-15-86