


SEE 4-00-019-E

FAY

1451.51

- 227.
3.68 A
Pt. 067
Pt. 2747A

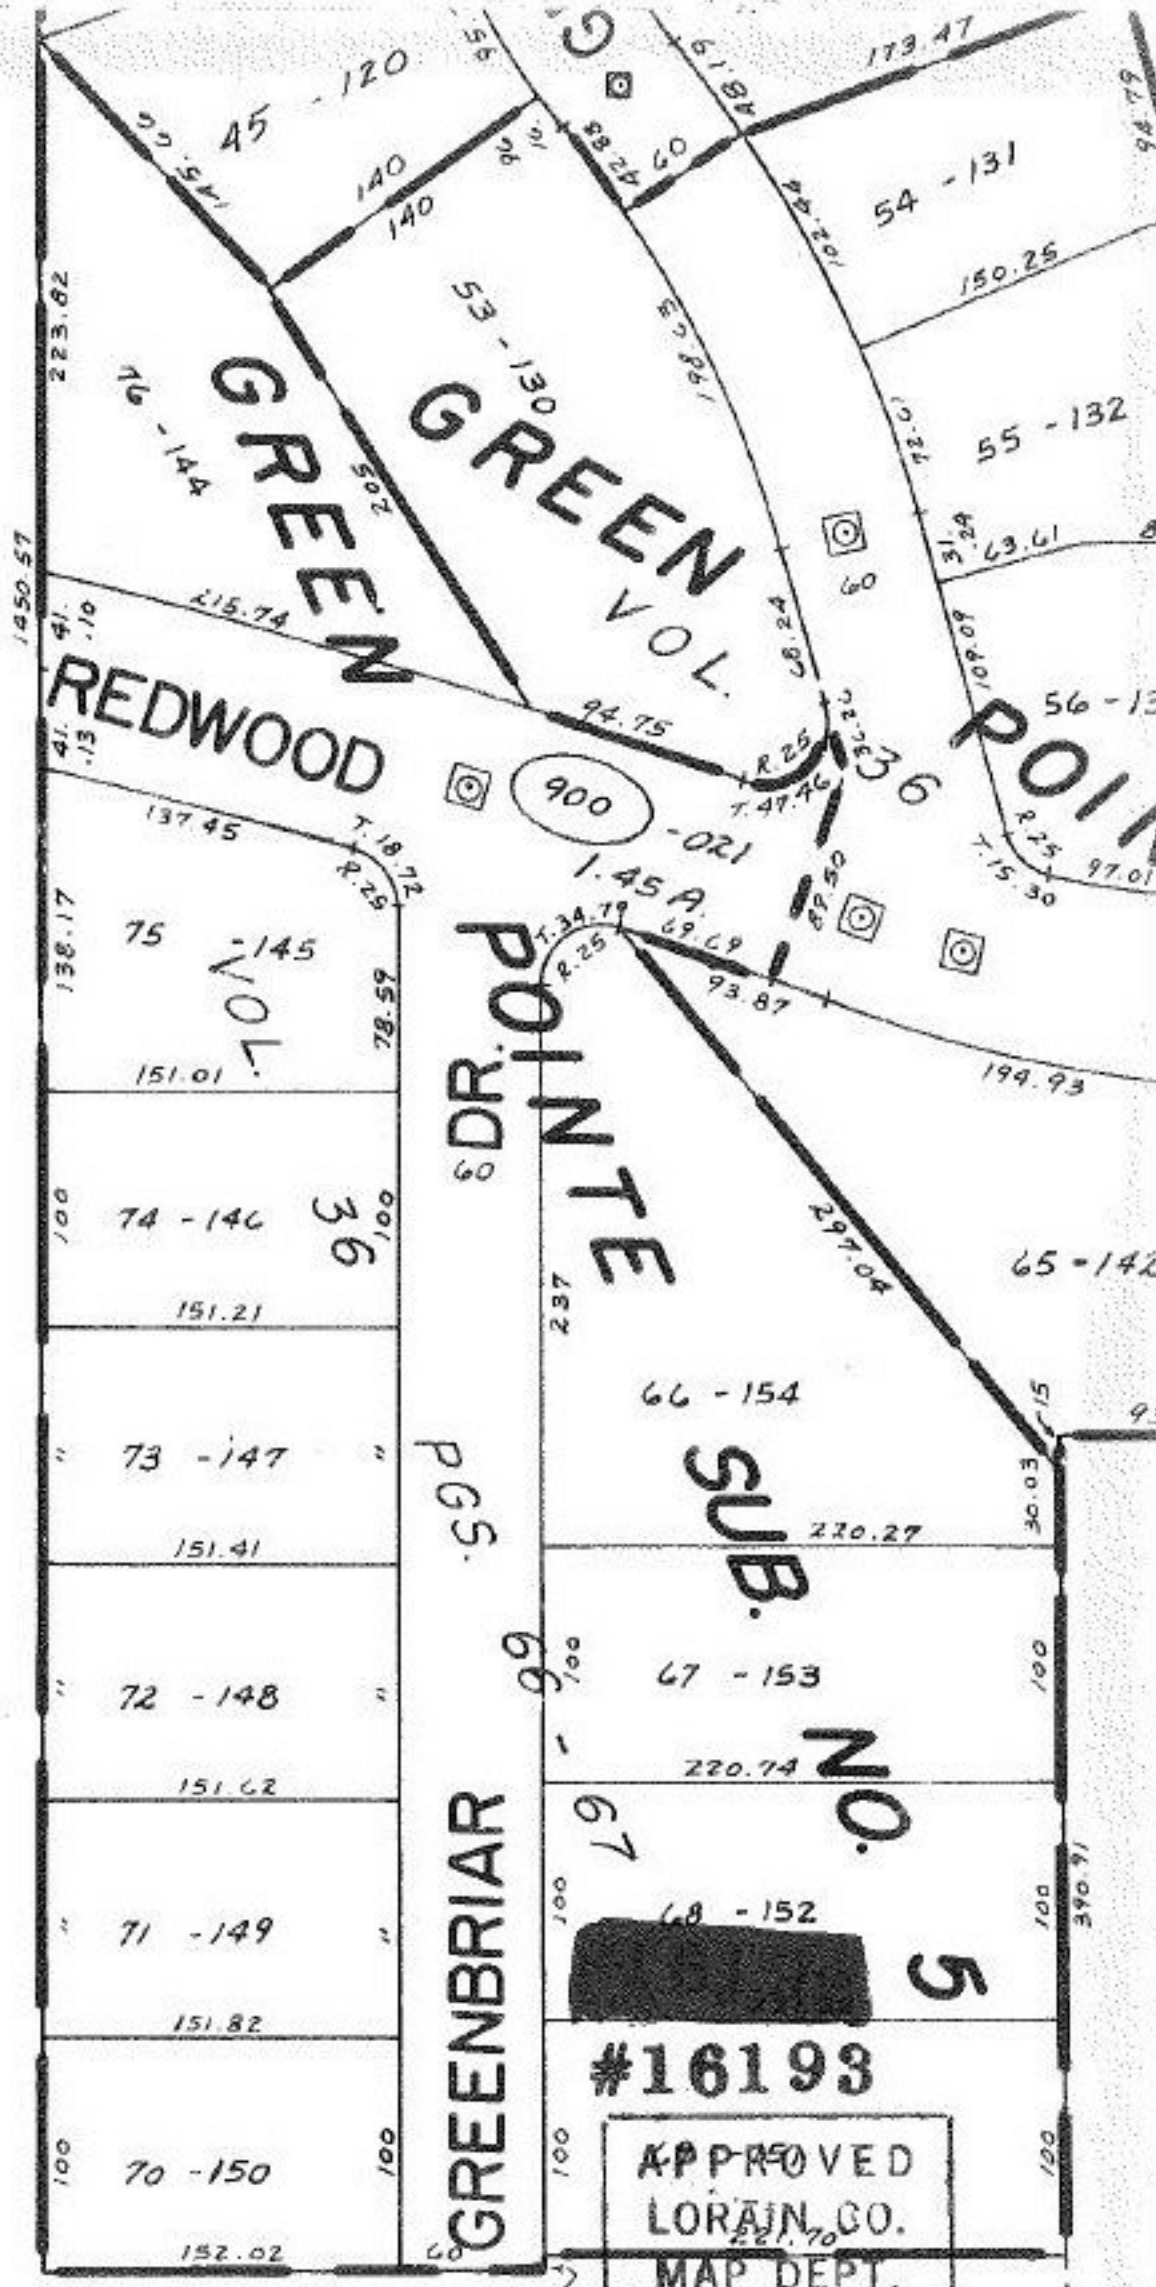

#16193

APPROVED
LORAIN CO.
MAP DEPT.

DATE 5-20-85

PAGE 4-00-019-F

BY C. Francis J. Hollis
VOID 11 102