

11-25-87 BT

38

-103
120.10 A.

RD.




1621

APPROVED
LORAIN CO.
MAP DEPT.
DATE 3-20-68
BY *R. B.*
OF [unclear]

*28.05
8.8*

*Done 5/11/68
to [unclear]*

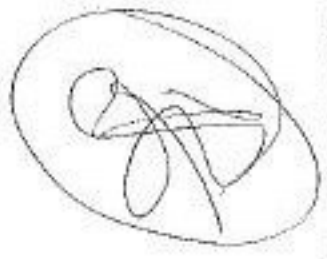

-005
119.26A. 37

-003
~~120.00A.~~

700
-004
6.74A.
700

420

420

-001



-002

R BAKER