

6-1-870K

69.48

-023  
4.6

537  
139  
500


24.

200.72  
EDGEVILLE

**DONE 5-9-68  
FRANK COLBERT**

**1622**

**APPROVED  
LORAIN CO.  
MAP DEPT.  
DATE 3-28-68  
BY [Signature]**

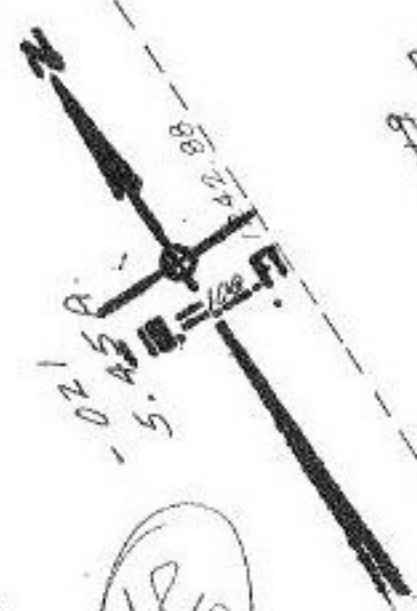

-020  
A.080

101

-020A  
1.83

-029  
1.34A

-014  
1.50A

-013  
405.50

-018  
.62A

216.02  
138.96

409.07  
230.46

118.94

-026A  
0.66

258.91

150.84

333.62

816.02

808.57

333.23

150.01

400

160

1288.27

-021  
5.45A

100 FT

[Circled Signature]

