


FIELD

154.20 316-146
2674 60 55 65
151 151 65 55
52.45 60

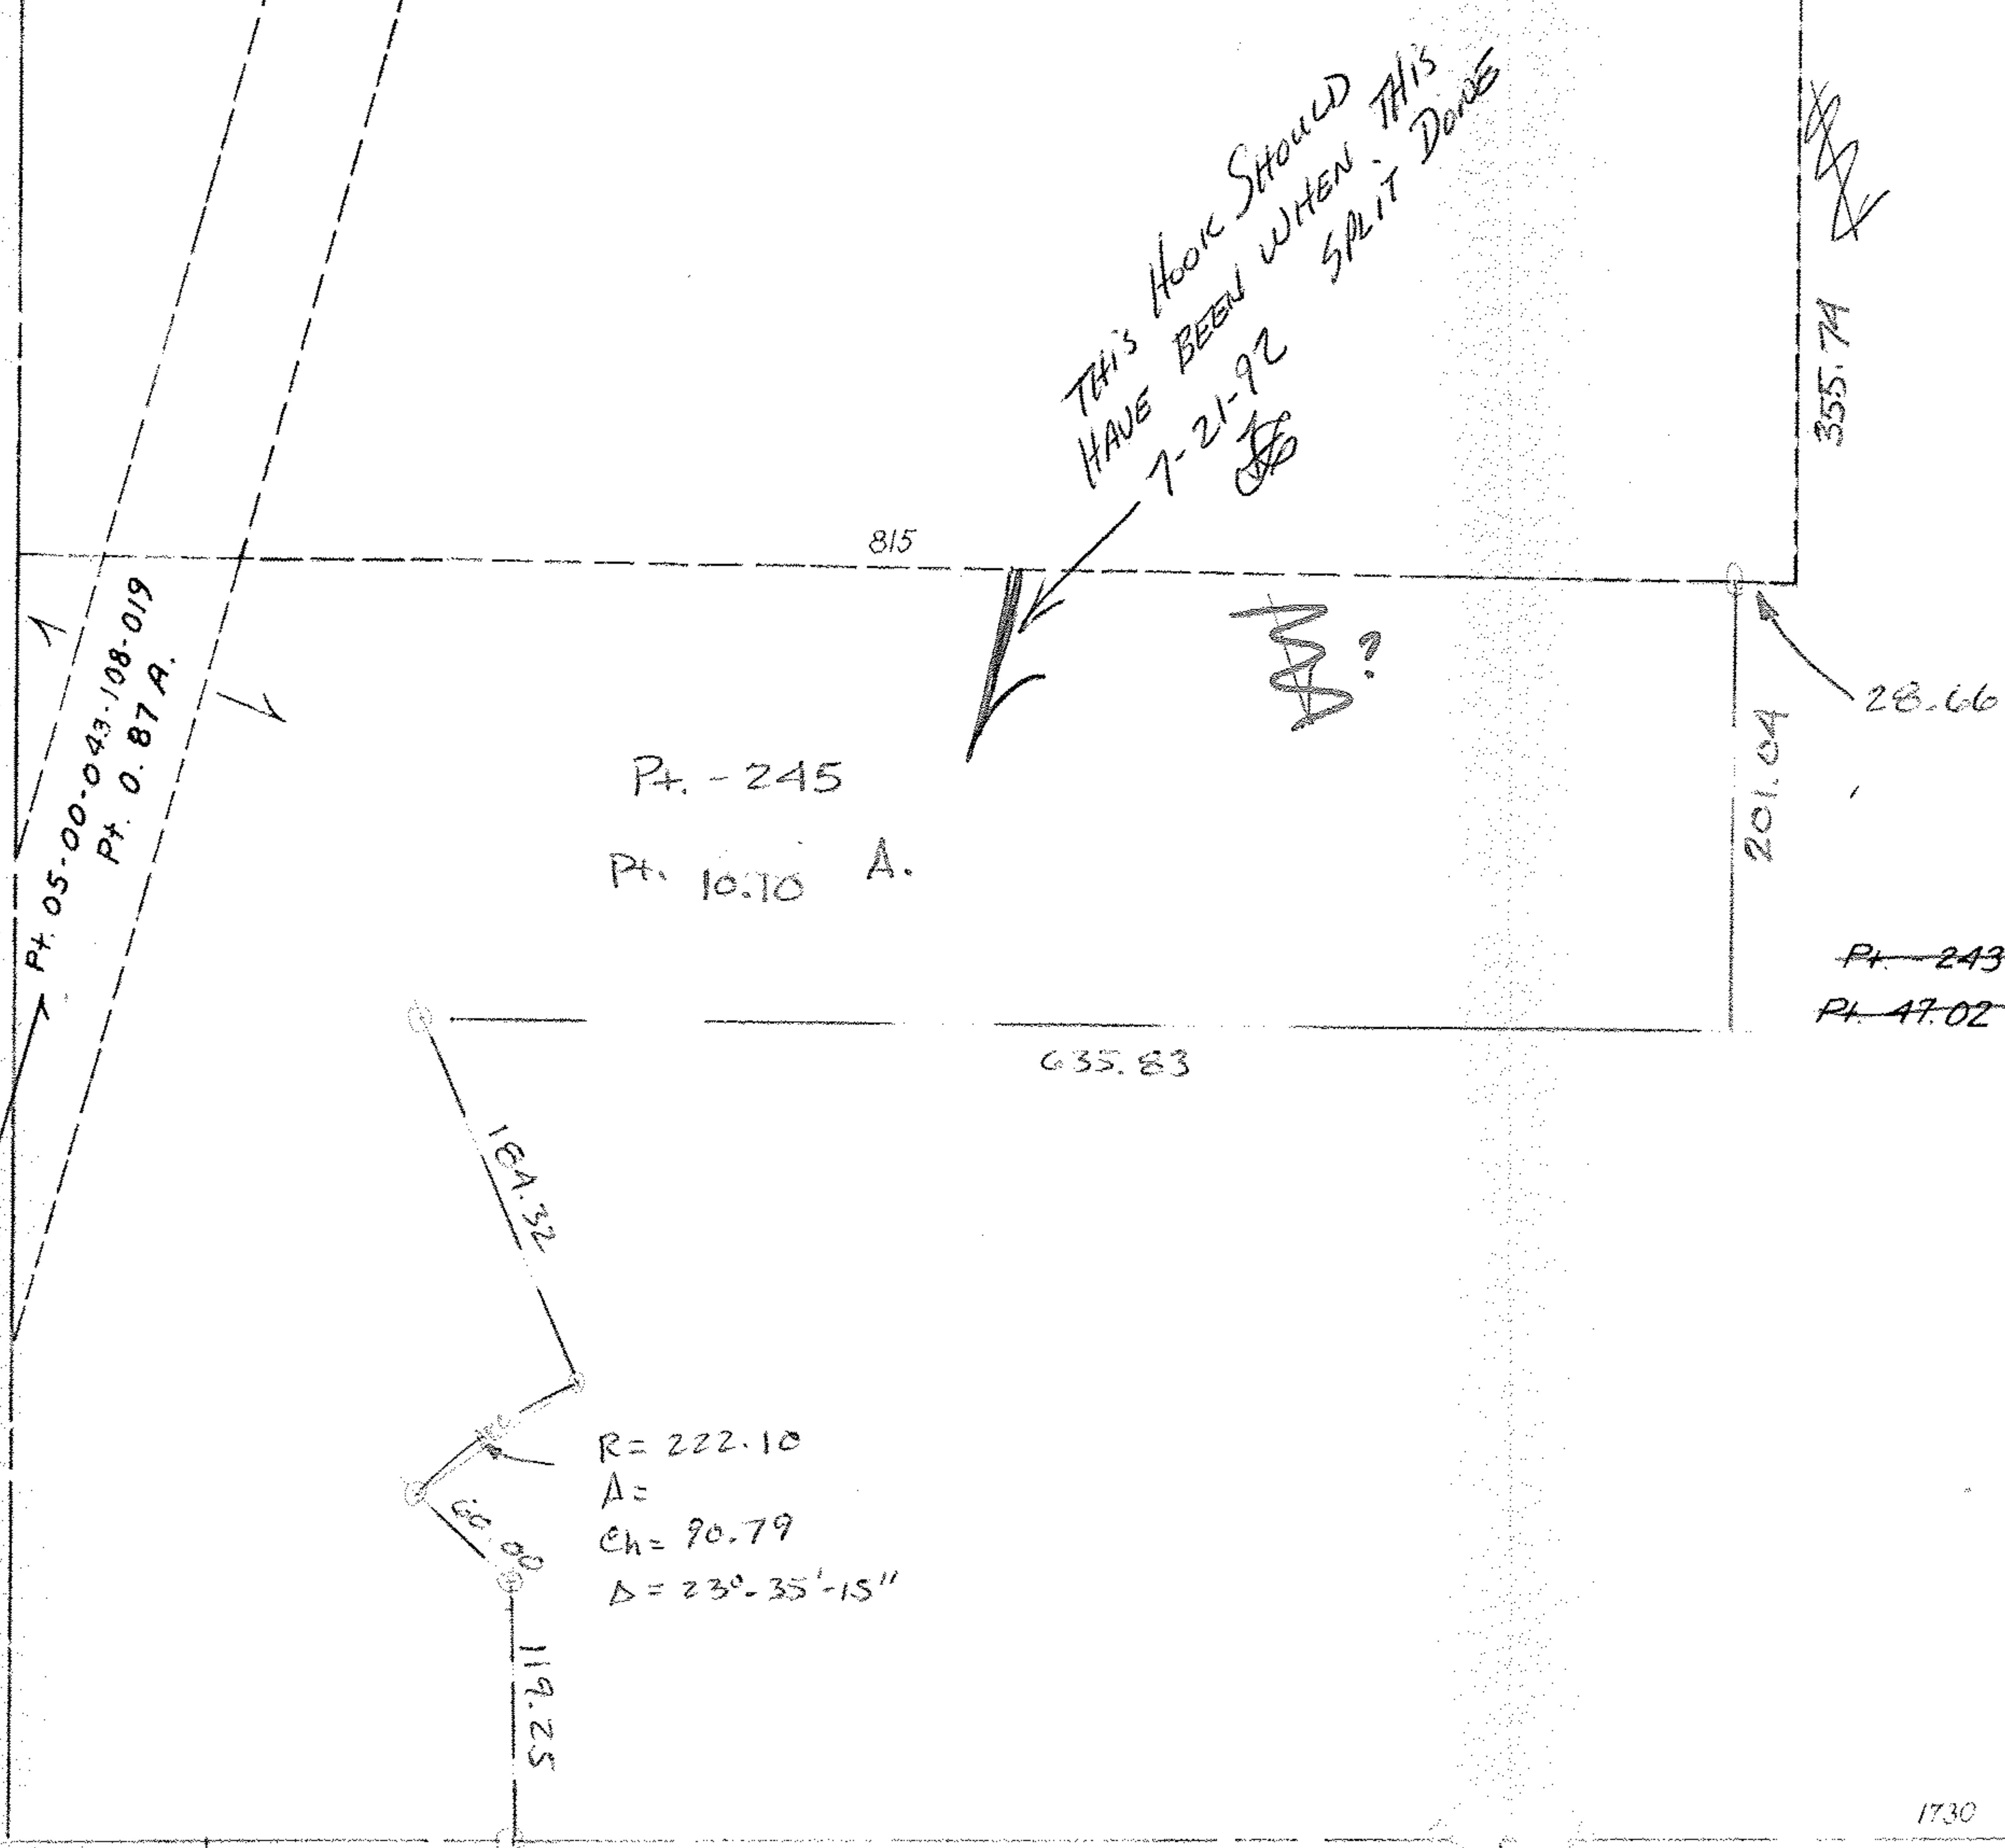

SEE 5-C

#16230

APPROVED
LORAIN CO.
MAP DEPT.

DATE 7.1.85

PAGE 500.058 A

BY T. McHain

VOID

T.M.
7.17.85

#1685.51 →