


802.09

-010  
9.47 A.

\* THIS RECEIPT FILLED OUT BY F.E. COLBERT ON 6/21/85 AND NEW NUMBER ADDED TO REGISTER ON THE SAME DATE BUT NO TRANSFER SHEET COULD BE FOUND, EITHER IN THE TRANSFER OFFICE, OR IN THE MAP DEPT. WHERE THE RECORDS HAVE BEEN PUT IN STORAGE.

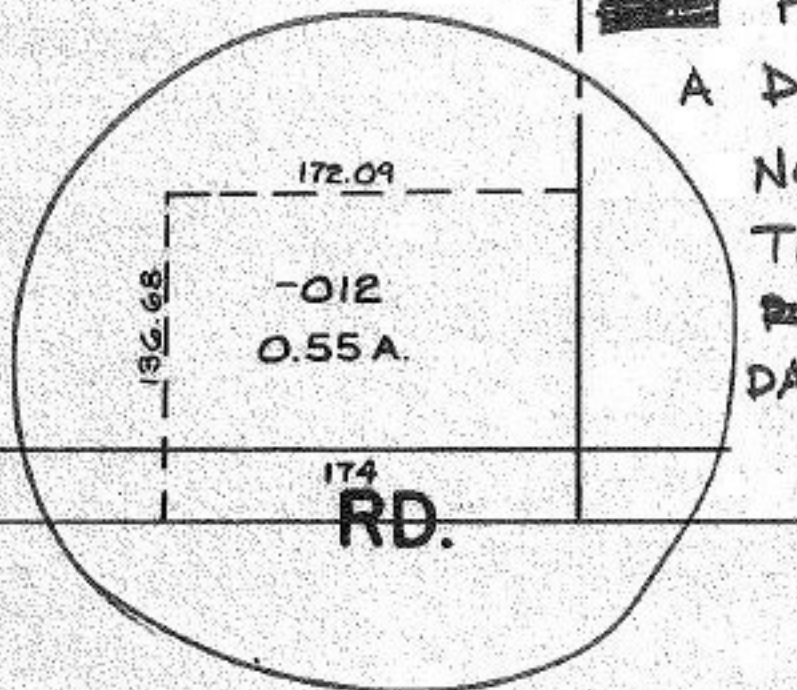

~~PROOF~~ PROOF OF FILING AND A DEED REFERENCE ARE NO LONGER AVAILABLE SO THIS ADD TO DUP. IS BEING ~~PUT~~ DATED 6/21/85 FOR DATE IN/DONE/FILED ON CHART

ADD TO DUP.

\*\* MYLAR WAS UPDATED WHEN THIS PAGE WAS REDRAWN IN SUMMER 1985.

CORRECTION

CHECKED ON THIS DATE  
THIS MAP MADE ON THIS DAY

7-21-86  
REVISED

14-00-160-B

#16237

APPROVED
LORAIN CO.
MAP DEPT.
DATE 2.6.86
PAGE $\rightarrow$
BY T. McMain
VOID AFTER