


17-0. 004-000-013

004-000-003

R. R. 66

1600
100'
0.07A.

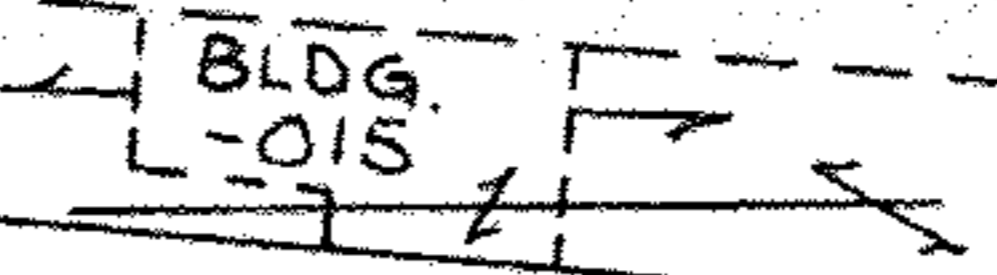

116.25

41.25

-006 0.50 A.

528.0

-018 0.92 A.

625.80

Need
to PUT EXCEPTION ON DEED

41.25

434.40

-025
10.37A

265

-019
13.51A

-024
2.64A

434.40

825.0

265

RD. (E)

#16238

APPROVED
LORAIN CO.
MAP DEPT.

DATE 8-9-85

PAGE 17-07-007-B

BY C. FRANCIS

VOID
AFTER

VOID

~~Pt. 004~~

~~Pt. 55.25 A.~~

Ashland - KIPTON RD.
MEDINA - NORWALK RD.