


4-00-009-M

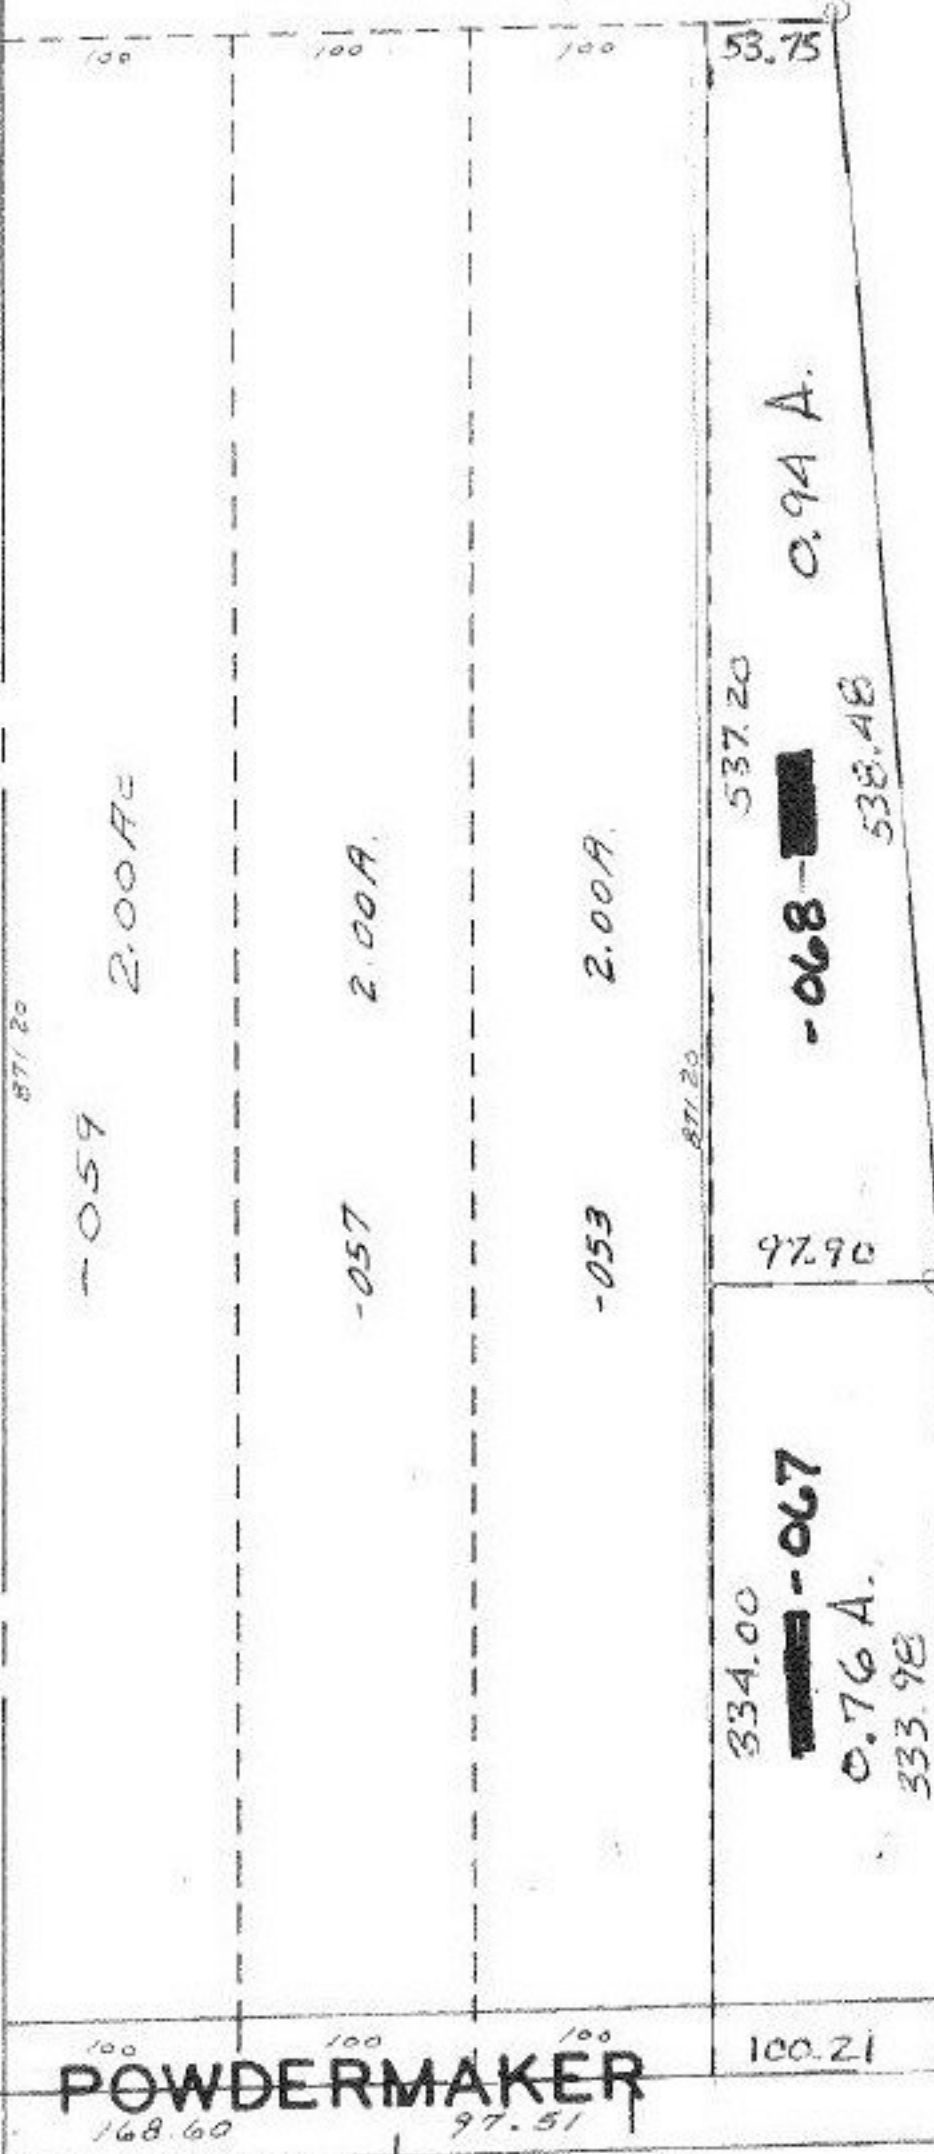

Pt. - 069  
 Pt. 42.25 A.  
~~Pt. 060~~  
~~Pt. 43.95 A.~~

SURVEY -  
 J. HAMILTON  
 CL. #1 1:1000,000  
 CL. #2 1:166,666

#16262  
 APPROVED  
 LORAIN CO.  
 MAP DEPT.  
 DATE 7.9.85  
 PAGE 4.00.016.E  
 BY T. McVain  
 VOID  
 10-25-85

*[Handwritten signature]*