

330

COWLEY

57

RD.

7-28-86

APPROVED
LORAIN CO.
MAP DEPT.

DATE 7-10-85


PAGE 16-D

BY T. McHain

VOID
AFTER

REVISED
4/23/85

16-D

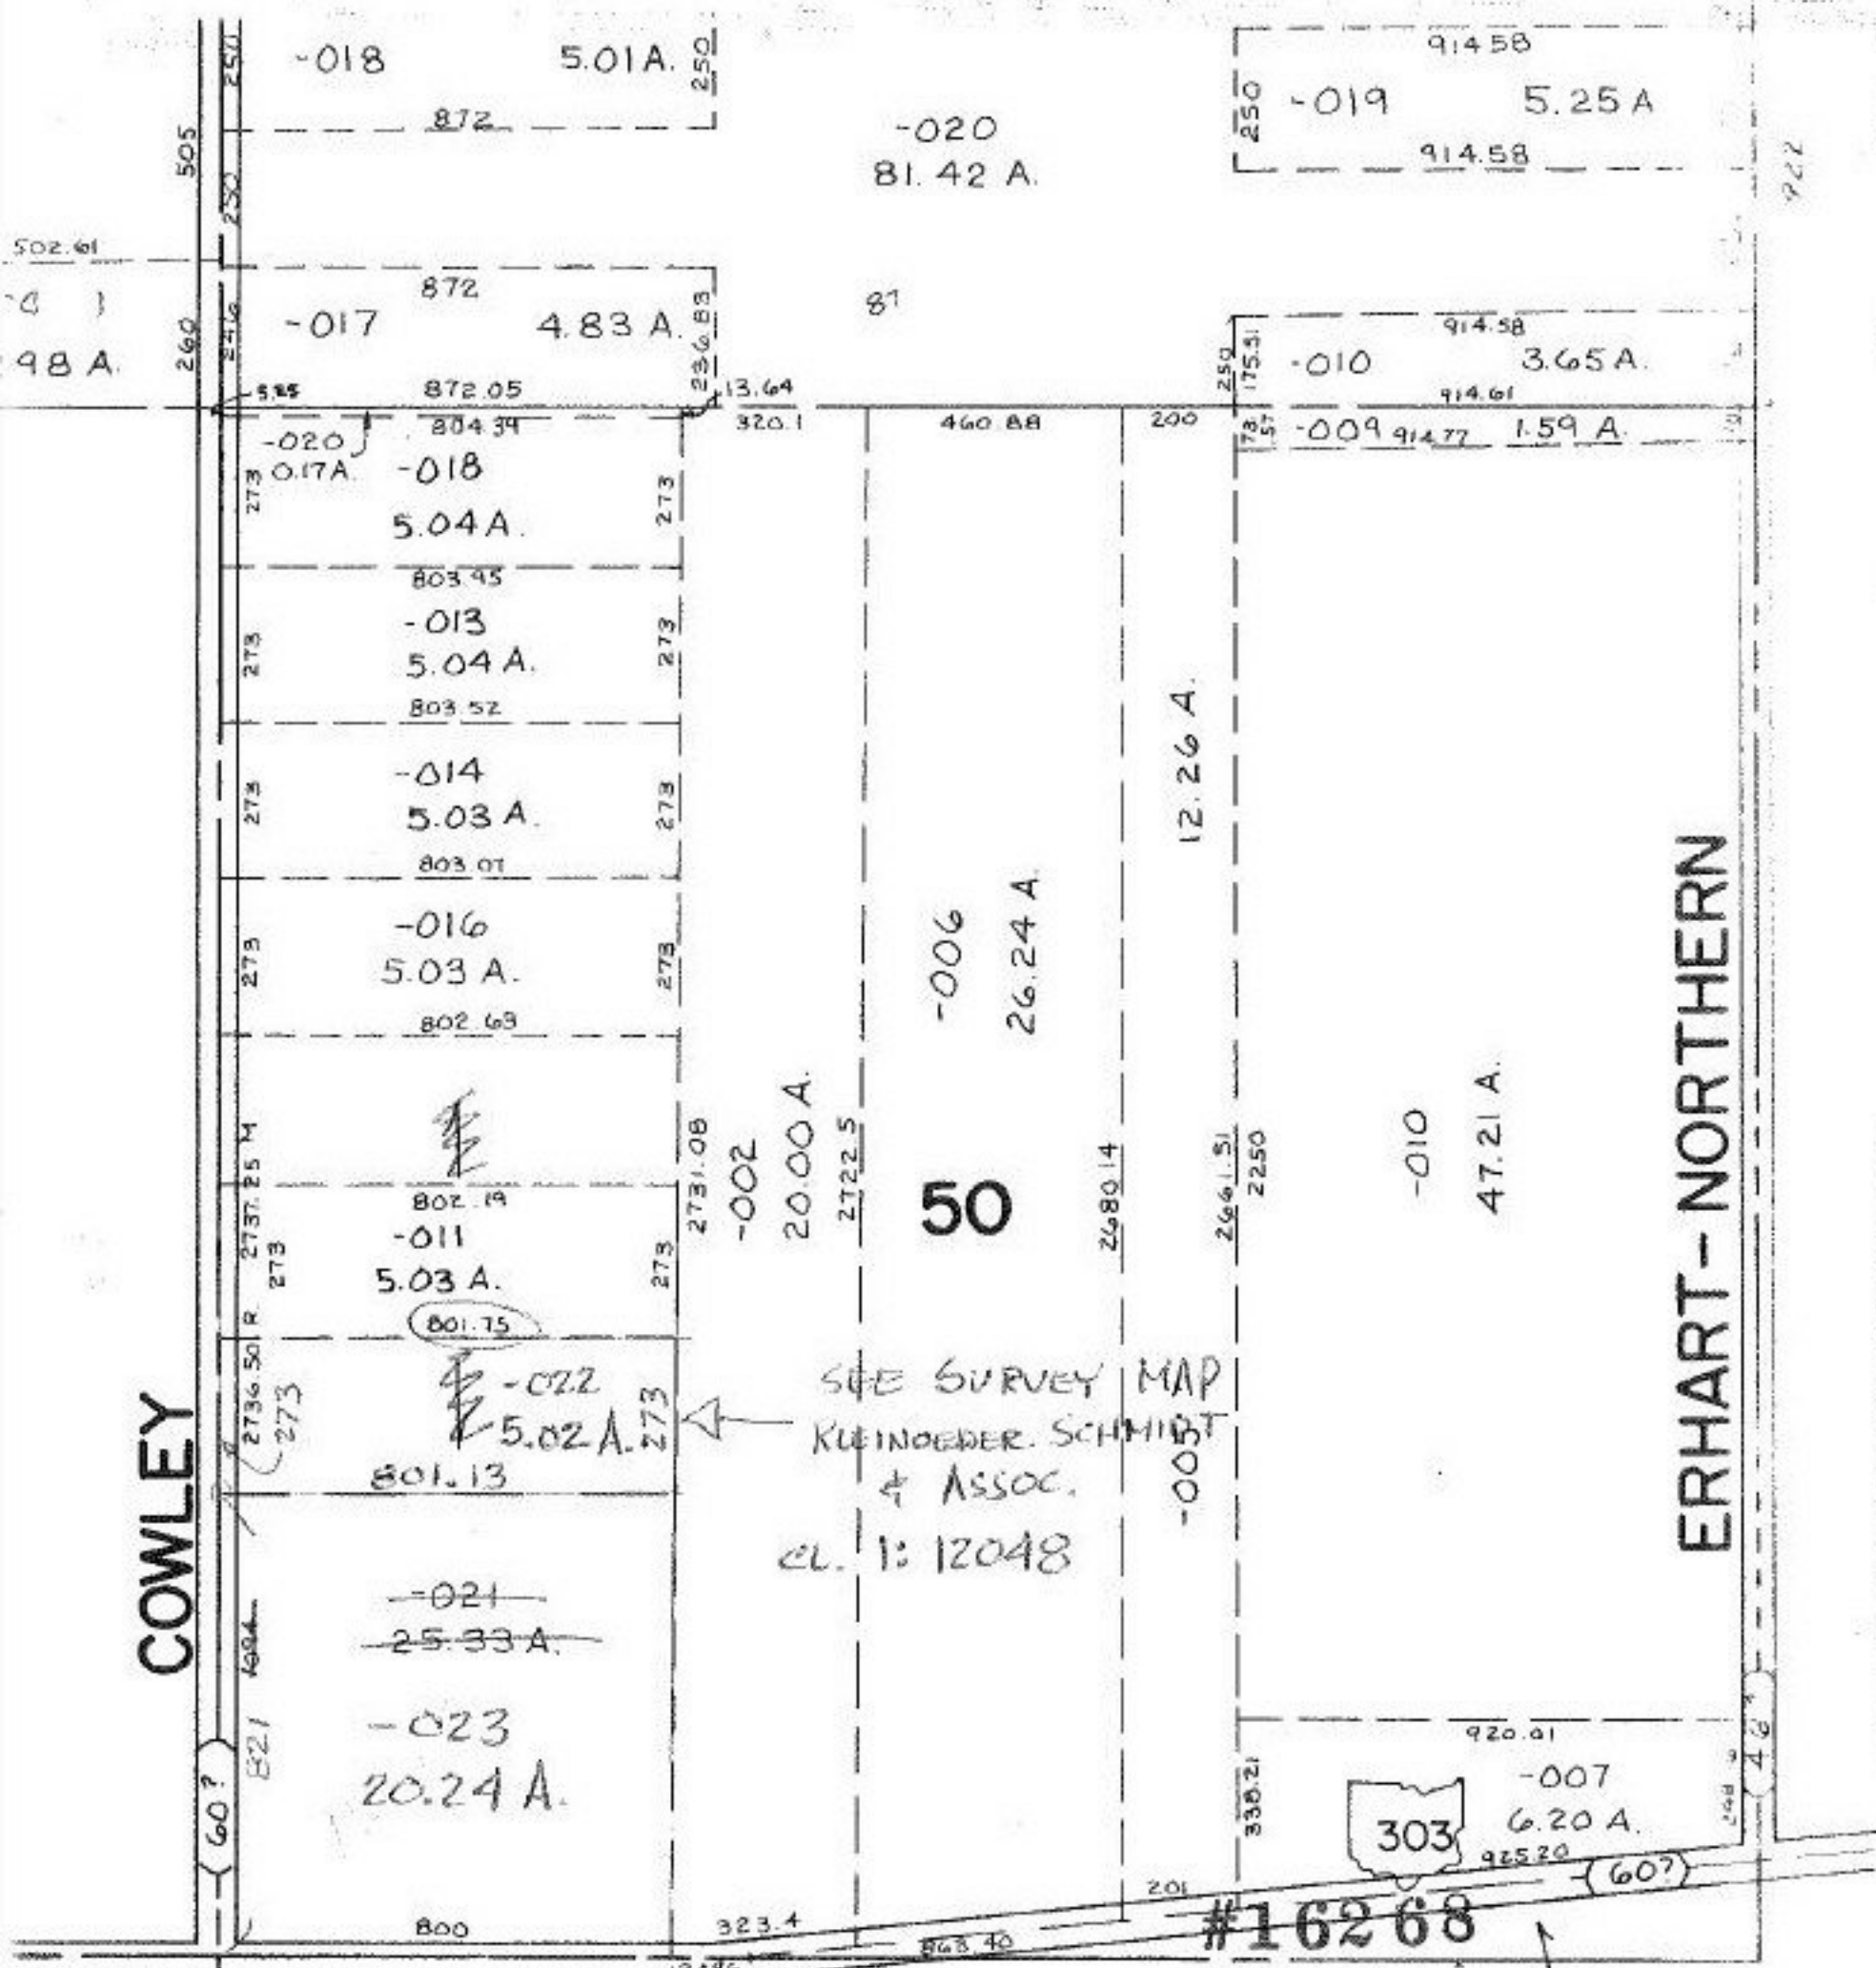

#16268