


11-25-87 OK

ONE FORTHOFFER SUB. NO. 2 SEE 4-00-015-E

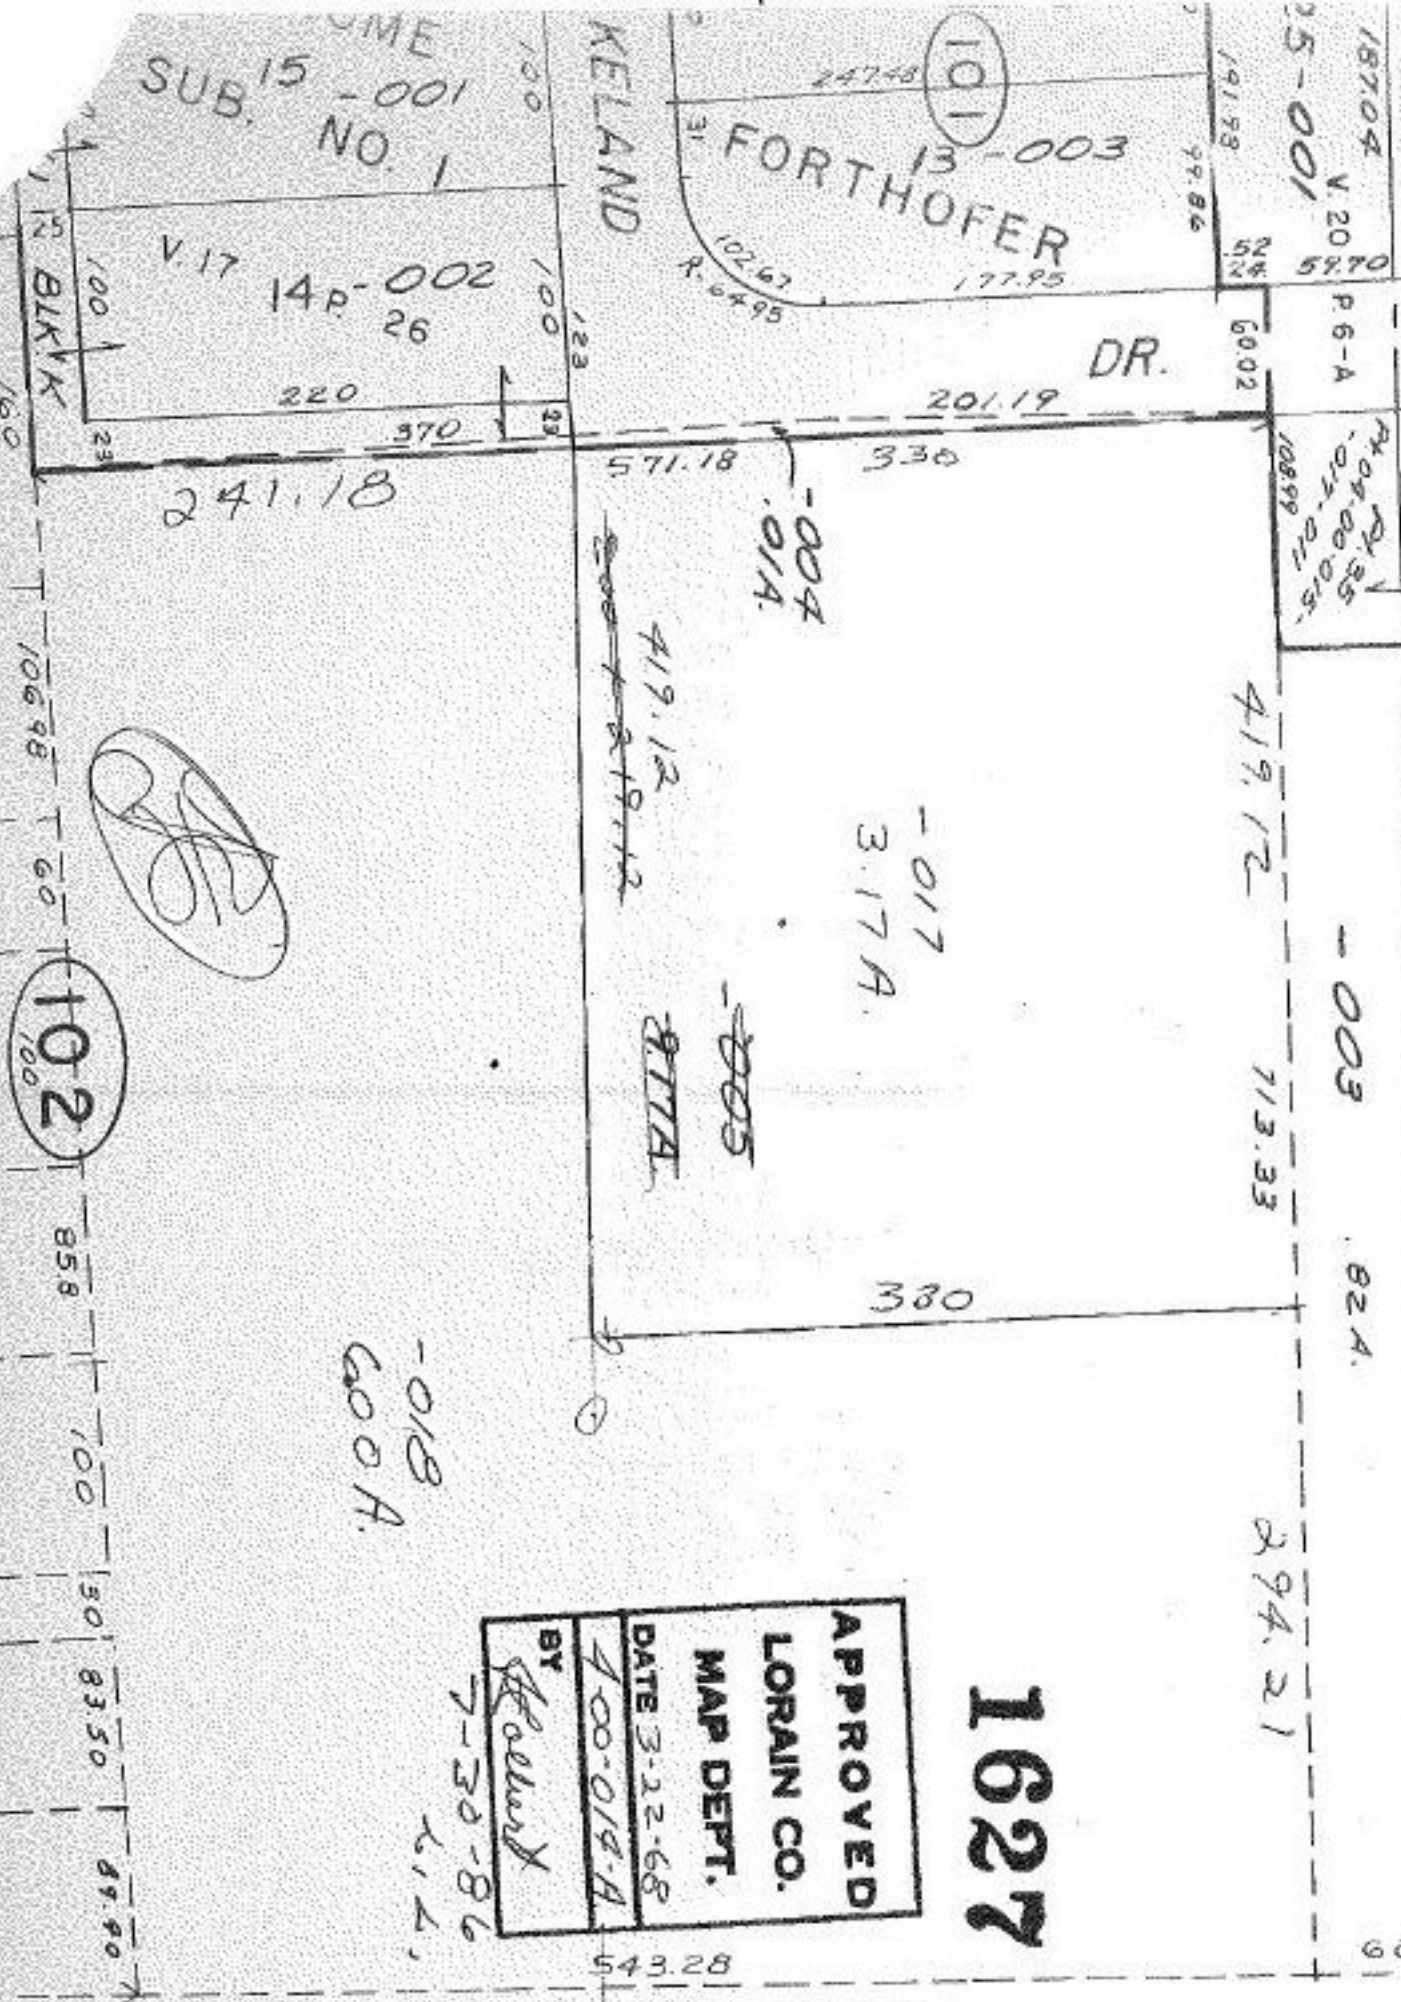

102

1627

APPROVED
LORAIN CO.
MAP DEPT.
DATE 3-12-68
BY *Frank Colbert*
7-30-86

-018
600 A.

-017
3.17 A.

-004
.01 A.

419.12

ATTN

-005

-003

824.

419.12

713.33

294.21



DONE 5-9-68
FRANK COLBERT