
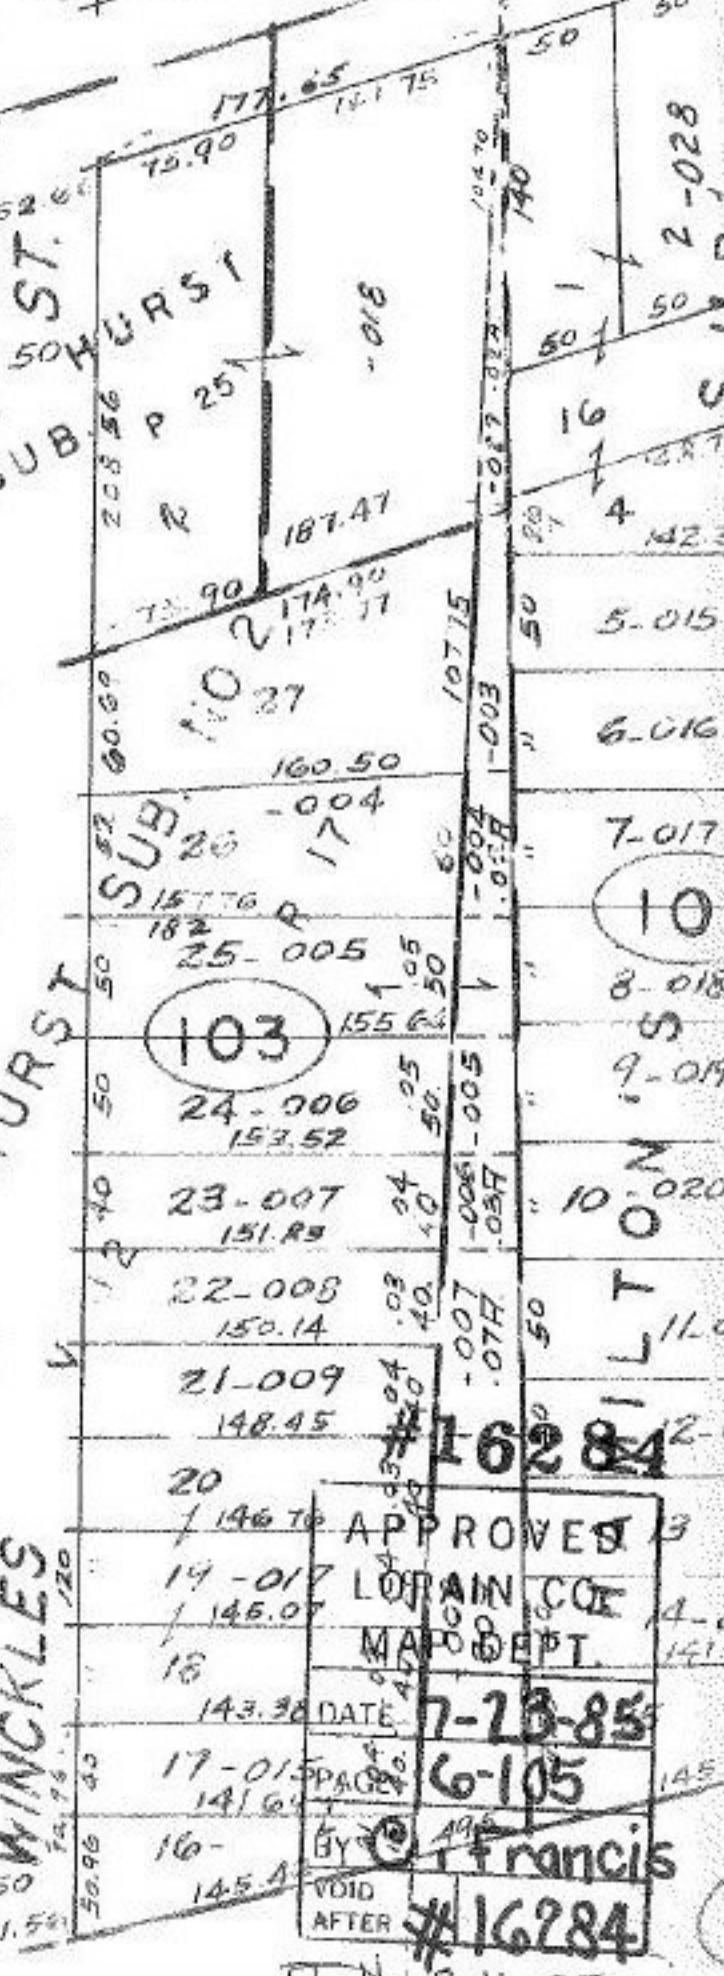


SEE 6-104

# COMBINATION CLEVELAND

NORTH HURST

ST. 50

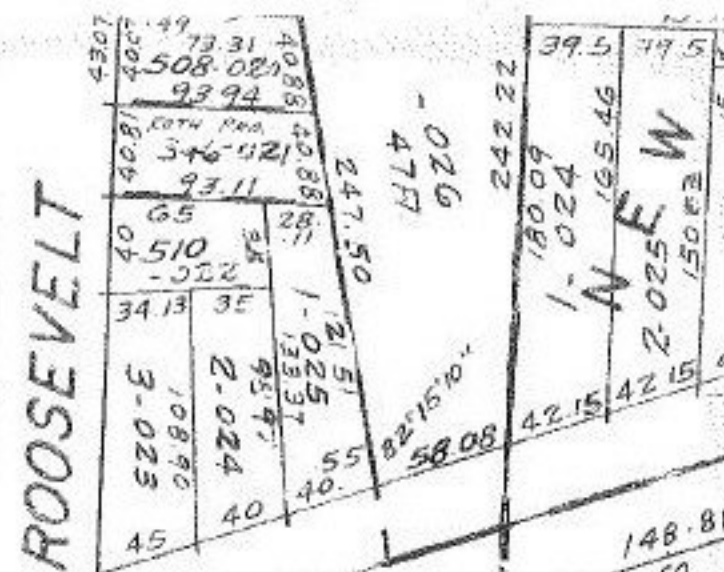

APPROVED  
 LORAIN COE  
 MAPS DEPT.  
 DATE 7-28-85  
 PAGE 6-105  
 BY Francis  
 VOID AFTER #16284  
 9-11-85