


Need Deed
Tract

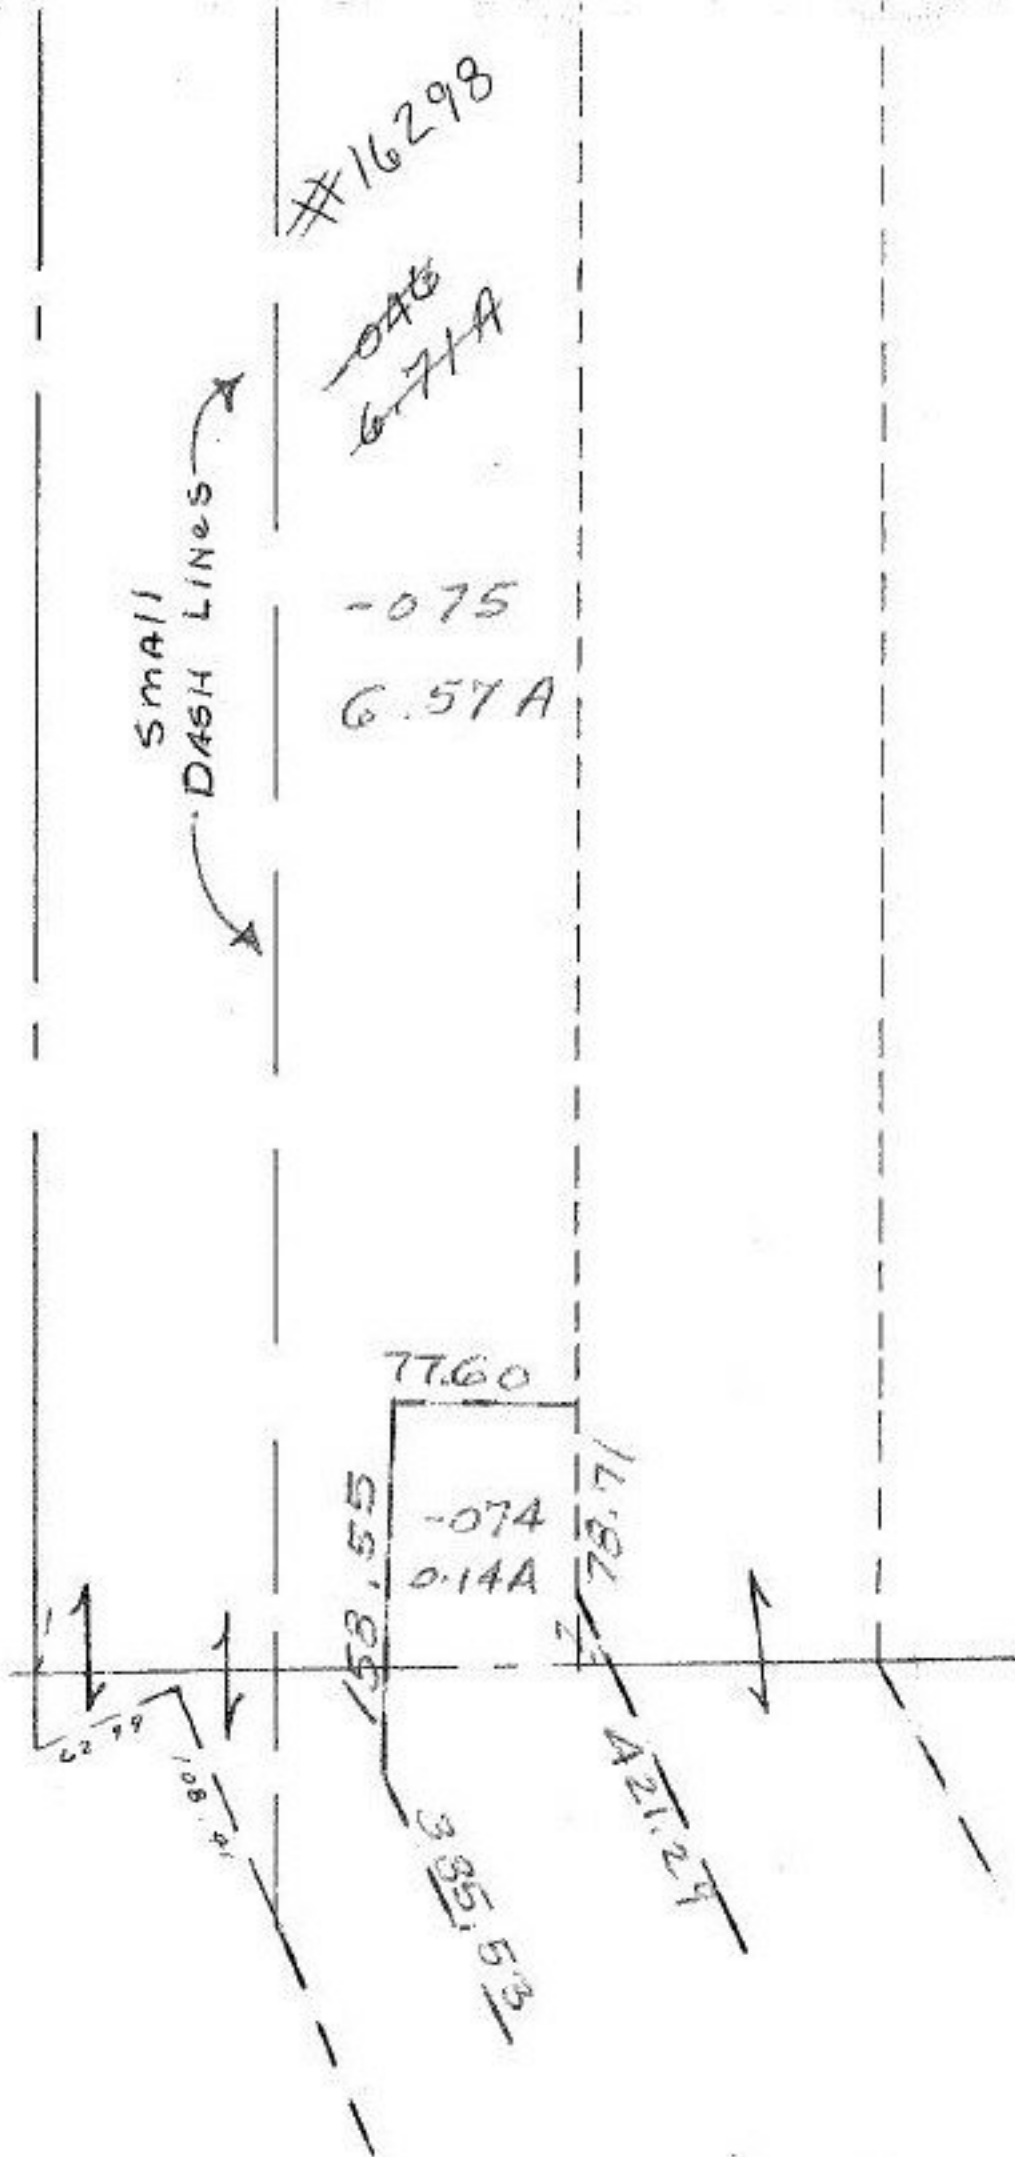

O.L. 79

#16298

APPROVED	
LORAIN CO.	
MAP DEPT.	
DATE	7-31-85
PAGE	5-00-079-A
BY	C. FRANCIS
VOID AFTER	16298

1310

3-21-86

132