

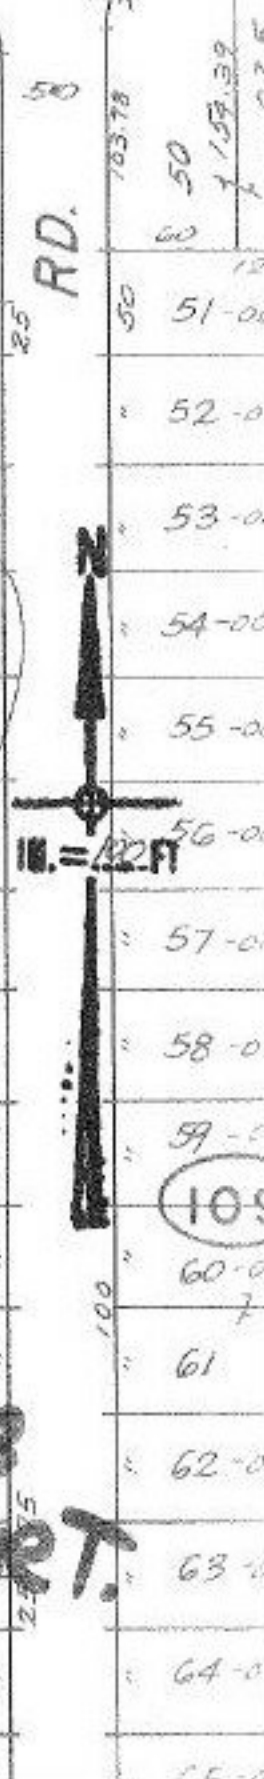


20X161.83

-003  
-56A

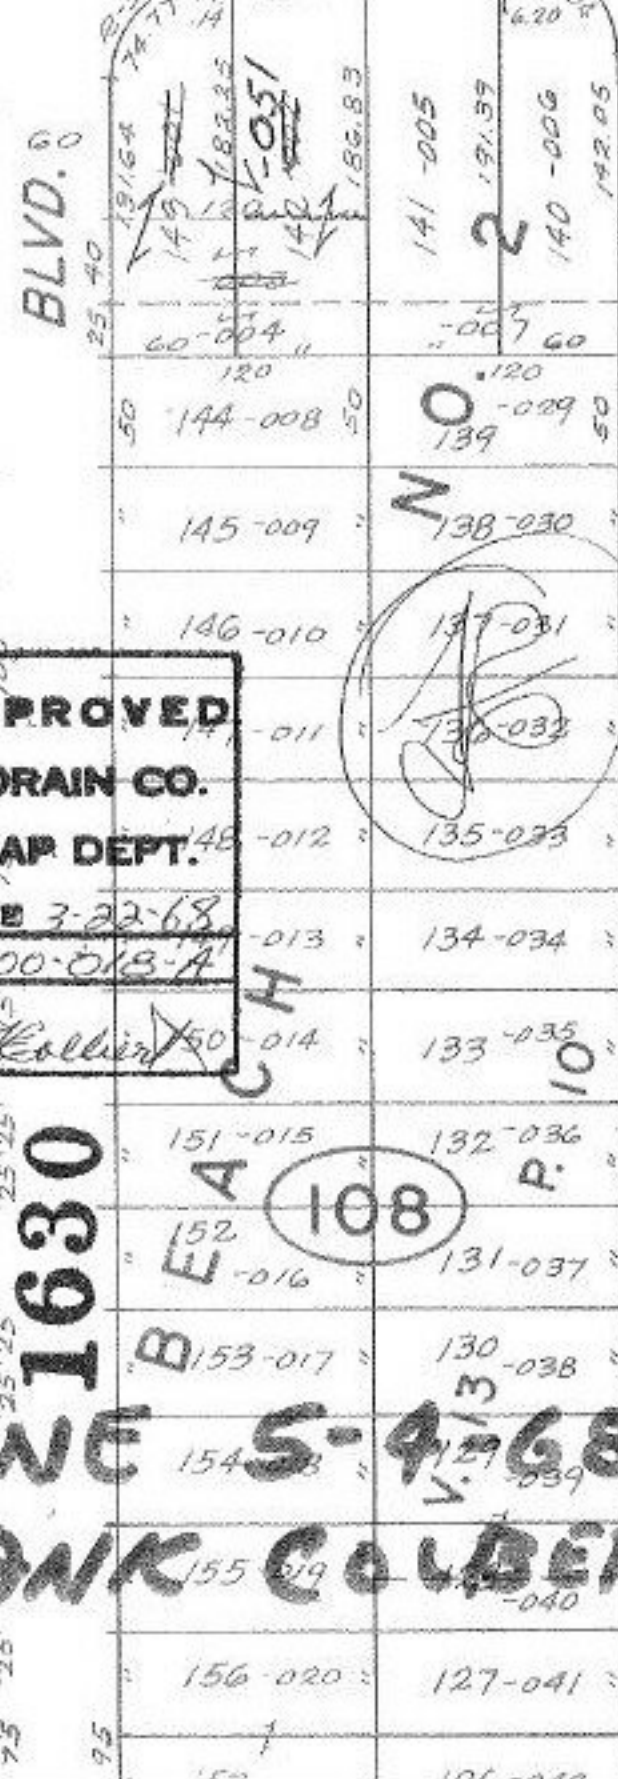

9018-1-9

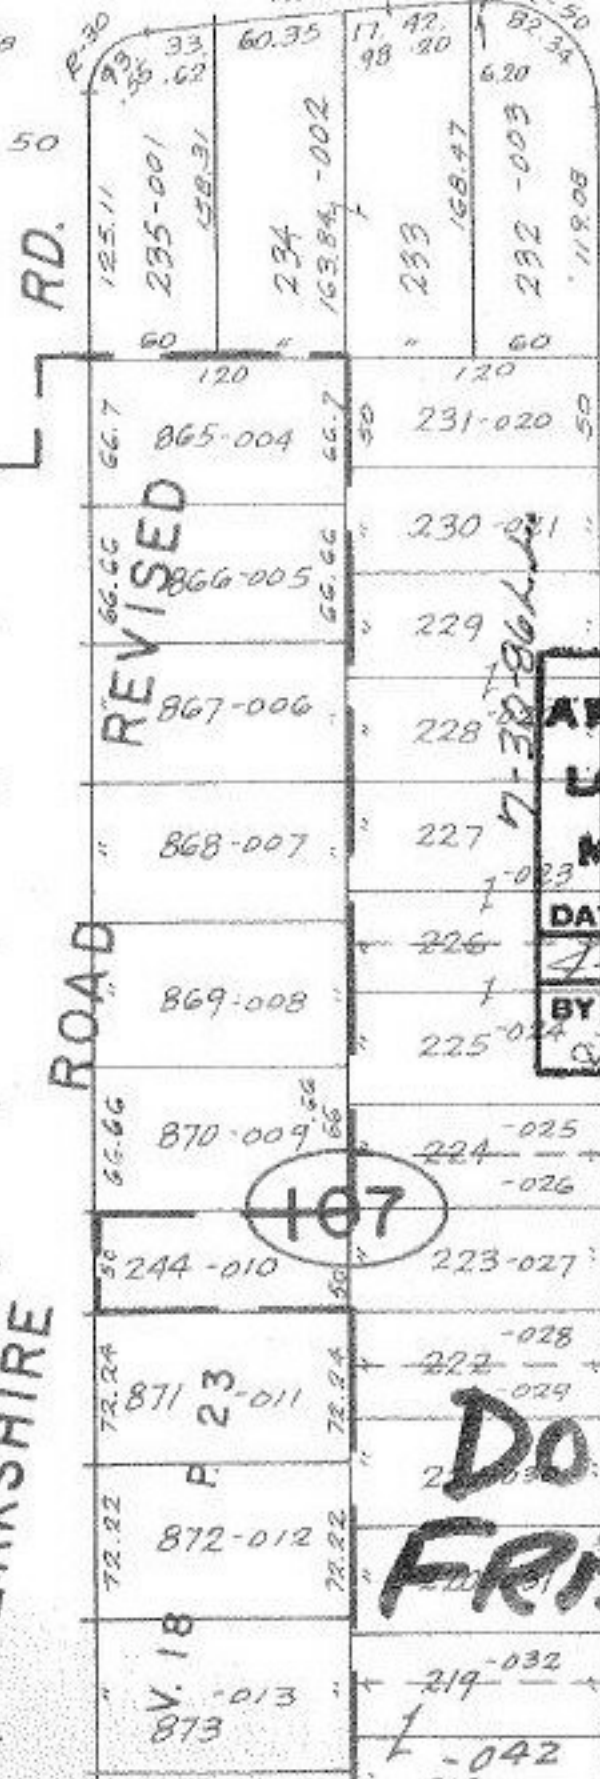

**APPROVED**  
**LORAIN CO.**  
**MAP DEPT.**  
 DATE 3-22-68  
 4-00-018-A  
 BY *Kellin*

107

108

109

**DONE 5-9-68**  
**FRANK COLBERT**