

APPROVED  
LORAIN CO.  
MAP DEPT.

DATE 3-25-68

400-030-C

BY

*Colbert*


7-15-86 8MB



11-25-89  
LORAIN

1030

E r i

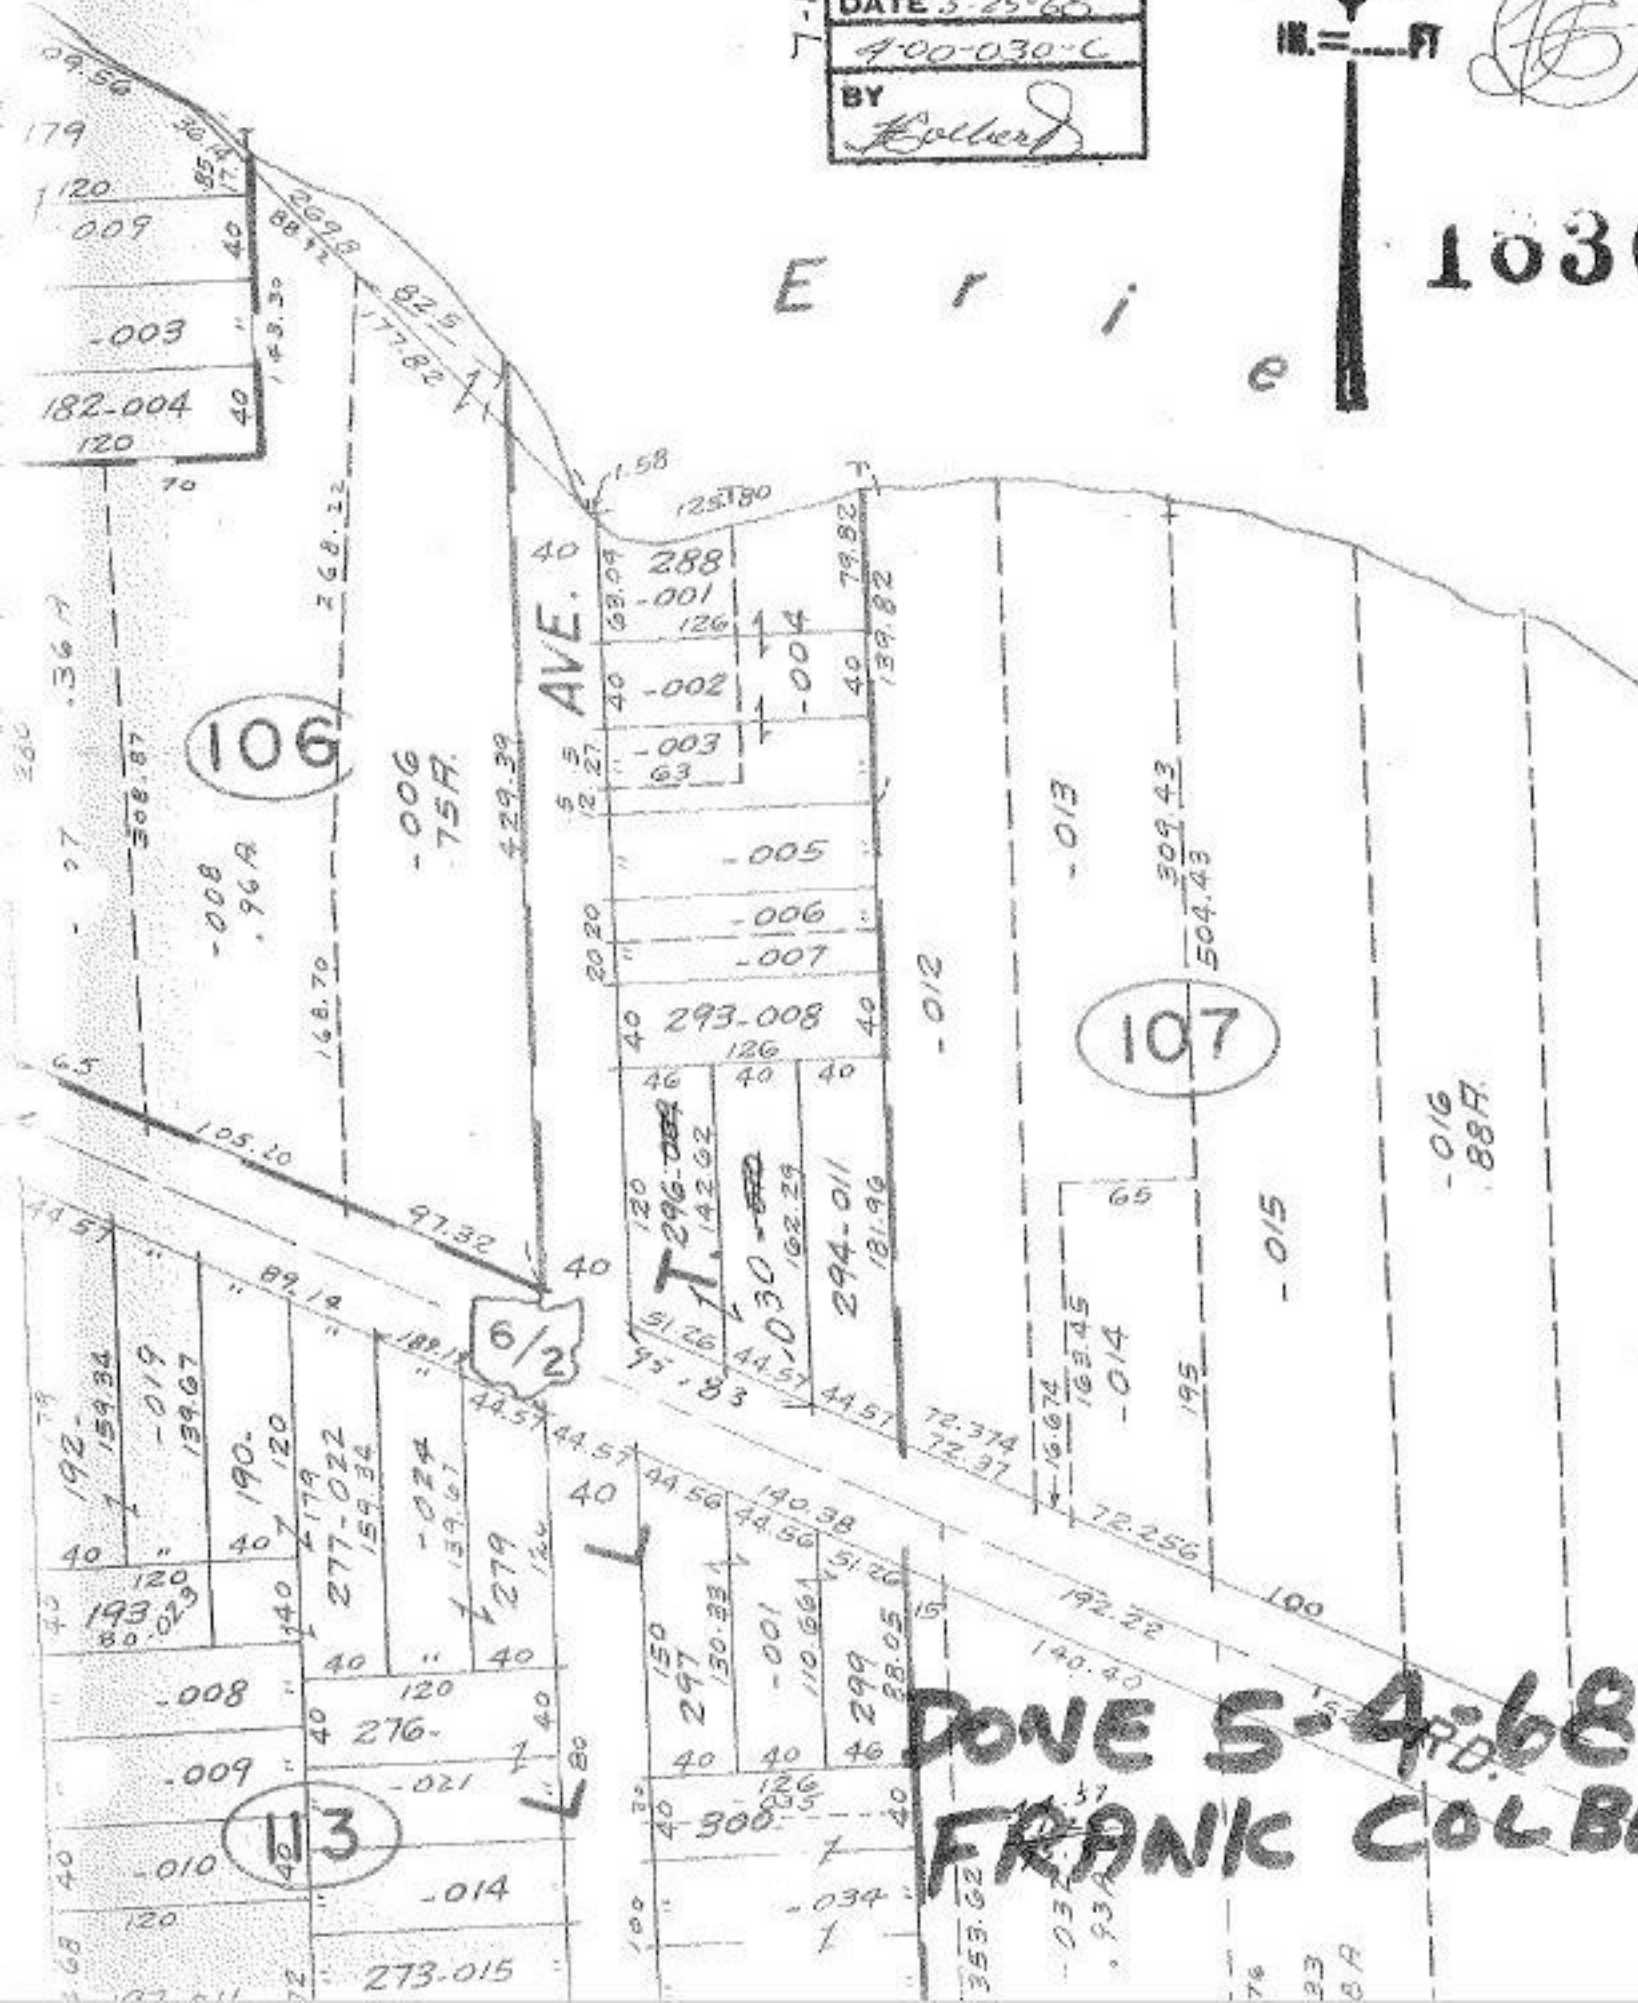

DONE 5-4-68  
FRANK COLBERT