


PORTMAN

RD.

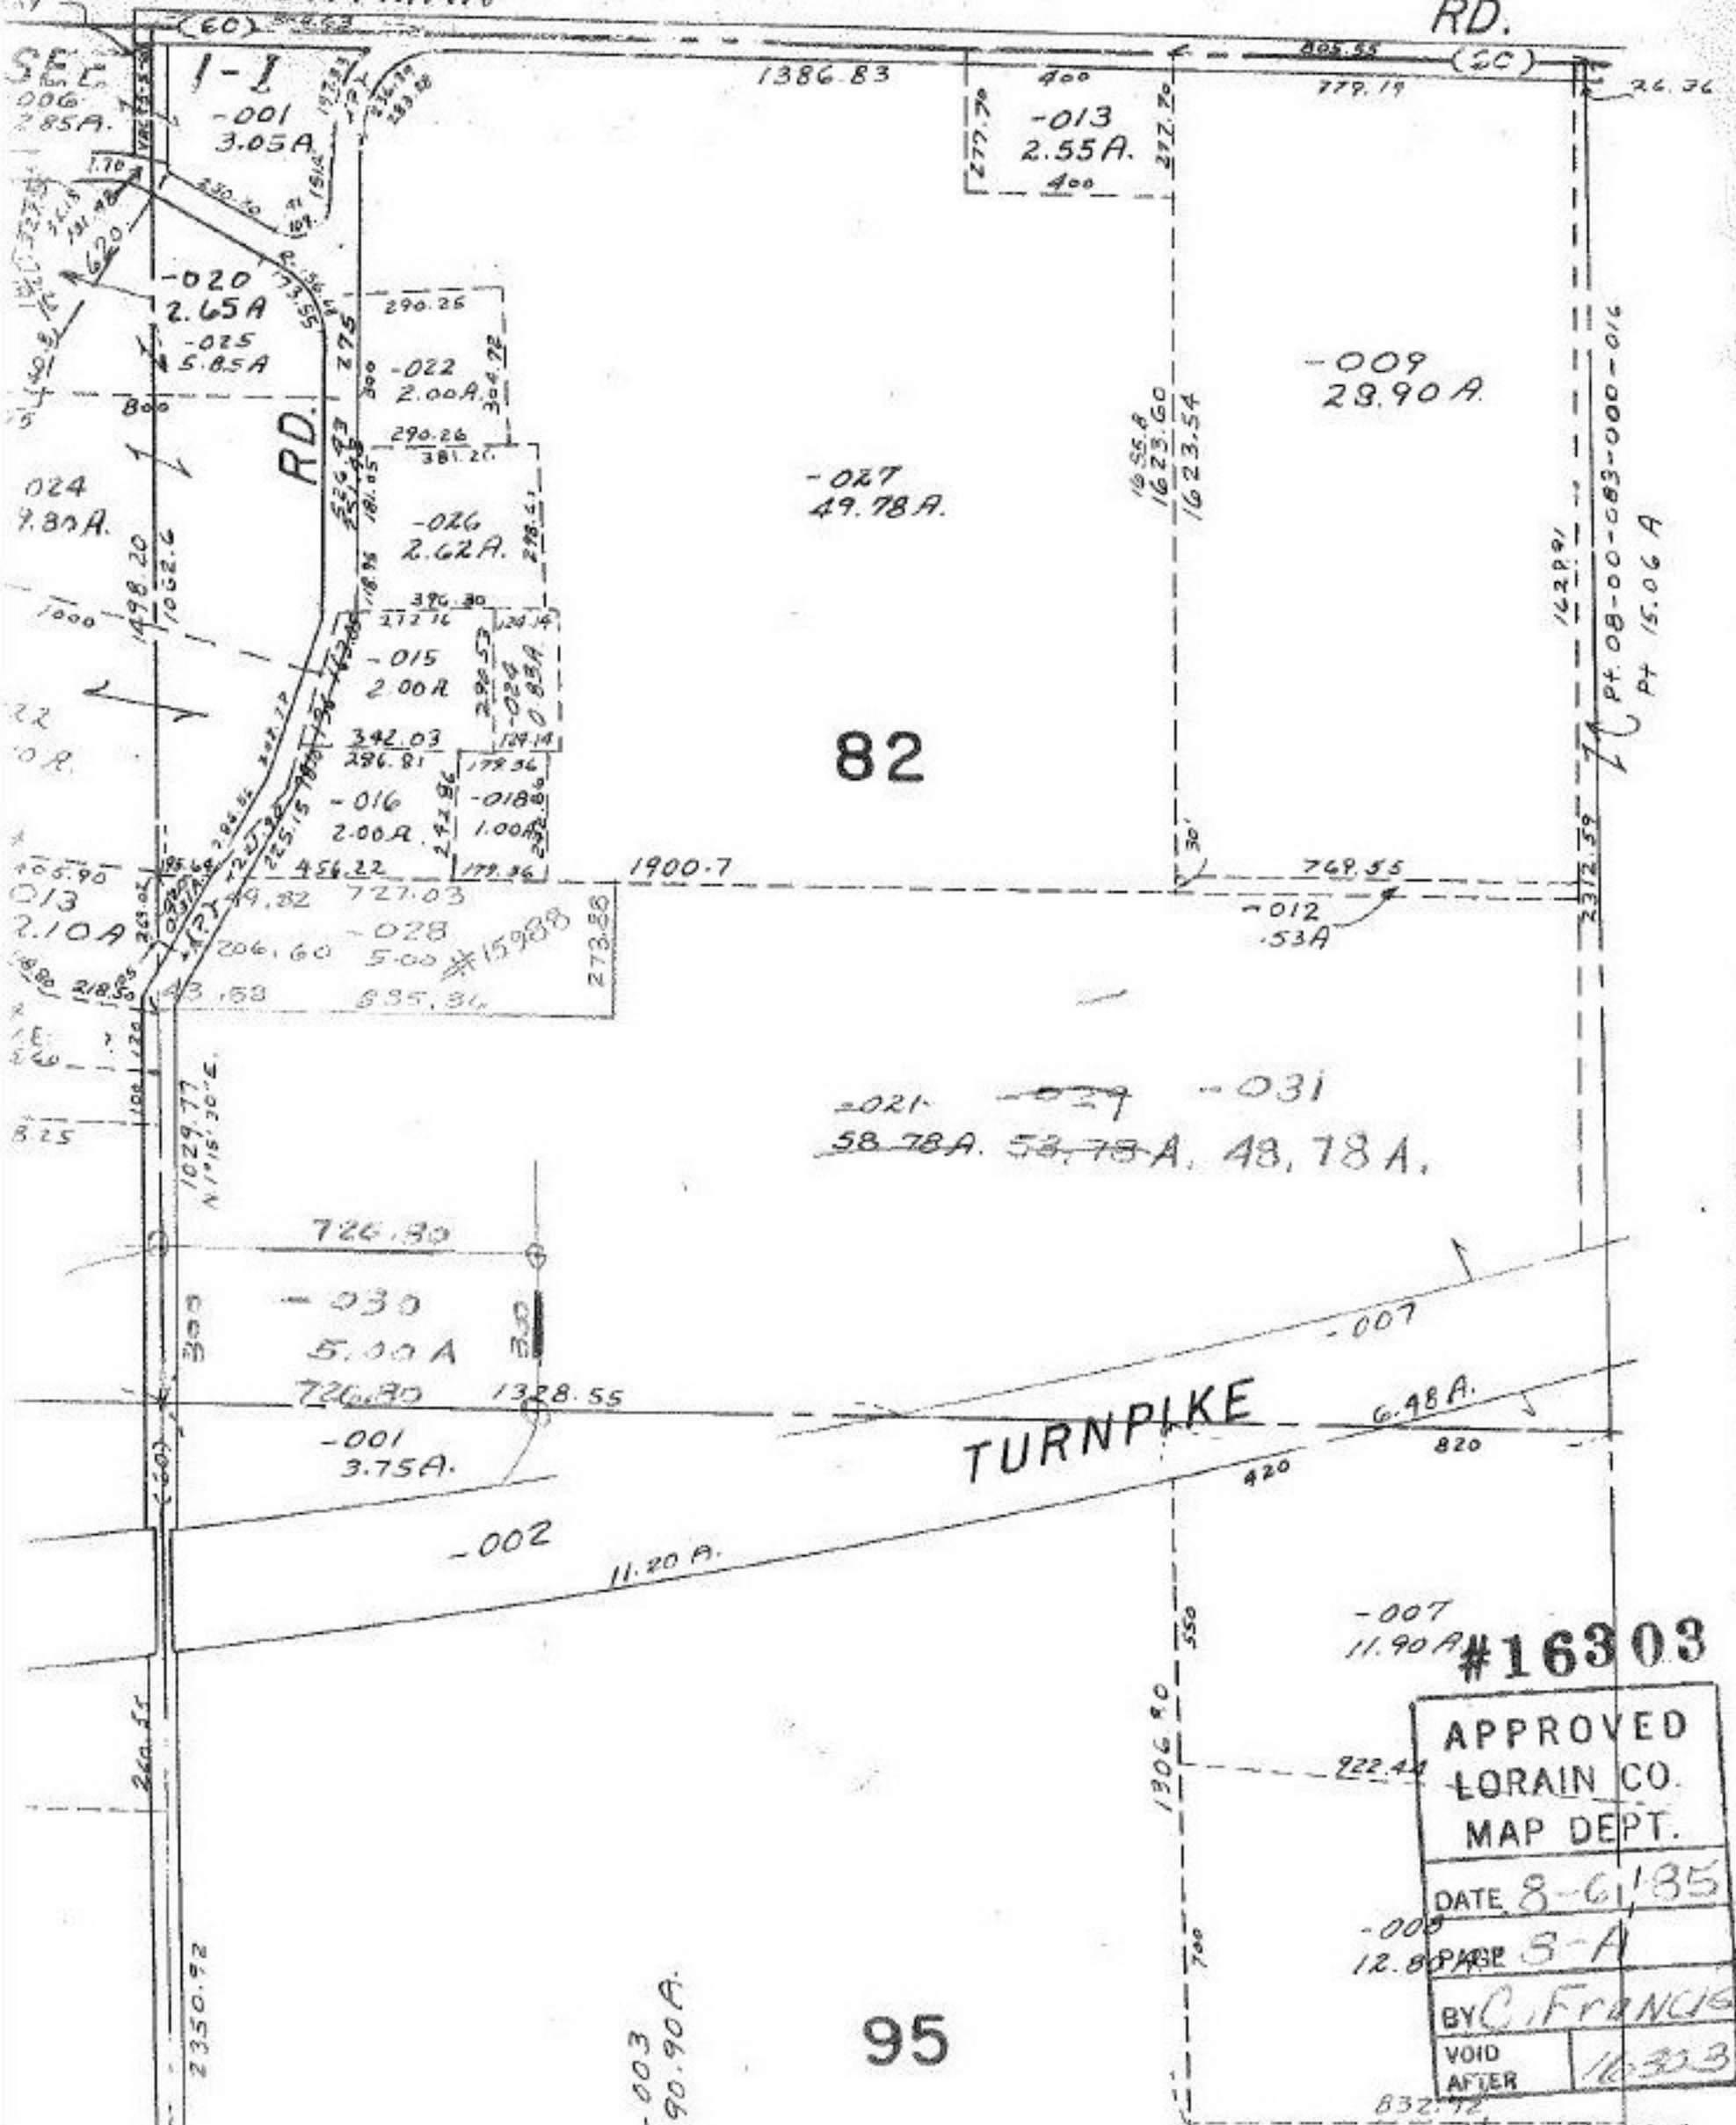

82

-021 -029 -031  
58.78A. 53.78A. 48.78A.

95

#16303

APPROVED	
LORAIN CO.	
MAP DEPT.	
DATE 8-6-185	
PAGE 3-A	
BY C. FRANCIS	
VOID	16303
AFTER	

1623.54  
1623.60  
1655.8  
1623.70  
1623.54  
1623.59  
1623.59  
Pt. 08-00-083-000-016  
Pt 15.06 A

1-1  
-001  
3.05A  
-020  
2.65A  
-025  
5.85A  
-022  
2.00A  
-026  
2.62A  
-015  
2.00A  
-016  
2.00A  
-018  
1.00A  
-028  
5.00  
-030  
5.00A  
-001  
3.75A  
-002  
11.20 A.  
-007  
6.48A.  
-007  
11.90A  
-008  
12.8

1029.77  
N 1° 15' 30" E.  
726.80  
726.80  
1328.55  
2350.72  
-003  
90.90A.

1386.83  
400  
-013  
2.55A.  
400  
277.70  
277.70  
779.19  
26.76  
290.26  
290.26  
381.27  
396.80  
272.76  
342.03  
286.81  
456.22  
1900.7  
749.55  
-012  
.53A  
1900.7  
749.55  
-021  
58.78A.  
-029  
53.78A.  
-031  
48.78A.  
726.80  
1328.55  
420  
820  
1306.90  
550  
700  
832.72  
832.72