

1442 27

- 021
9.94 A


1443 23

465

- 053
1.39 A

125

355

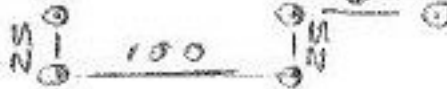

~~228~~
~~10.20 A~~

- 054
9.21 A

1444 25

#16304

APPROVED
LORAIN CO.
MAP DEPT.

DATE 8-7-85

PAGE 11-00-024 A

BY C. FRANCIS

VOID AFTER 16304

4-10-86

300

125

320

SEE 11-U