
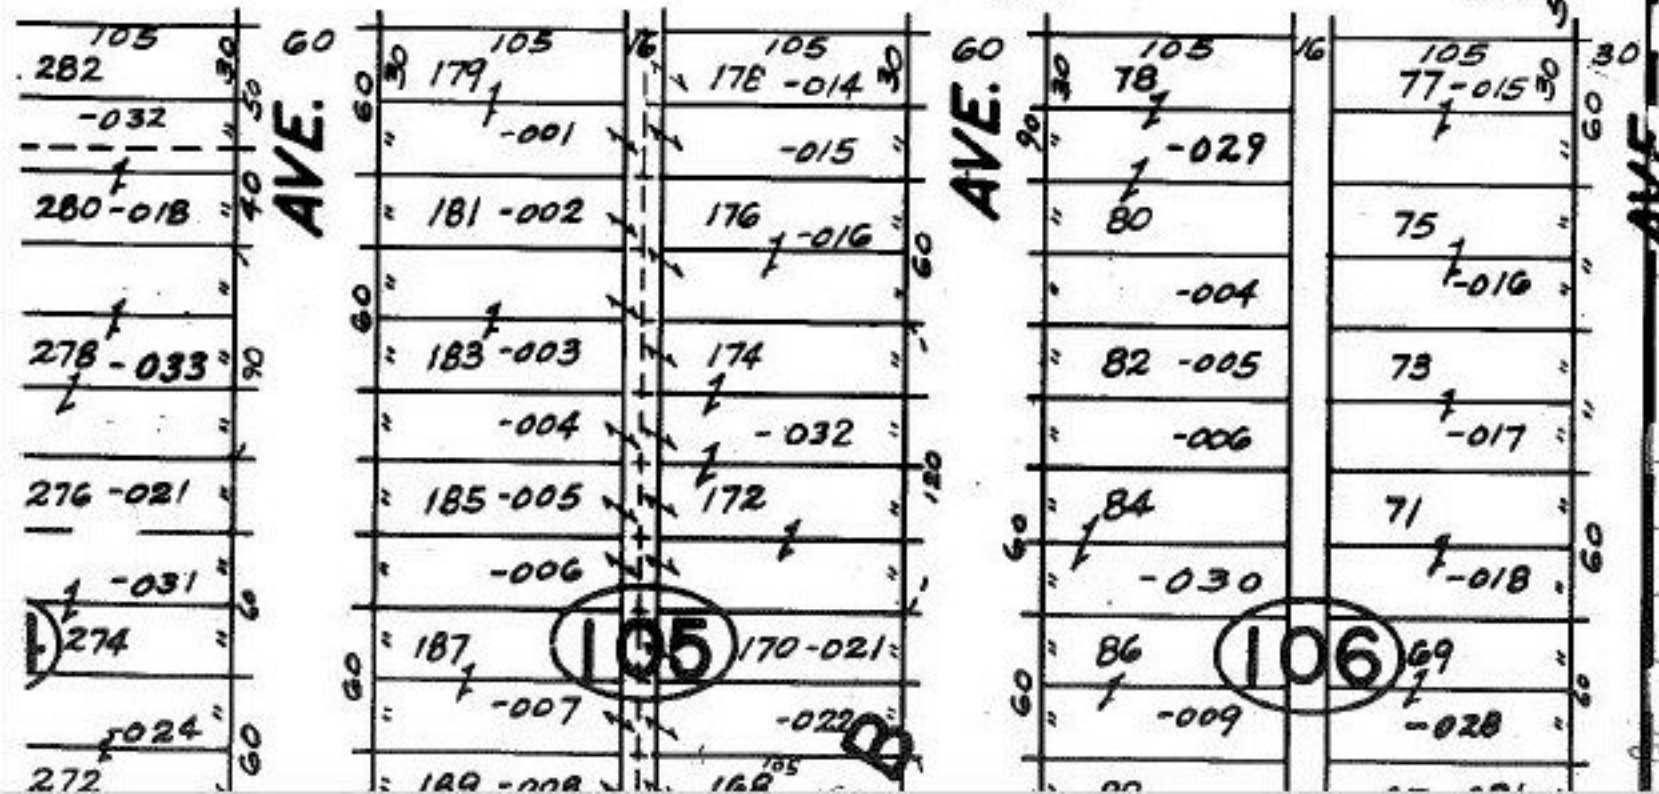


SEE 3-00-077-A

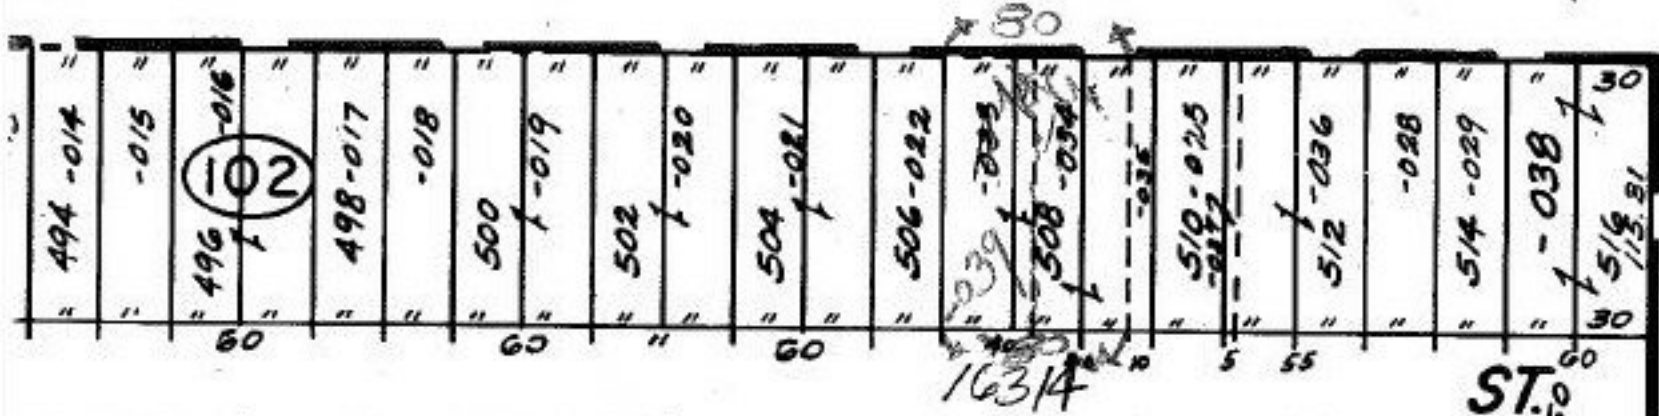

#16314

APPROVED
LORAIN CO.
MAP DEPT.

DATE 3-12-85

PAGE 3-00-075

BY C. Francis

VOID
AFTER 16314

10-11-85