

#16317

MAKE
LINE BREAK
MATCH


019/11
48-25-908

~~P. 089~~
~~Pt. 10.37 A.~~

Pt. 148
Pt. 9.02 A.

#16317

SEE 6-125

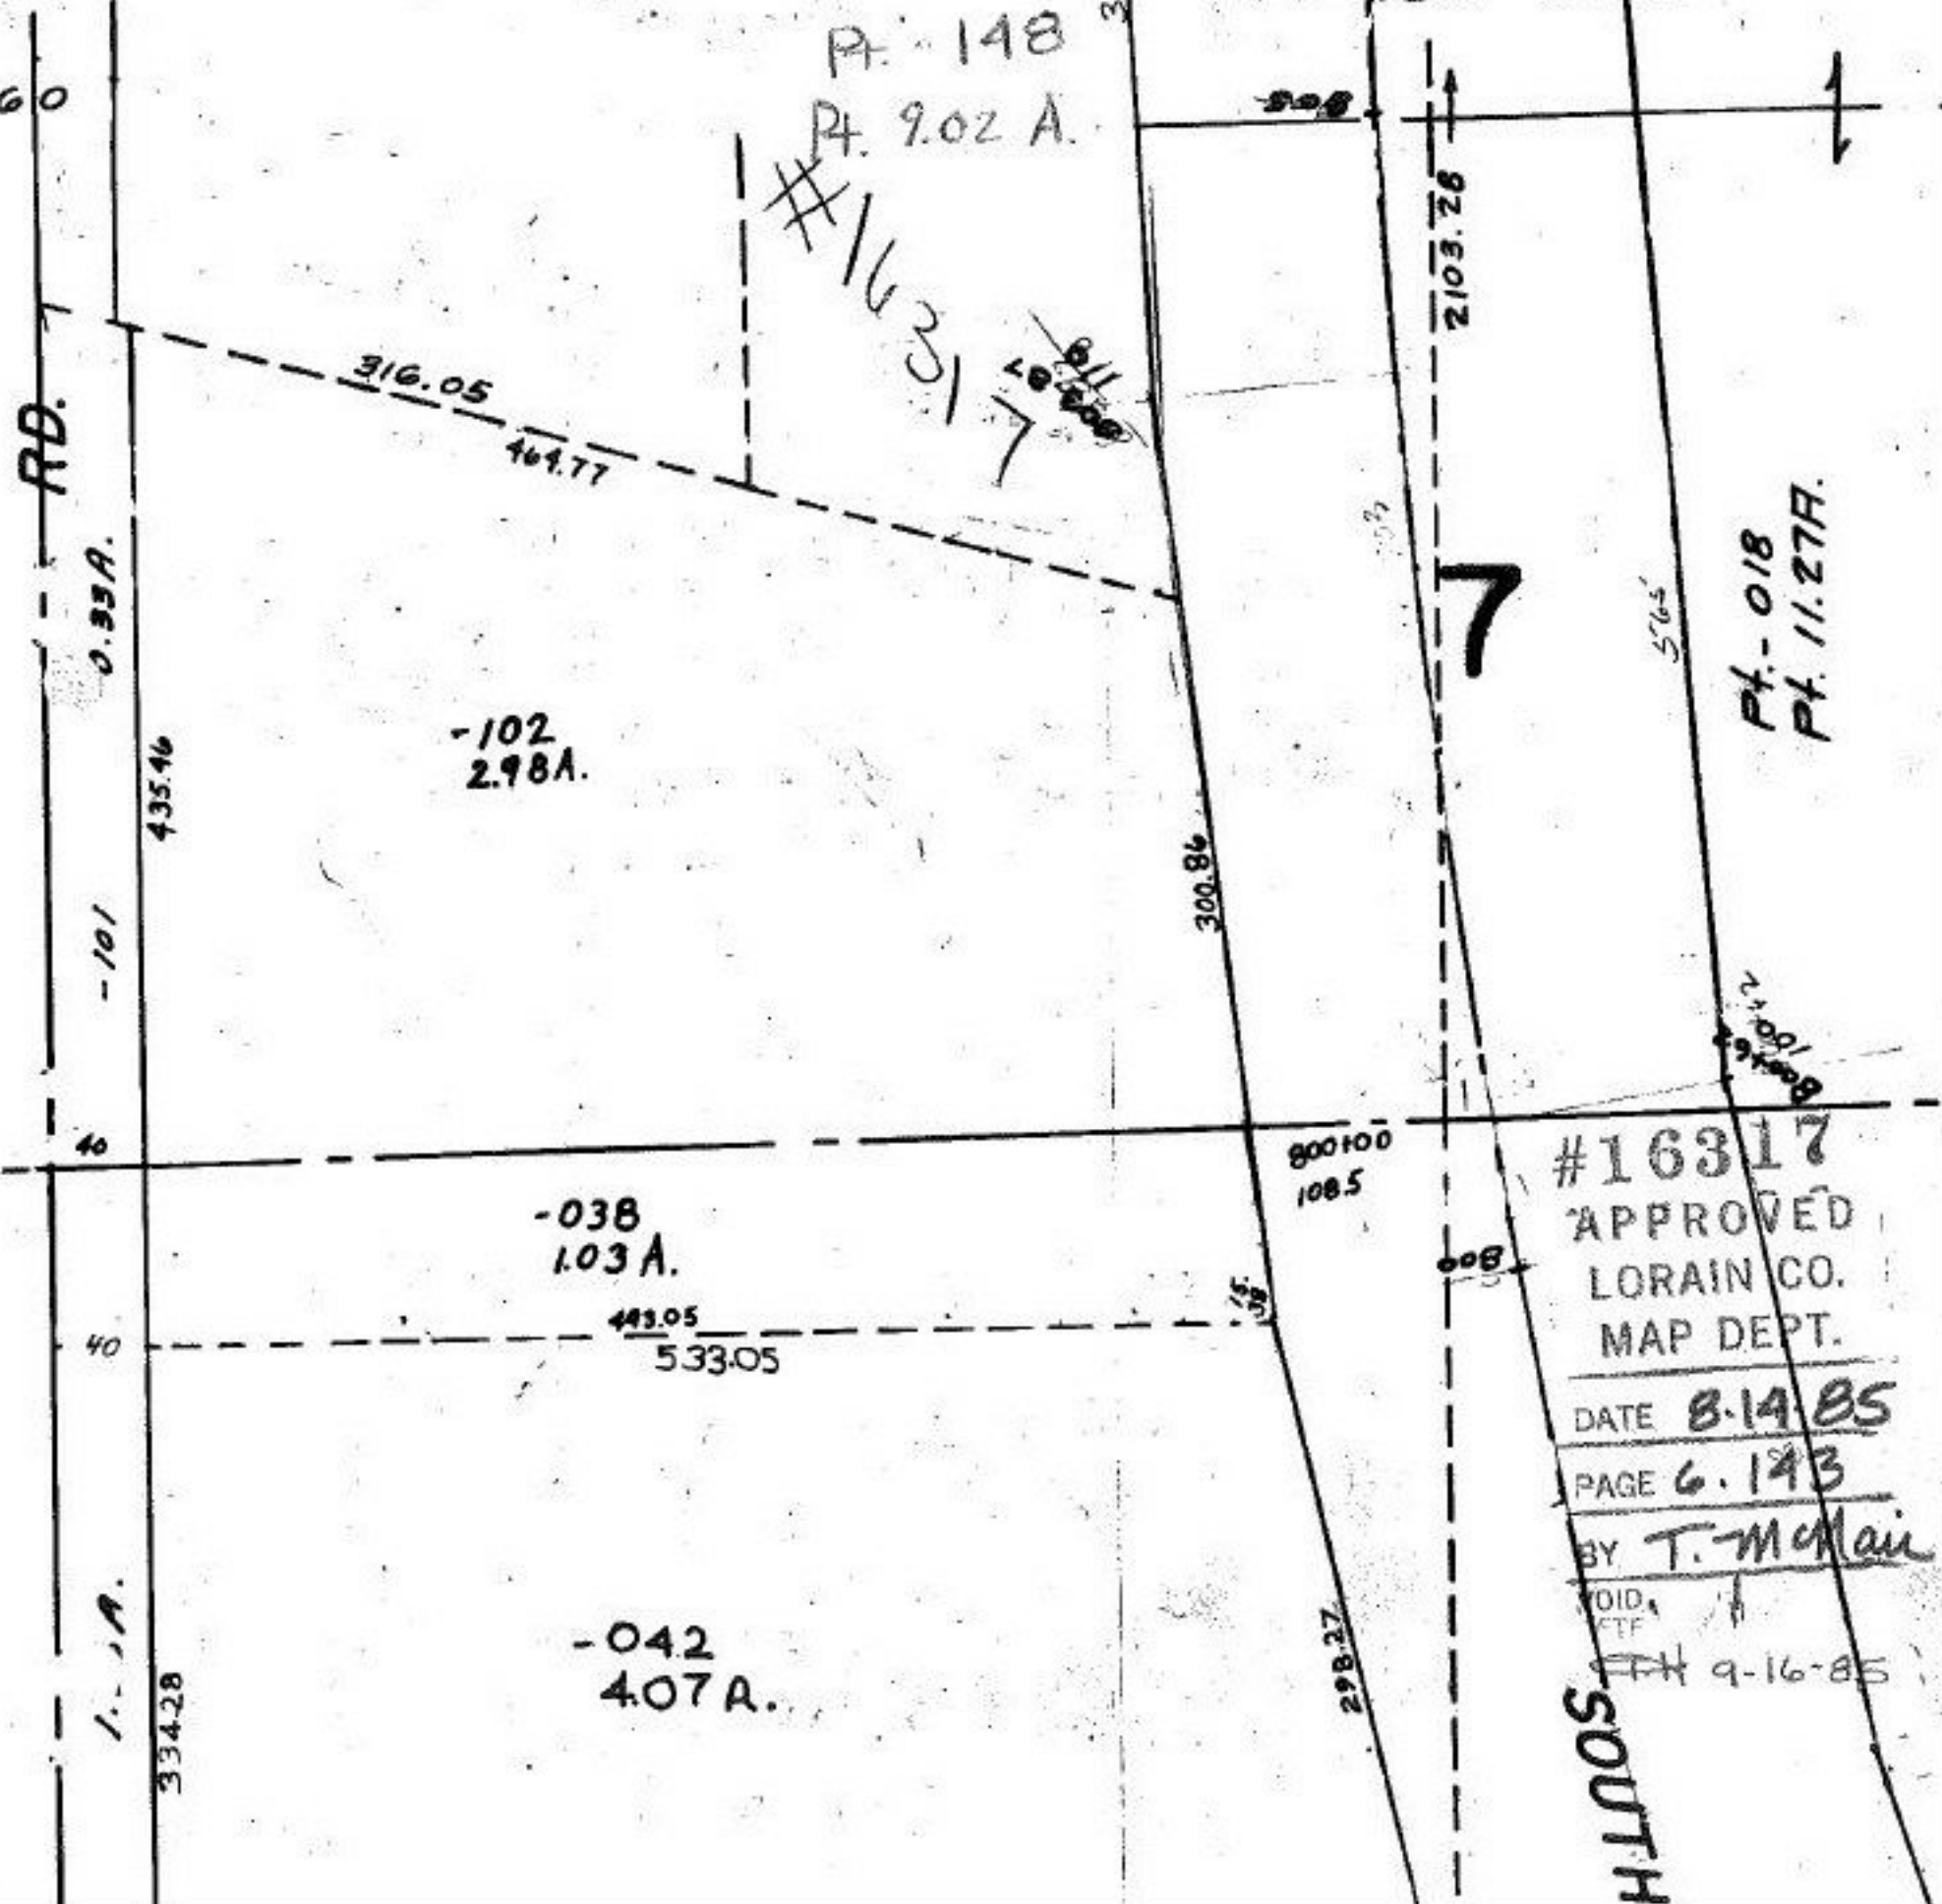

Pt. - 018
Pt. 11.27A.

#16317
APPROVED
LORAIN CO.
MAP DEPT.

DATE 8-14-85

PAGE 6-143

BY T. McLean

VOID, ETC.
9-16-85

SOUTH