

Done Survey


Pt Tax Map Pg
03-00-096A

SEE 3-E

Scale 1" = 100 Ft

1832
APPROVED
LORAIN CO.
MAP DEPT.
DATE 3-28-88
76A
BY *[Signature]*


Pt. 03-00-088-101-002⁰⁰⁸
~~Pt. 3.29A.~~ Pt. 3.26A.

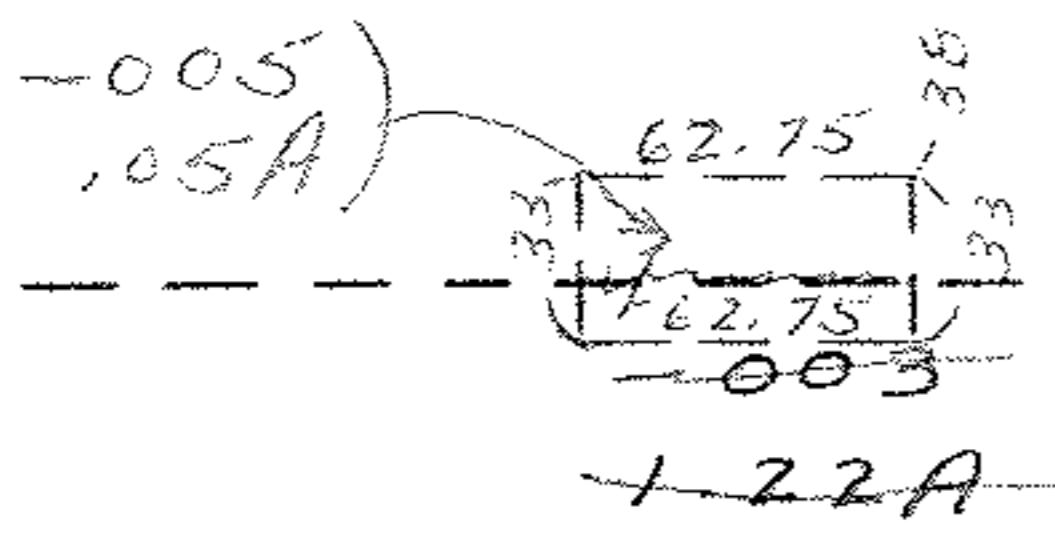

101

102

89

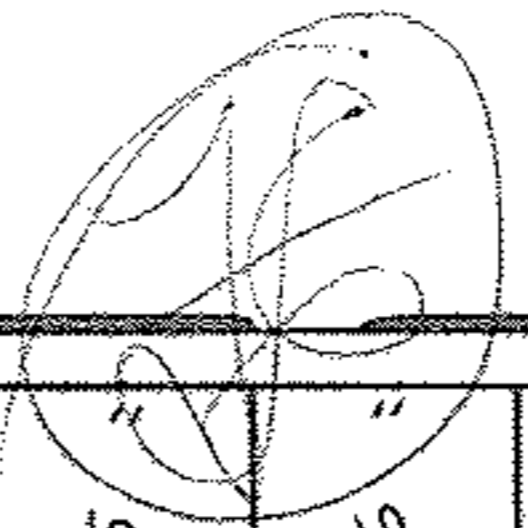

960	961-002	962-003	963-004 25 25	964-006 75	965-007 25	966-008	967-009	968-010	969-011 102	970-012 13.25	971-014	972-015	973-016	974-017	975-018	976-019	977-020	978-021	979-022 50	980-023 40
-----	---------	---------	------------------	---------------	---------------	---------	---------	---------	----------------	------------------	---------	---------	---------	---------	---------	---------	---------	---------	---------------	---------------

28th

ST. 80 to Pearl

1047-005	1046-006	1045-007	1044-008	1043-009	1042-010	1041-011 40.60 26.23	1040-012	1040-013	1039-014	1038-015	1037-016	1036-017	1035-018	1034-019	1033-020	1032-021 100	1031-022	1029-023	1028-024 125	1027-025
----------	----------	----------	----------	----------	----------	----------------------------	----------	----------	----------	----------	----------	----------	----------	----------	----------	-----------------	----------	----------	-----------------	----------

AVE.