


SEE SPLIT # 16318

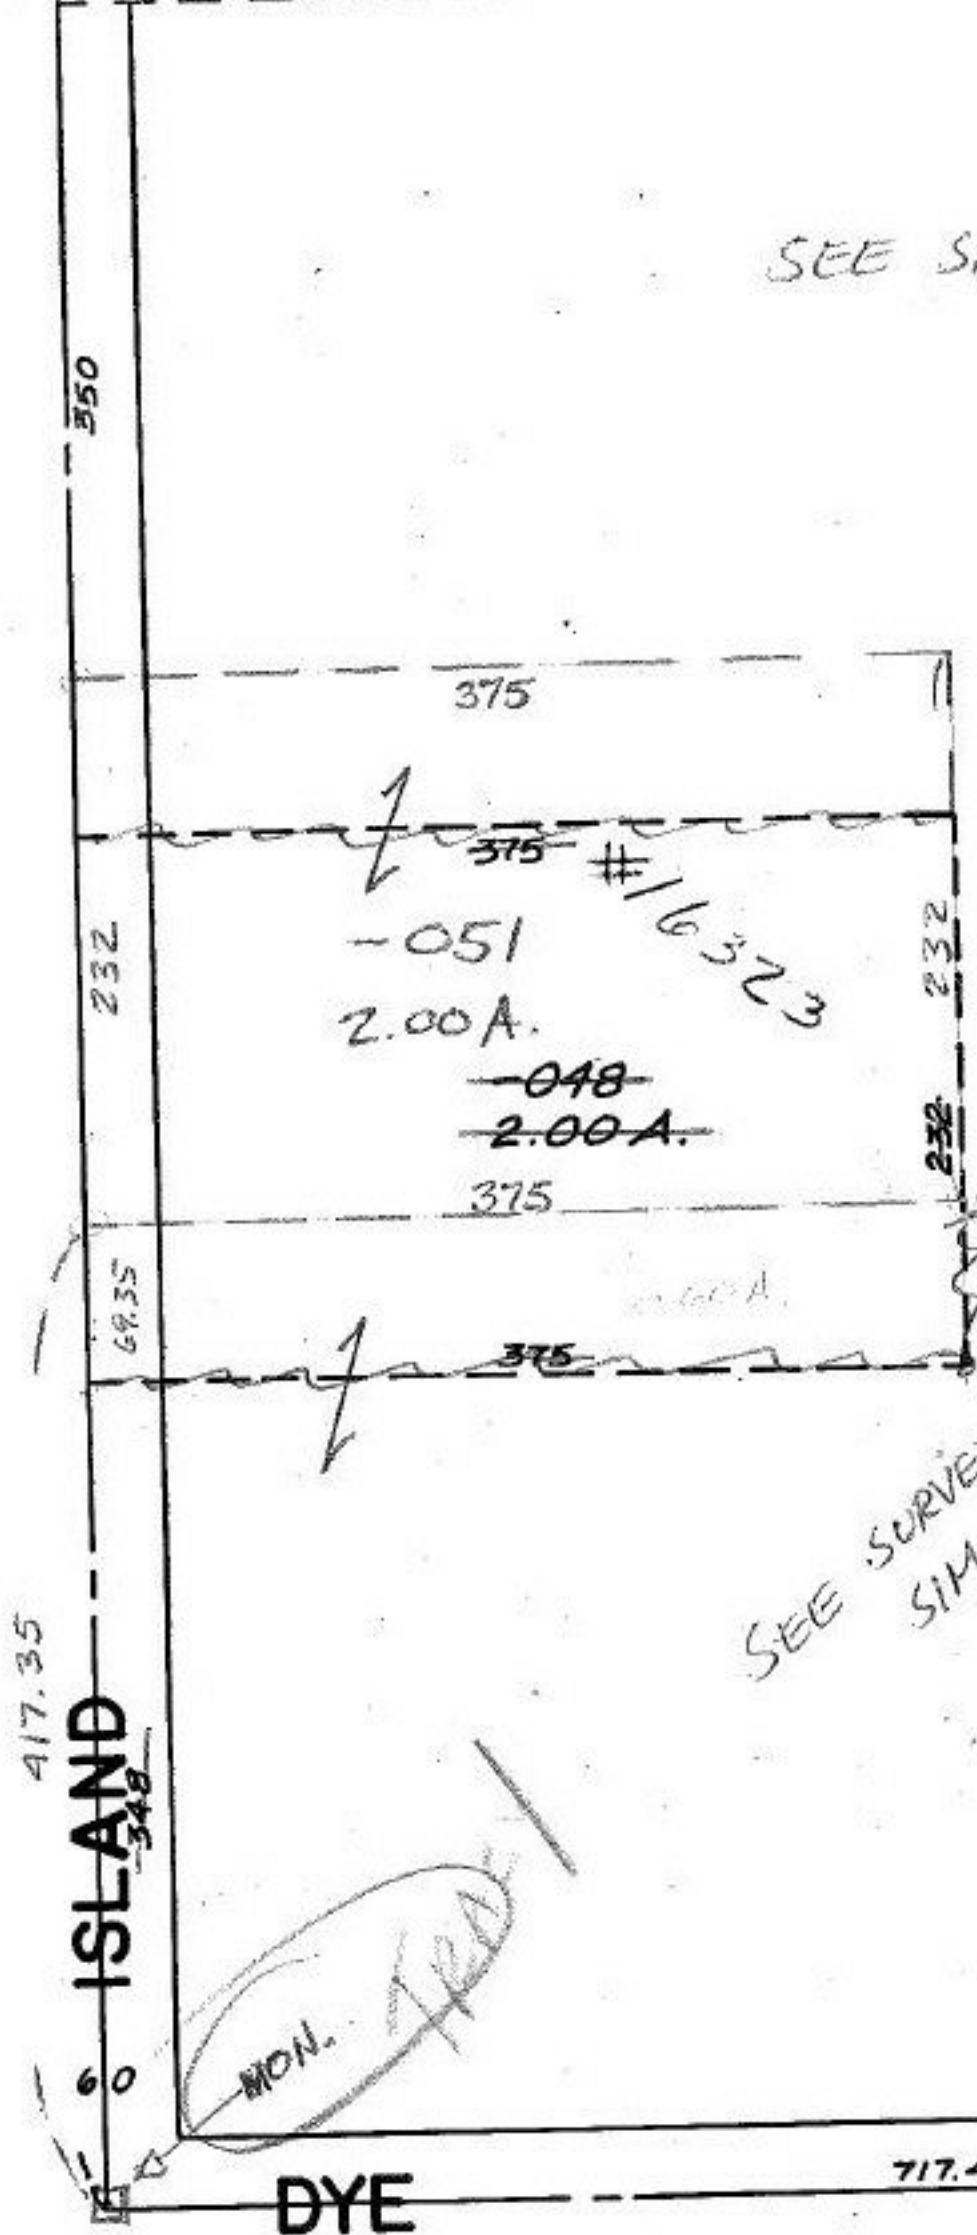

-050
22.04 A.
-052
22.04 A.

SEE SURVEY - LAUNNON
SIMON. CAHL & ASSOC.
EL. 1:∞

600-001
8x10

417.35
ISLAND
348

DYE

717.48

#16323

APPROVED
LORAIN CO.
MAP DEPT

DATE 8-15-85

PAGE 11-00-029-A

BY T. McLean

VOID
METERS

4-11-86