

6-9-5106

104


-013
13.07A.



#1633
APPROVED
LORAIN CO.
MAP DEPT.
 DATE 3-22-68
 7-00-044-D
 BY *D. Maynard*


98-98-51-L

DATE 5/4/68

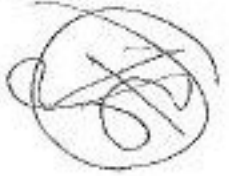

W. Kochis

516.66

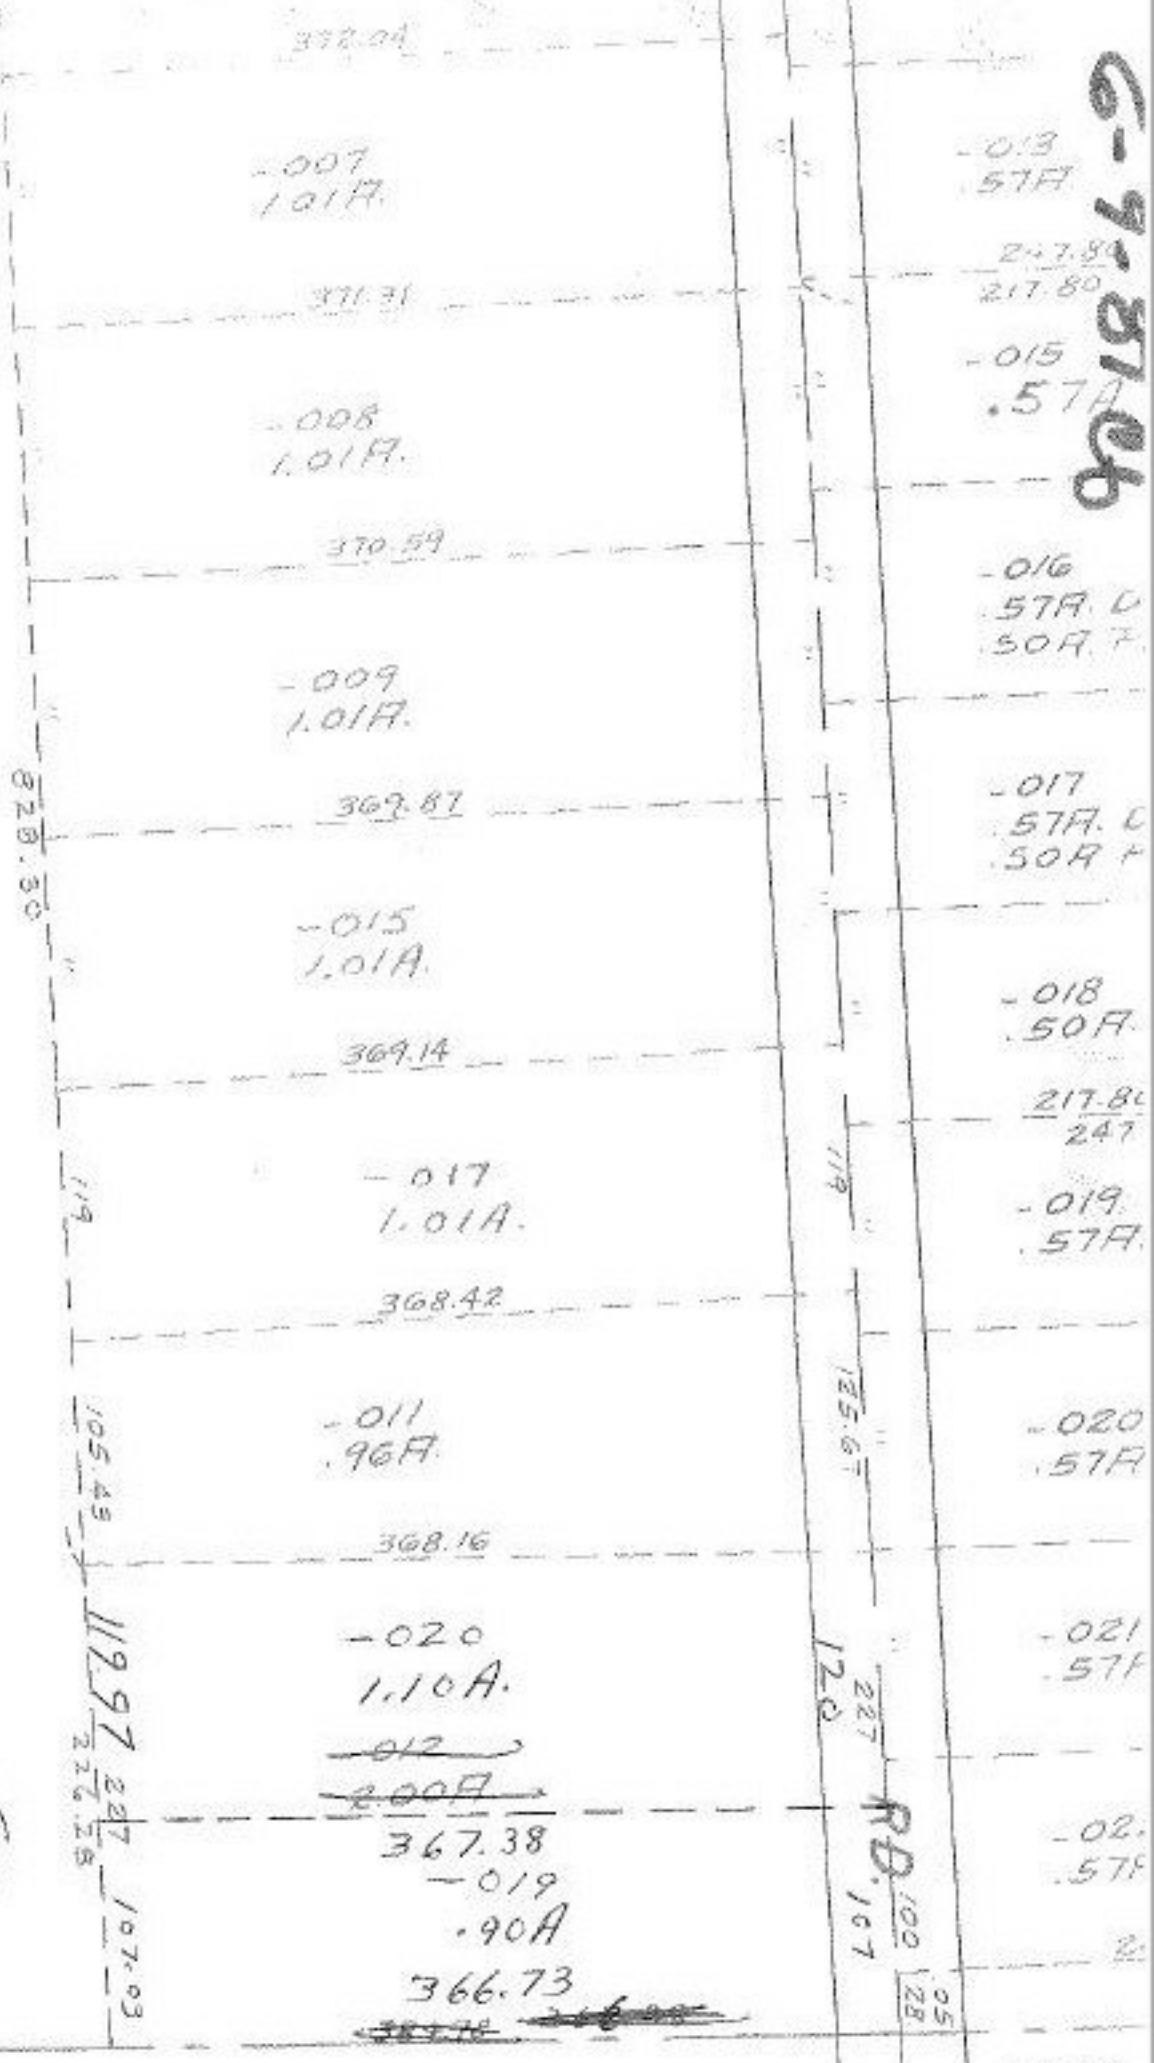

SEE