



SEE 5-00-023-B

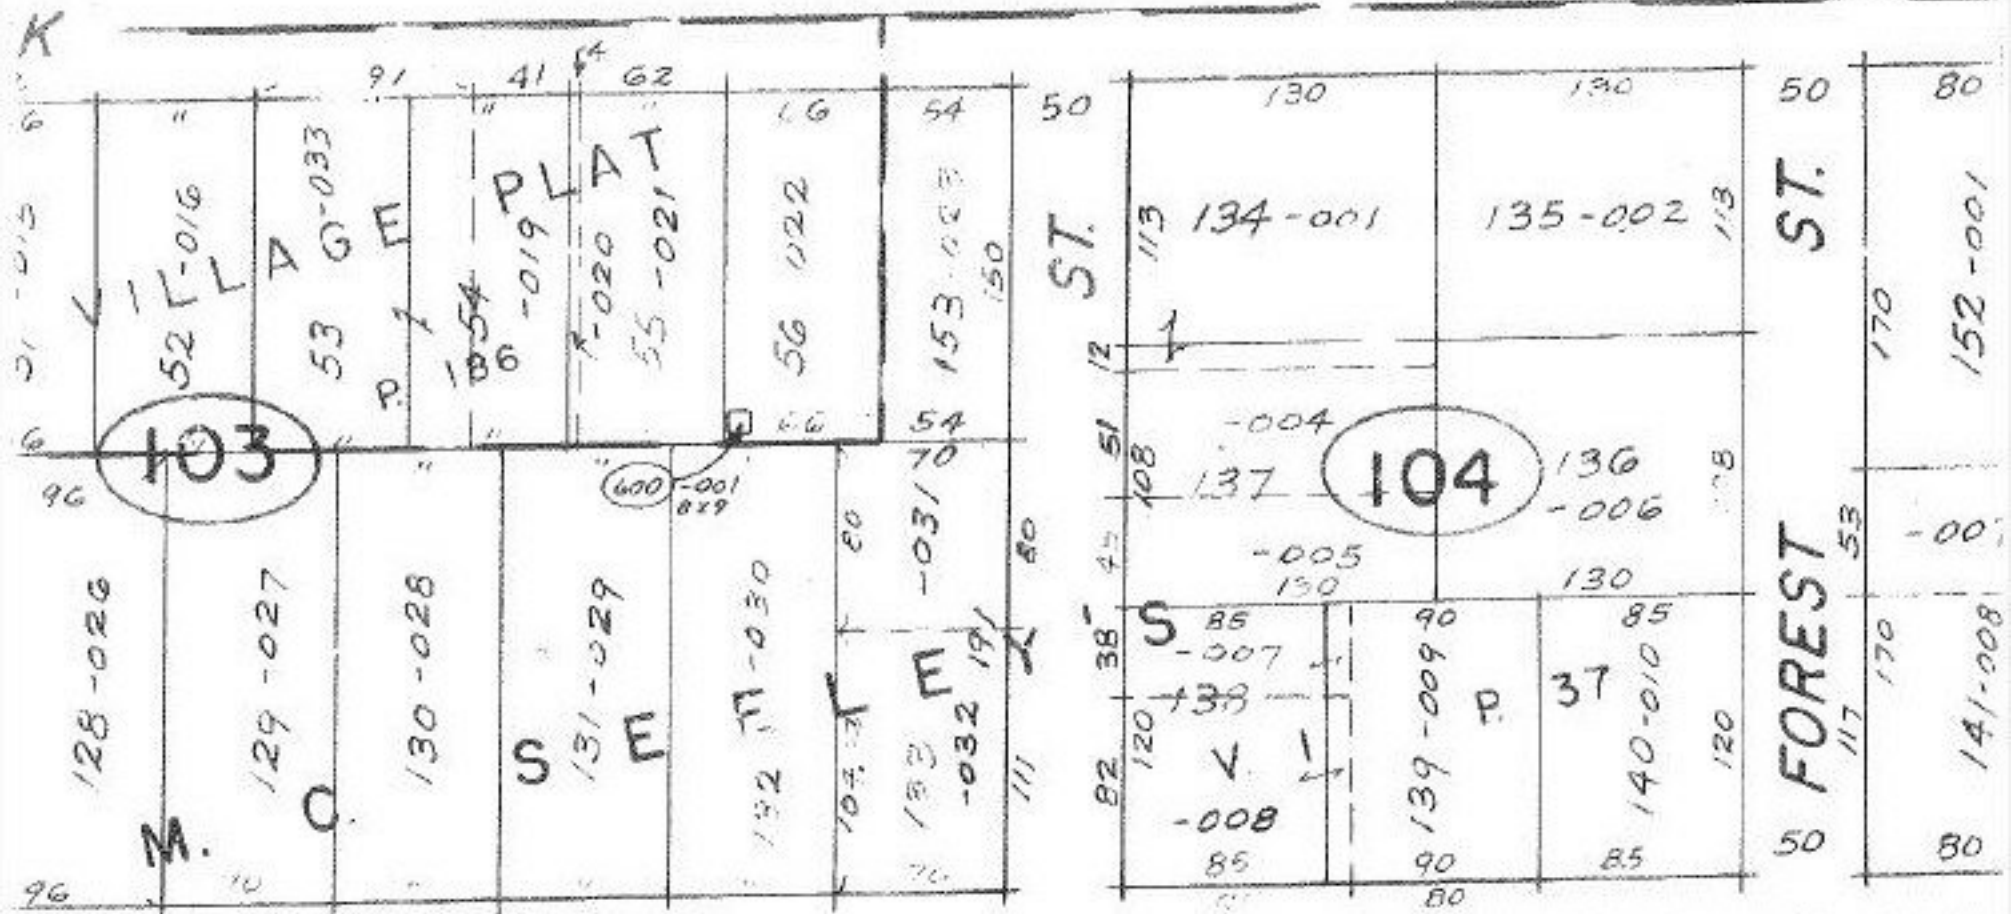

TENNEY

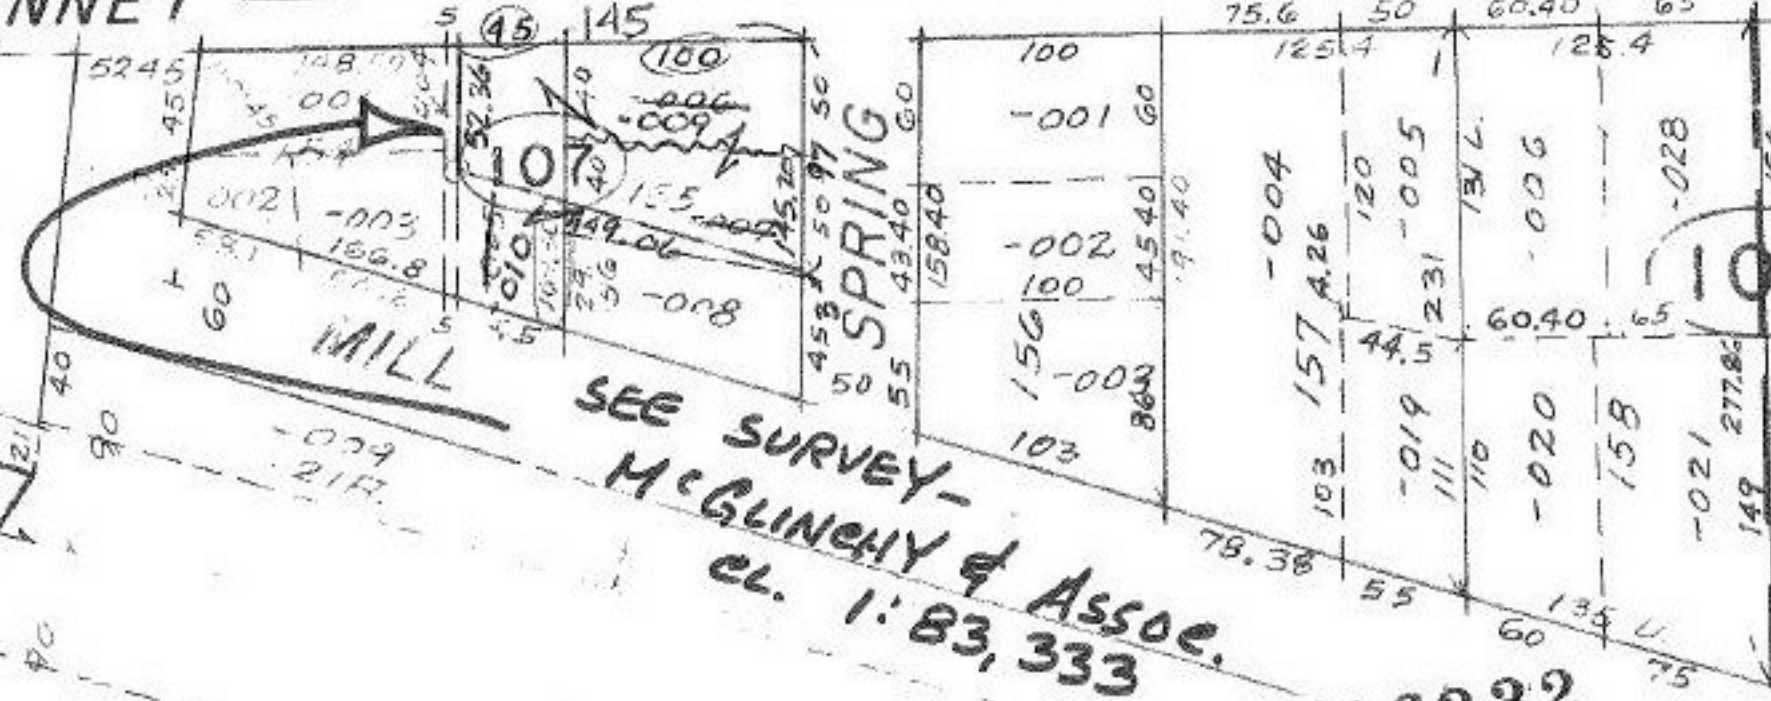

SEE SURVEY - MCGLINEY & ASSOC. CL. 1:83,333

MAPLE

#16332
 APPROVED
 LORAIN CO.
 MAP DEPT.
 DATE 8-22-85
 PAGE 500-024-B
 BY T. McMain
 VOID
 331-86

500