


17

Pt.-006  
A.17.13A.

102

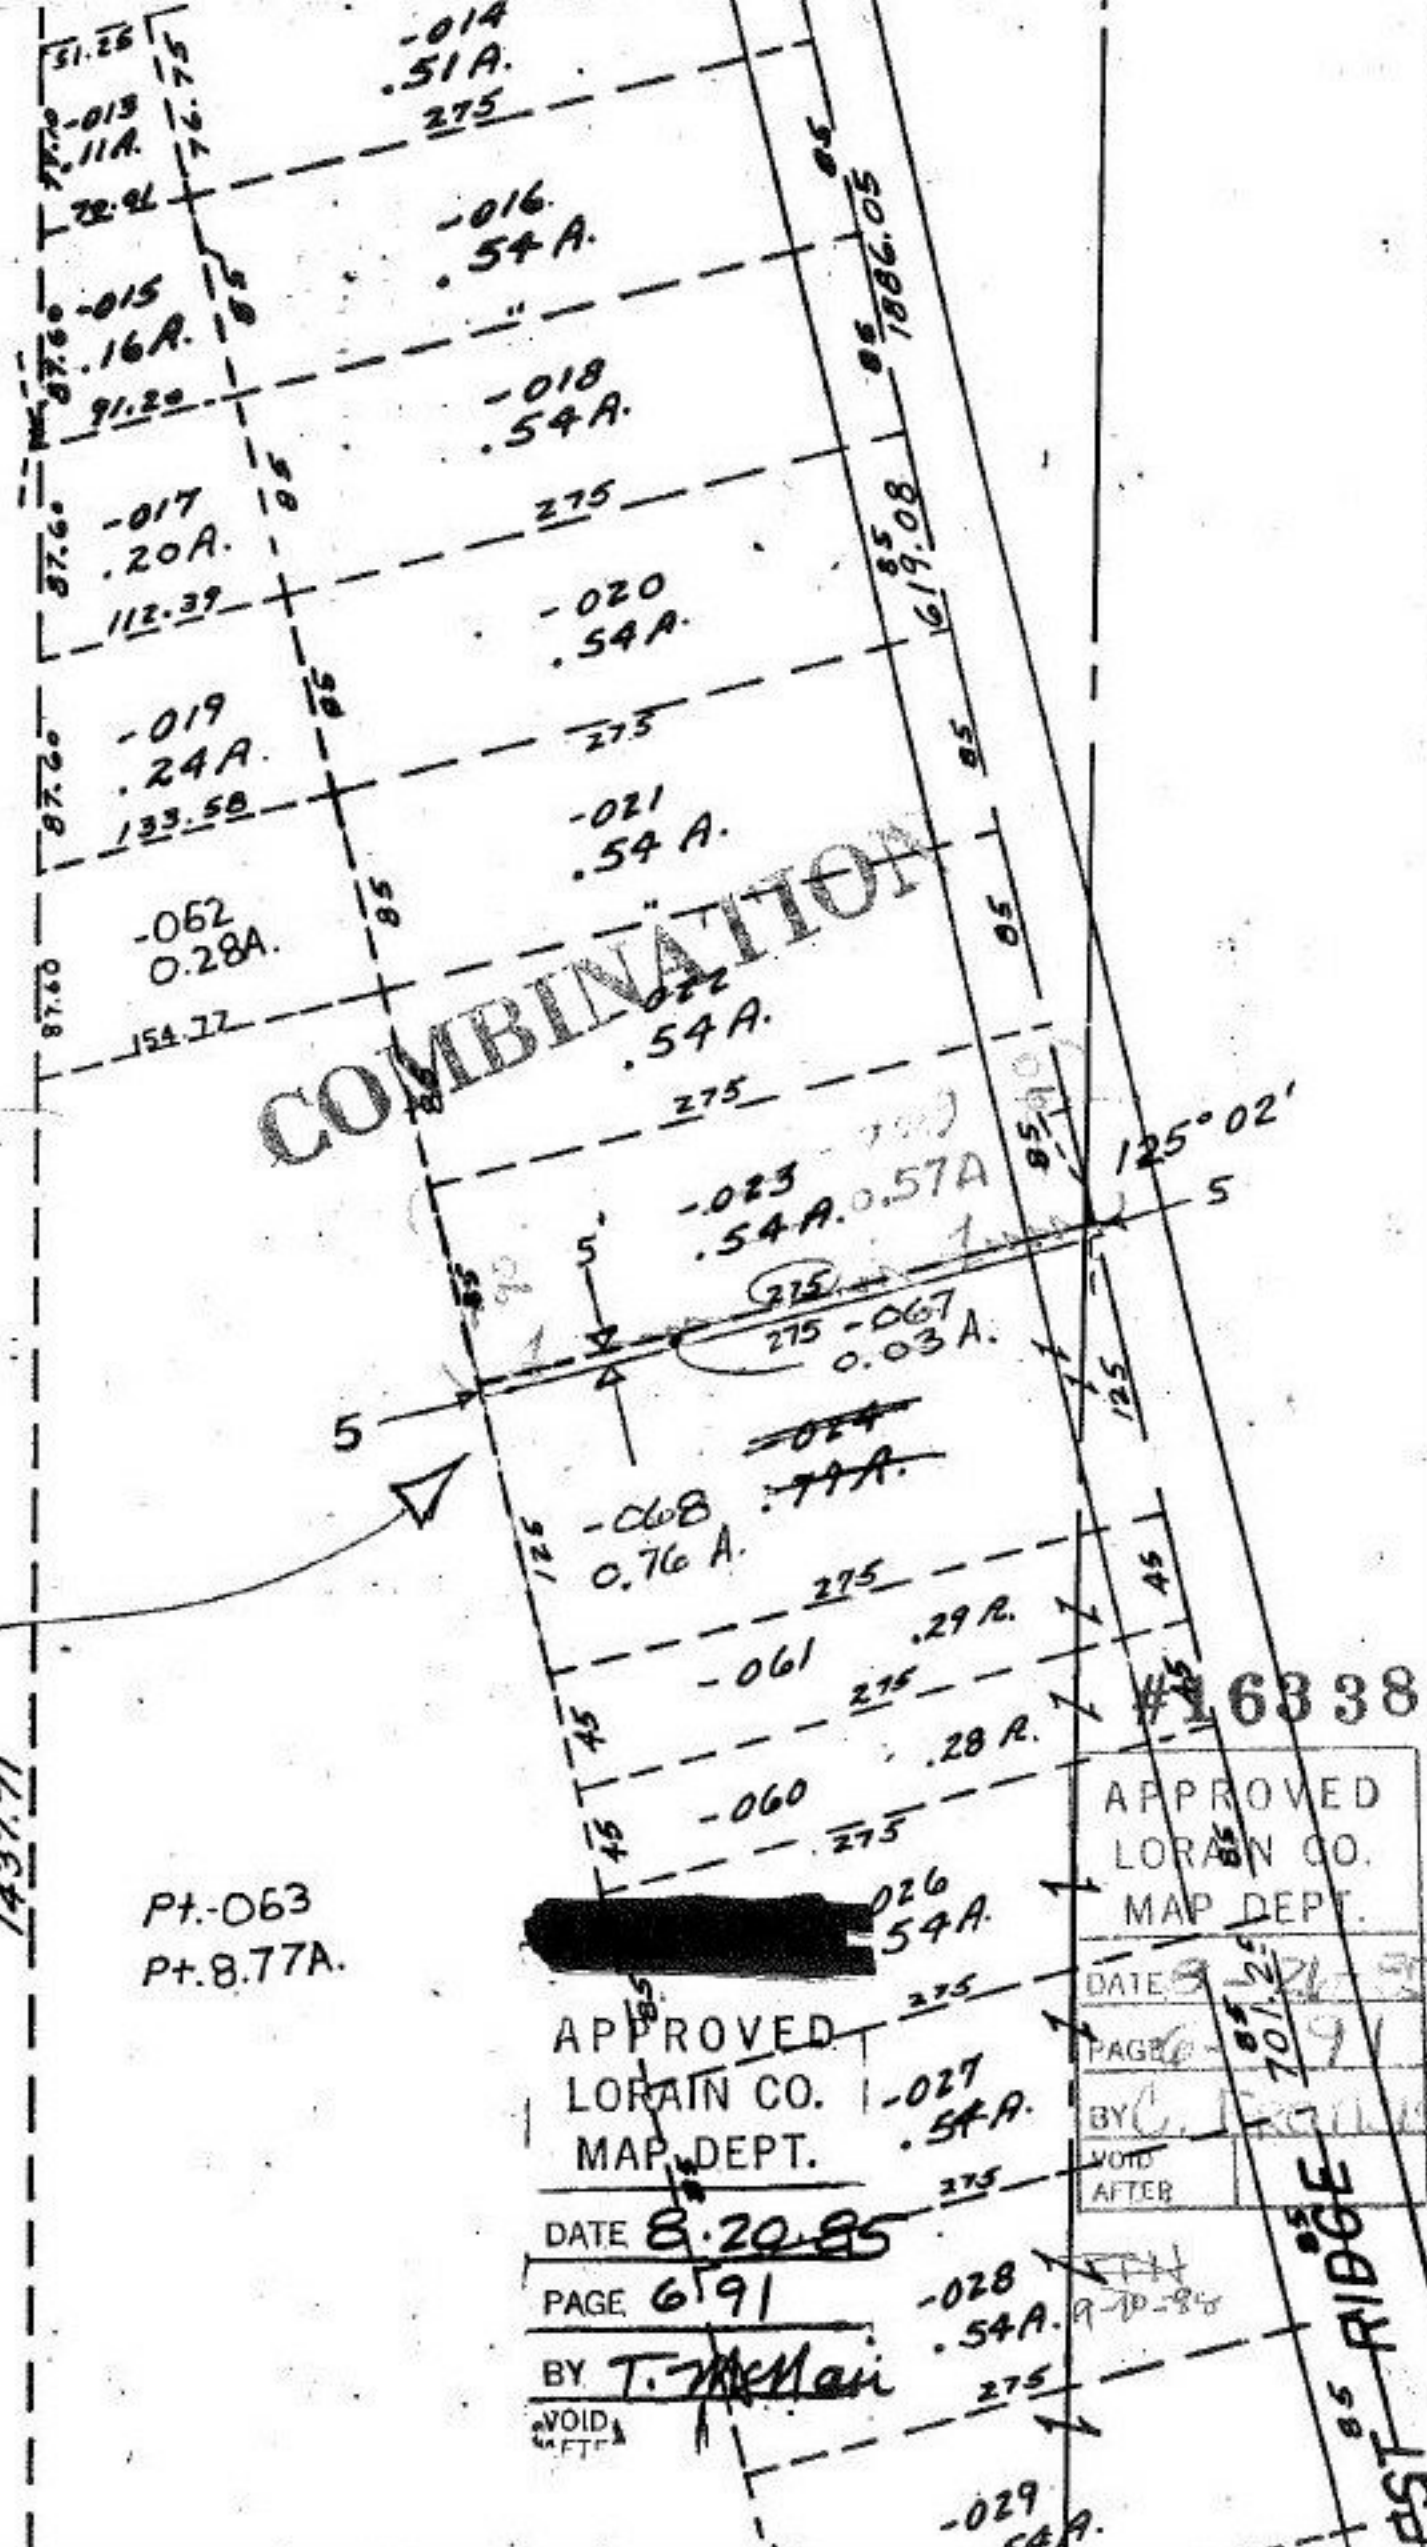

SEE SURVEY

BY  
JOHN HAMILTON  
AND/OR KE. MCCARTNEY  
& ASSOC.

CL. 1:∞

Pt.-063  
Pt.-8.77A.

APPROVED  
LORAIN CO.  
MAP DEPT.

DATE 8.20.85

PAGE 6191

BY T. McMan

VOID  
AFTER

APPROVED  
LORAIN CO.  
MAP DEPT.

DATE 8/20/85

PAGE 6191

BY C. FRILL

VOID  
AFTER

#16338

1ST 85 RIDGE