


101

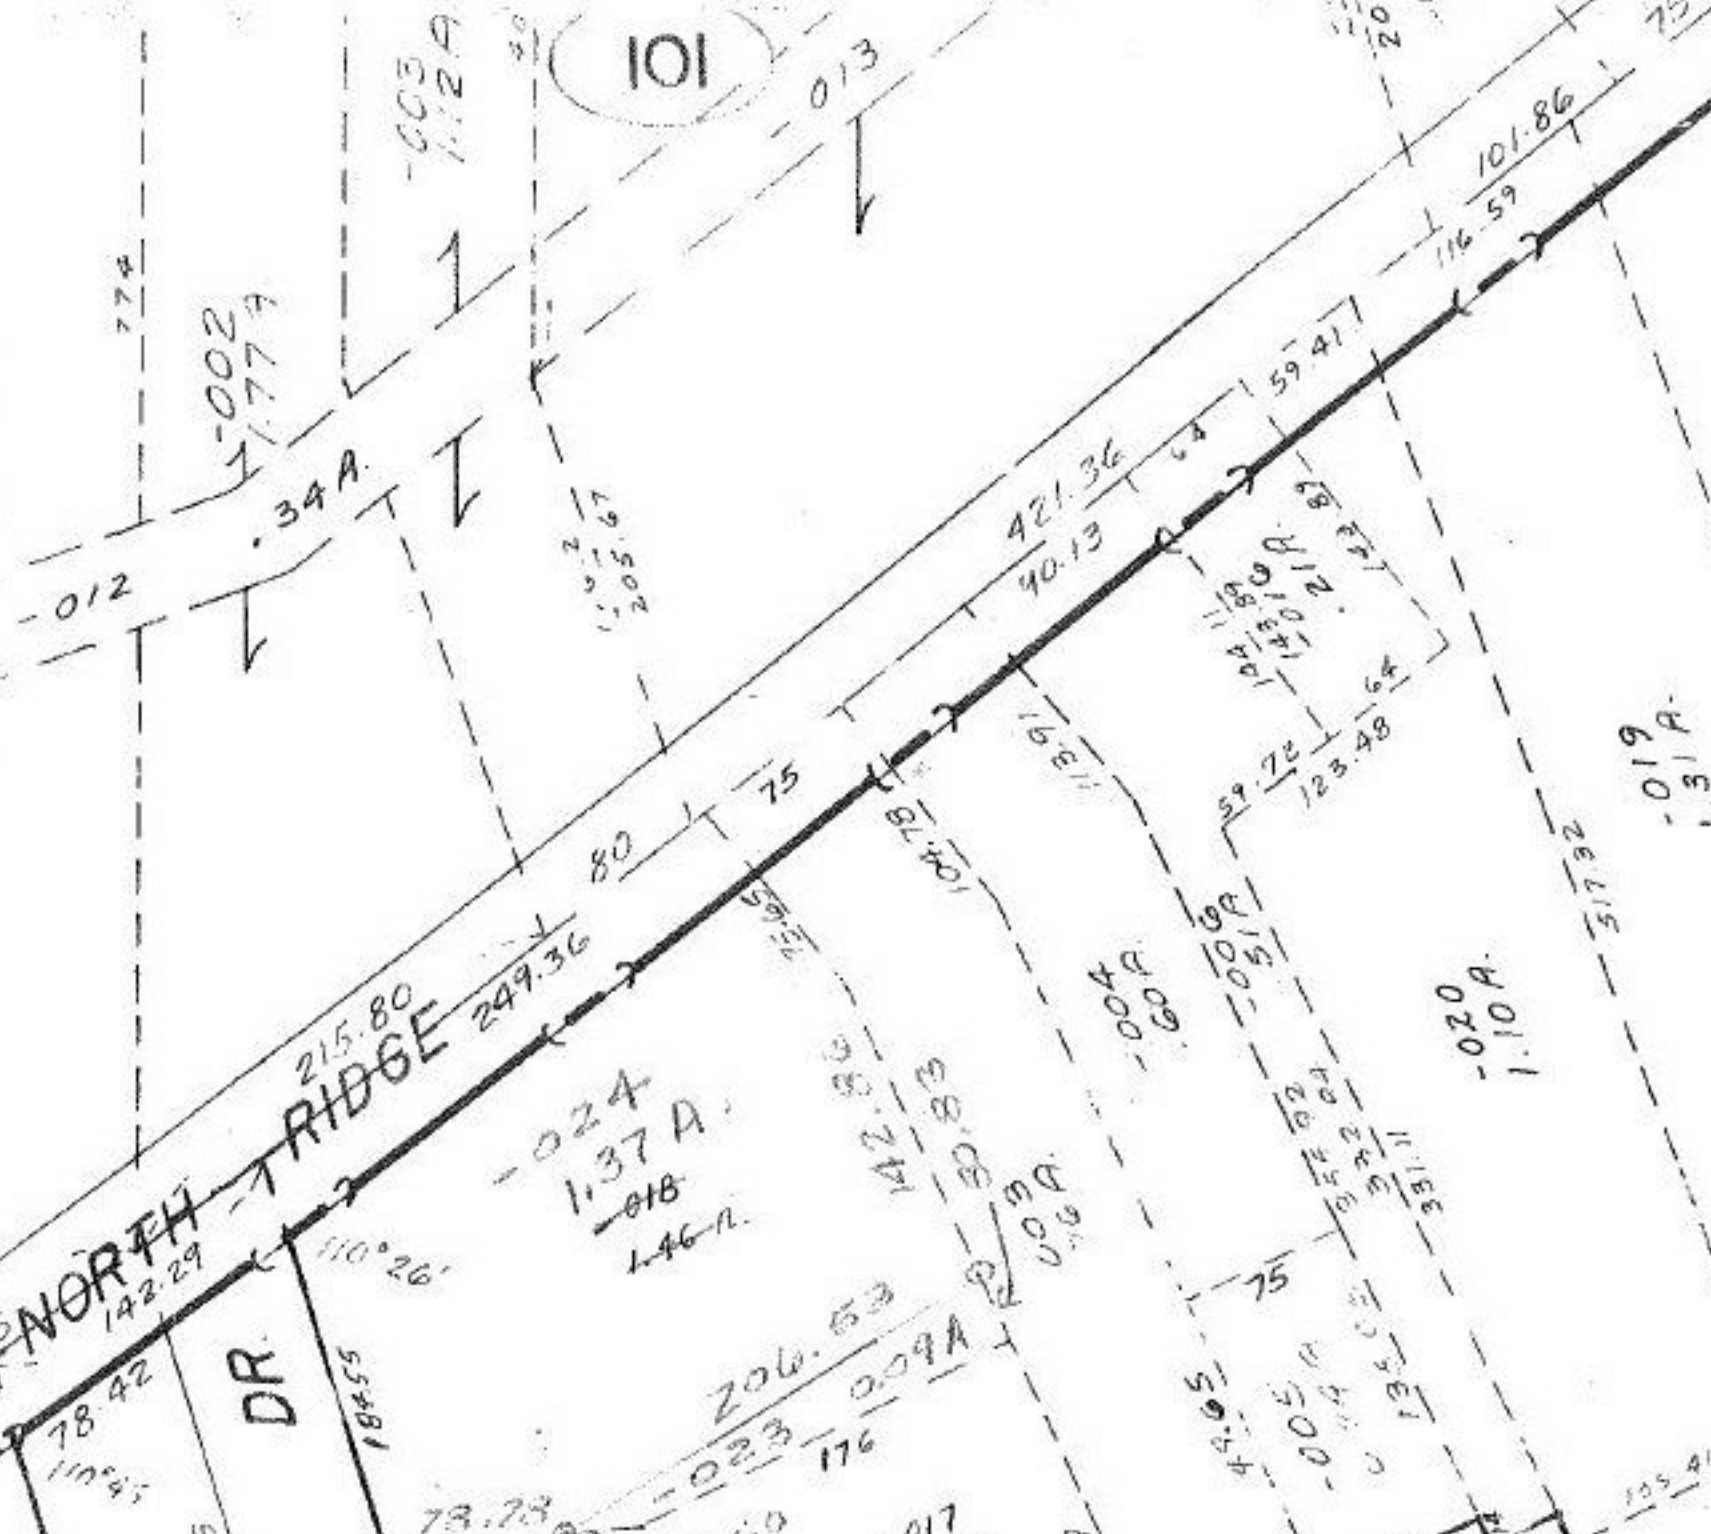

APPROVED
 LORAIN CO.
 MAP DEPT.
 DATE: 6-6-05
 PAGE 5-01-05
 BY C. FRANCIS
 VOID AFTER

16357

NORTH RIDGE LN

LAUREL

ALLT

DR.

HEMLOCK

NORTH

RIDGE

019

020

017

024

002

012

013

003

004

005

022