
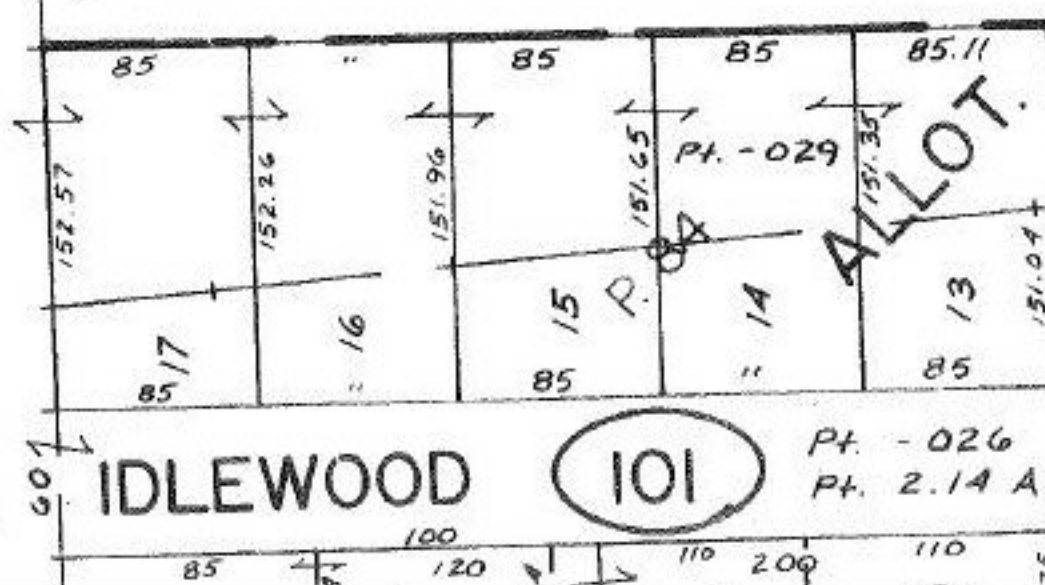


SEE 6-24

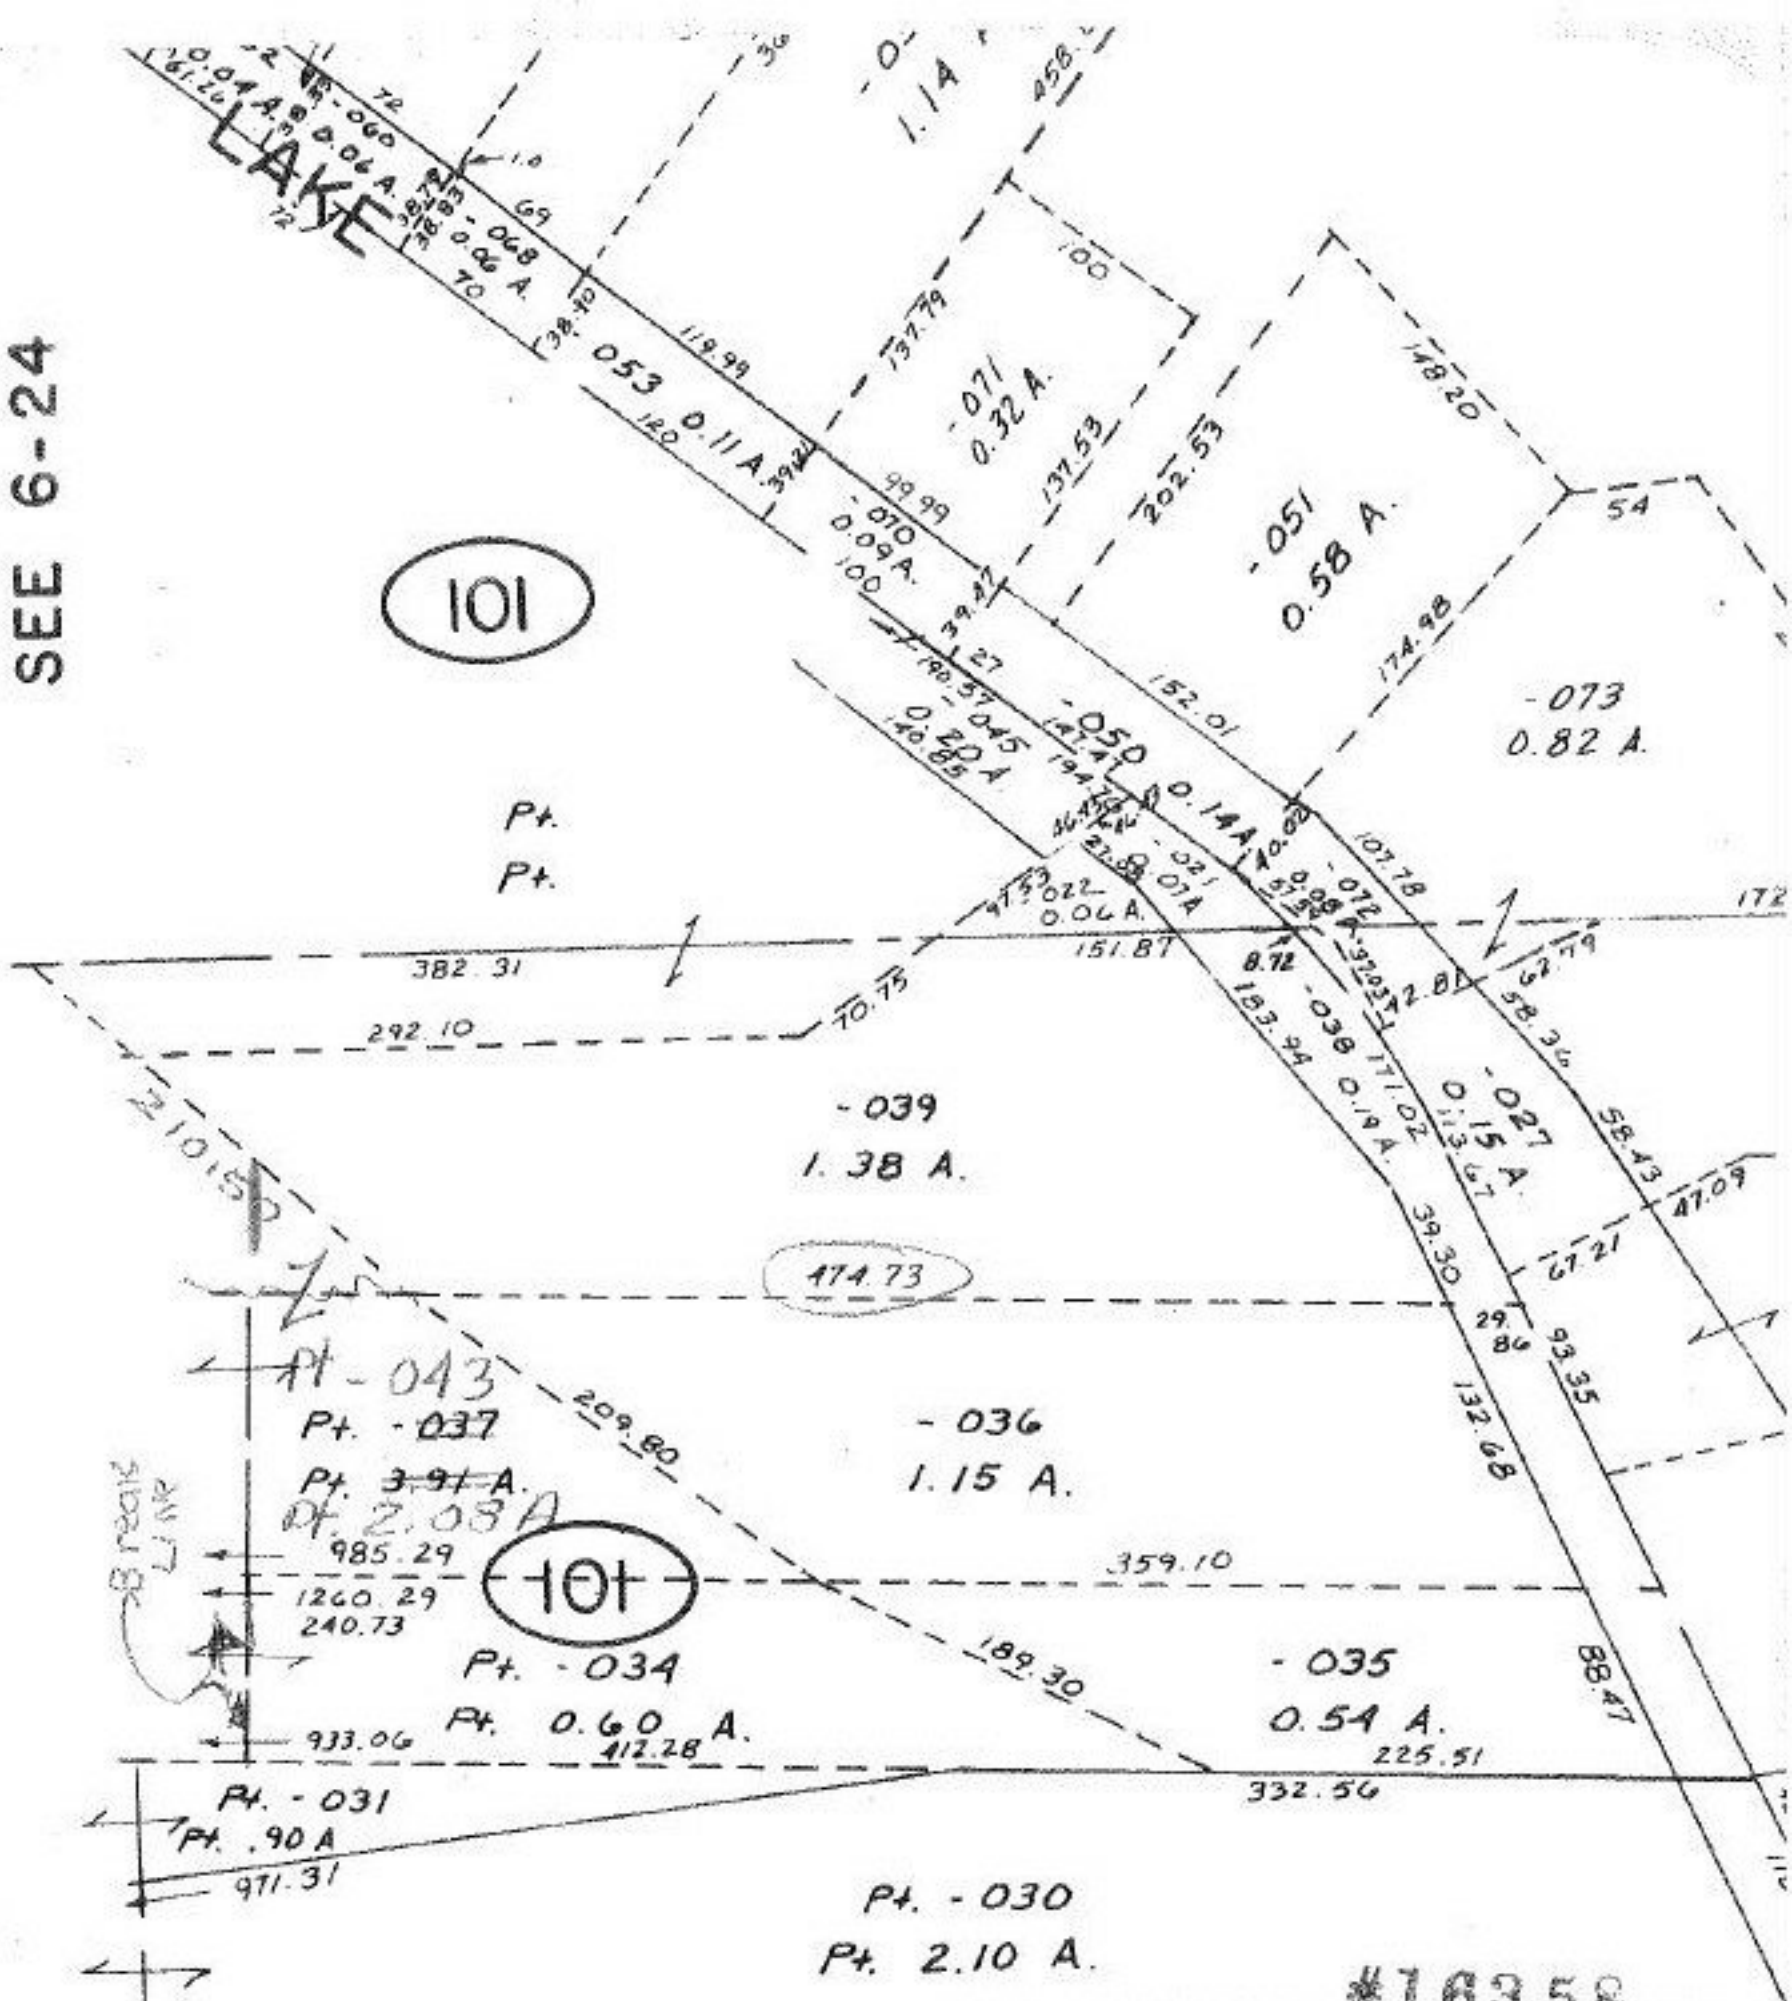

#16358

APPROVED

LORAIN CO.

MAP DEPT.

DATE 9-027-35

PAGE 1.04 A.

BY C. Francis

VOID AFTER 16358

226.18

246.26

297.10

DF