


SEE 7-00-021-C

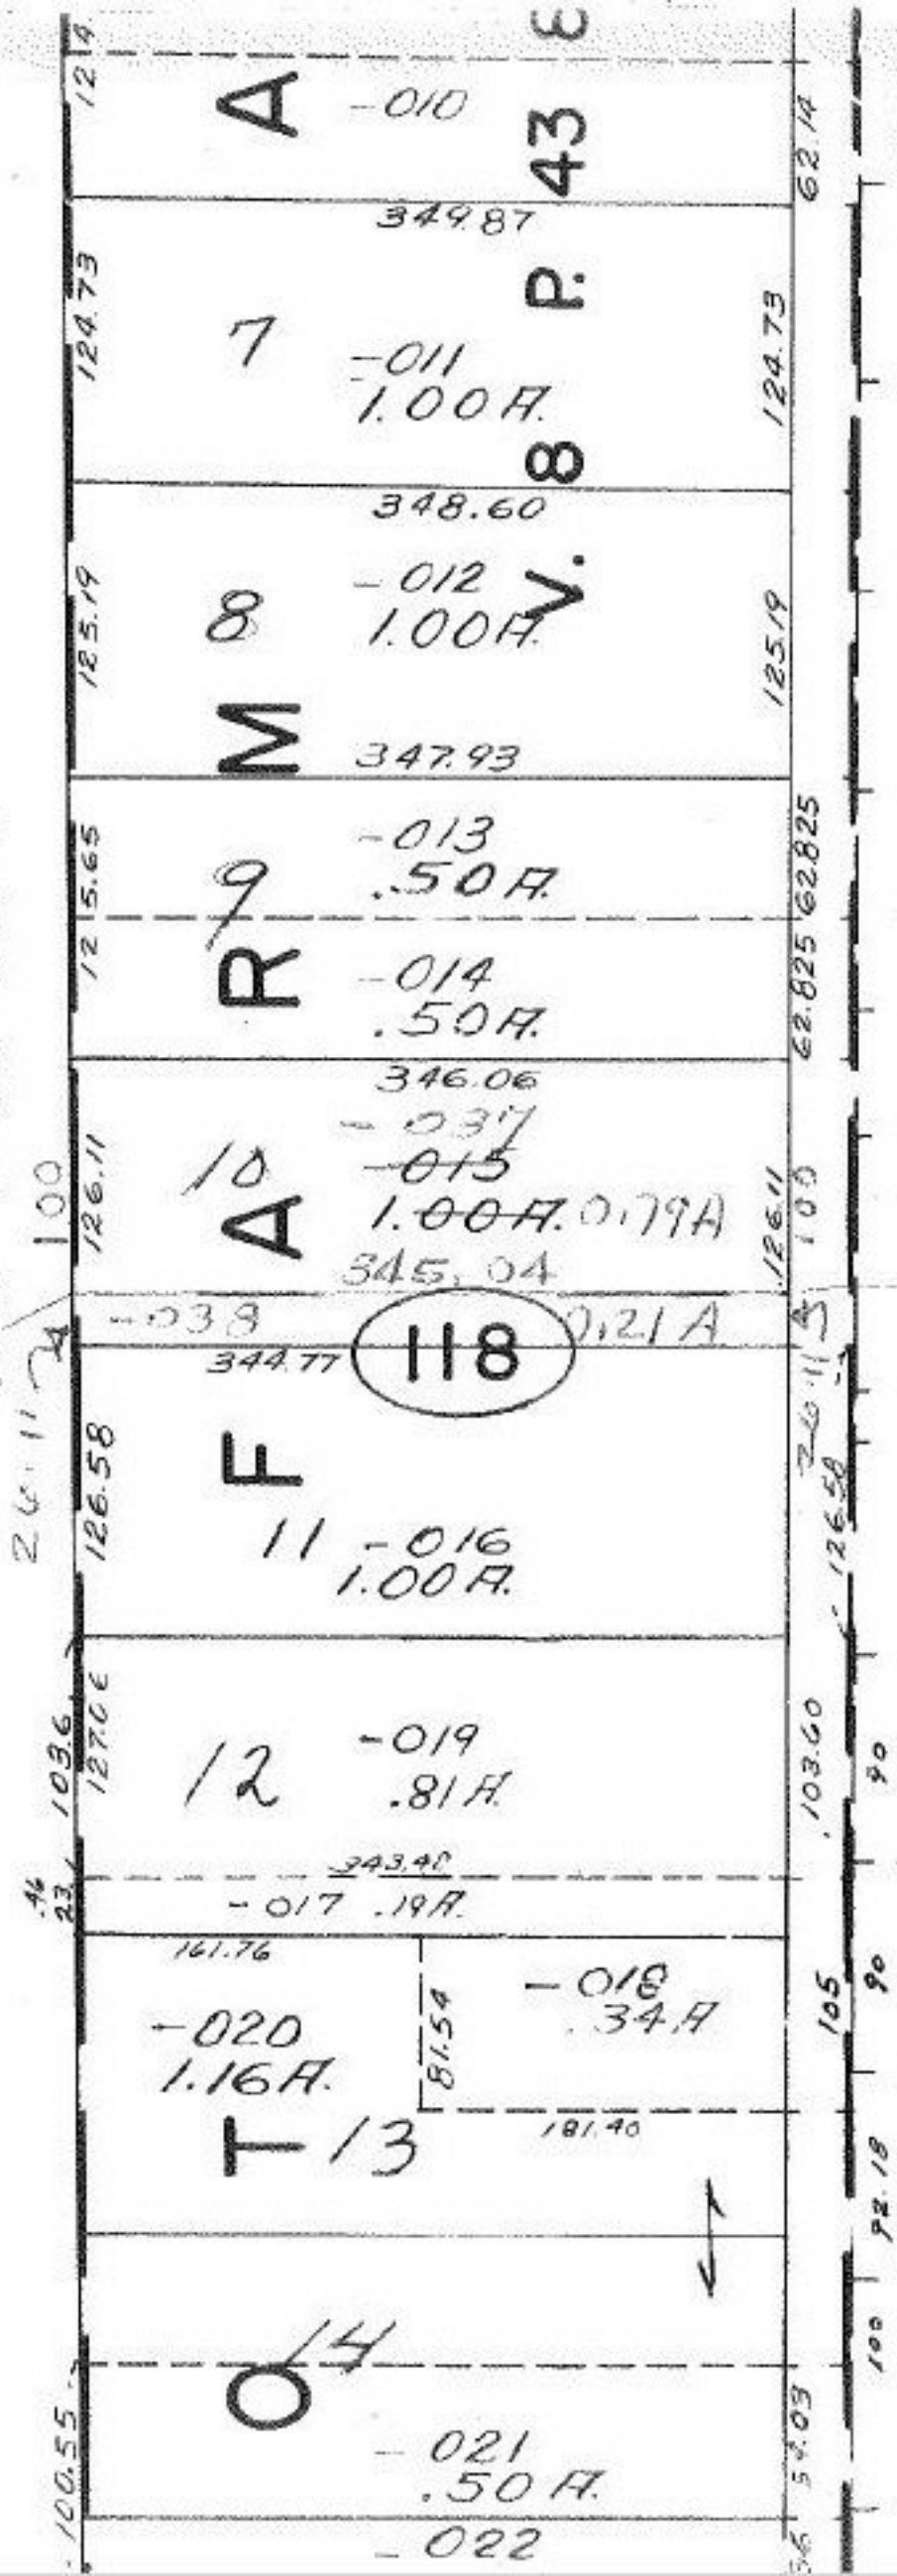

465.7
-047
.90
465.78
-041
.90
466.2
-012
1.00
456.0
466.7
-013
1.00
466.7
456.0
-014
1.00
467.03
-04
.5
350
-017
.88 H.
350
467.3
-04
1.00
467.6
-061
.97
469
#16368
APPROVED
LORAIN CO.
MAP DEPT.
DATE 9-11-85
PAGE 7-00-021-D
BY C. FRANCIS
VOID
AFTER
10-18-85
-06
.96
47
468
056
1.07
469
-02