

SEE 0-44

12.0

400.0

2057.16  
1658.73

06-24-033-102

~~Pt. 004~~  
~~Pt. 1308 A.~~

Pt -009

Pt 84.14A


1976.32

102

33

~~Pt -005~~

~~Pt. 20.60 A.~~

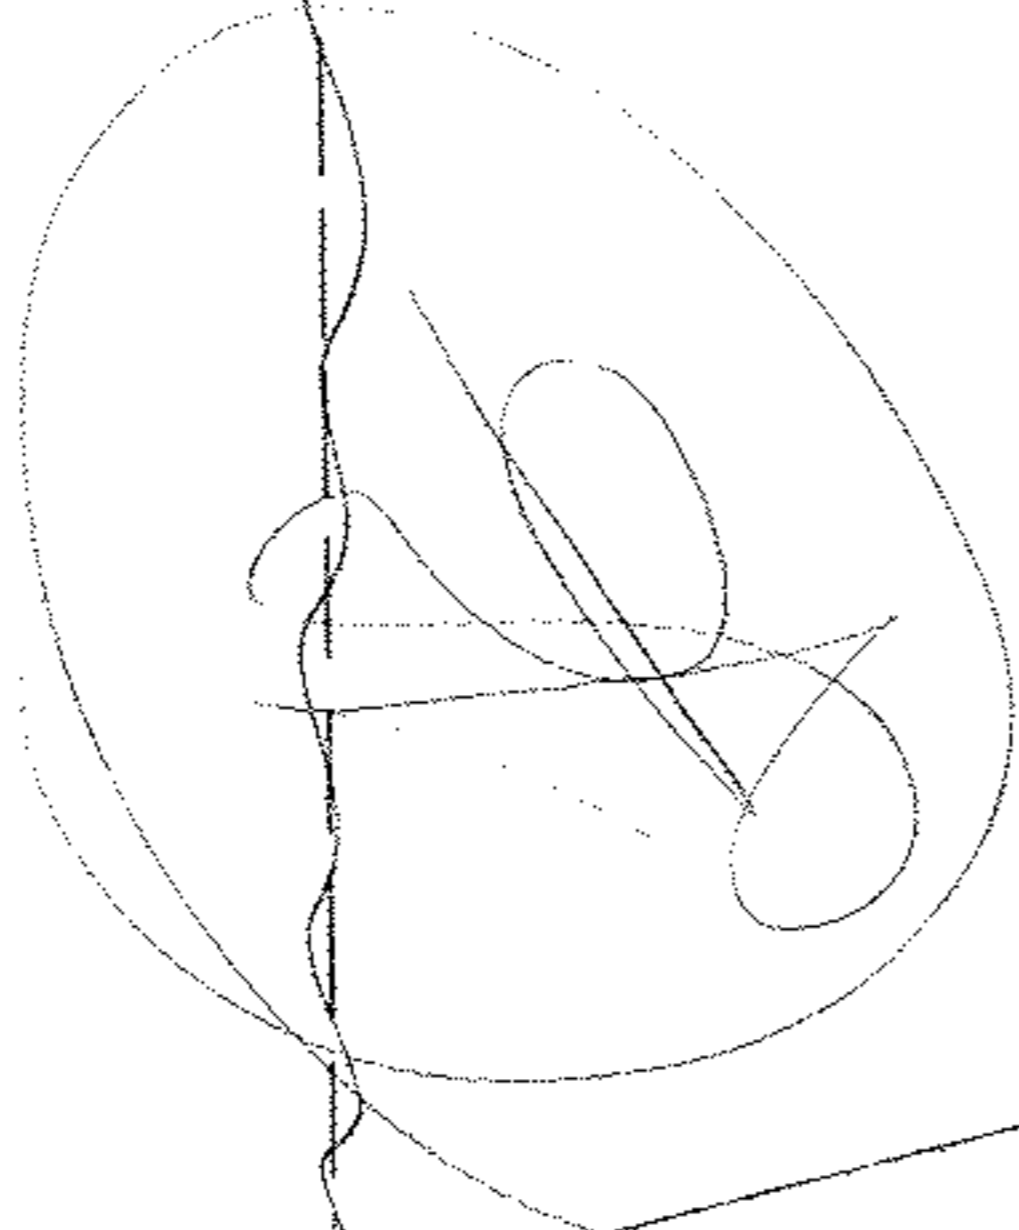

1637  
 APPROVED  
 LORAIN CO.  
 MAP DEPT.  
 DATE 3-26-68  
 6-62  
 BY A. Maynard

OHIO

Pt. -008	#1
8.40 A. Dup.	#2
8.38 A.	#3
8.38 A.	#4
.05 A.	#5
.20 A.	#6
3.80 A.	#7
6.91 A.	
Pt. 36.12 A. Total	

6-62

TURNPIKE

~~Pt. 06-24-033-102-005~~

~~Pt. 20.60 A. -024~~

~~(5.20 A.) 4.10 A.~~

CORP