


3-05	32-060	3-057	33-028	3-056	33-028
2-055	31	2-058	32-029	2-057	32-029
1-056 125	30 112.03	1-059 112.03	31-030 112.03	1-058 112.03	31 112.03

(39th ST.) ST.

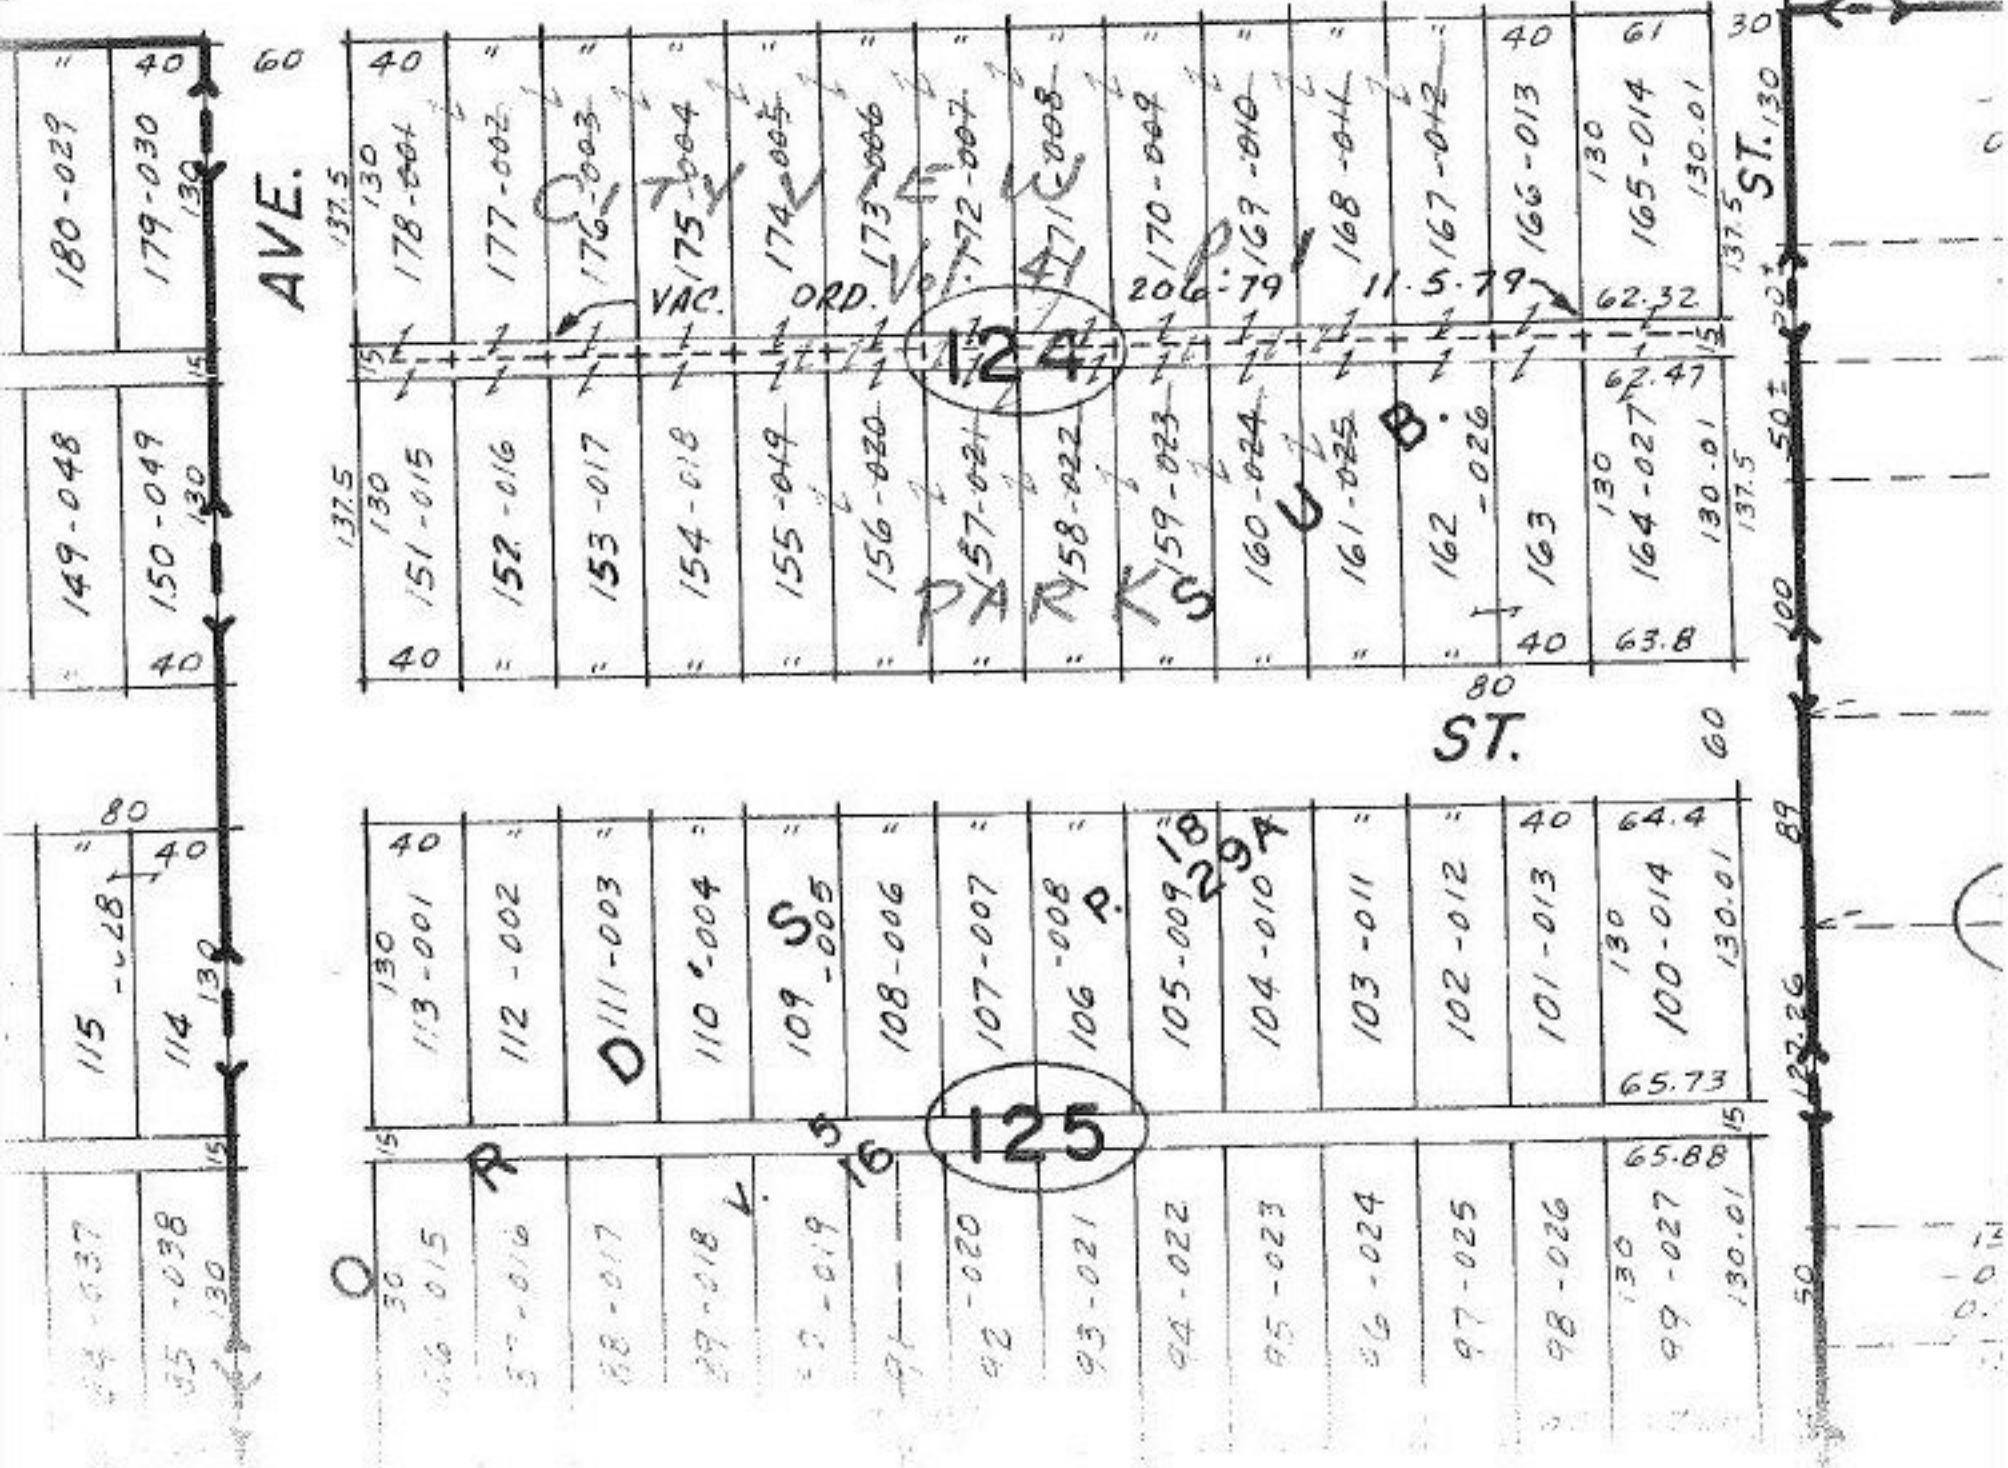

OUT OF  
03-00-103-124-001 THRU 012  
- 019 THRU 025

# CITYVIEW PARK DEDICATION PLAT

#16372

APPROVED  
LORAIN CO.  
MAP DEPT.

DATE 9.18.85

PAGE 3.00.103.B

BY T. McMain

VOID

