


SEE 12-00-041-B

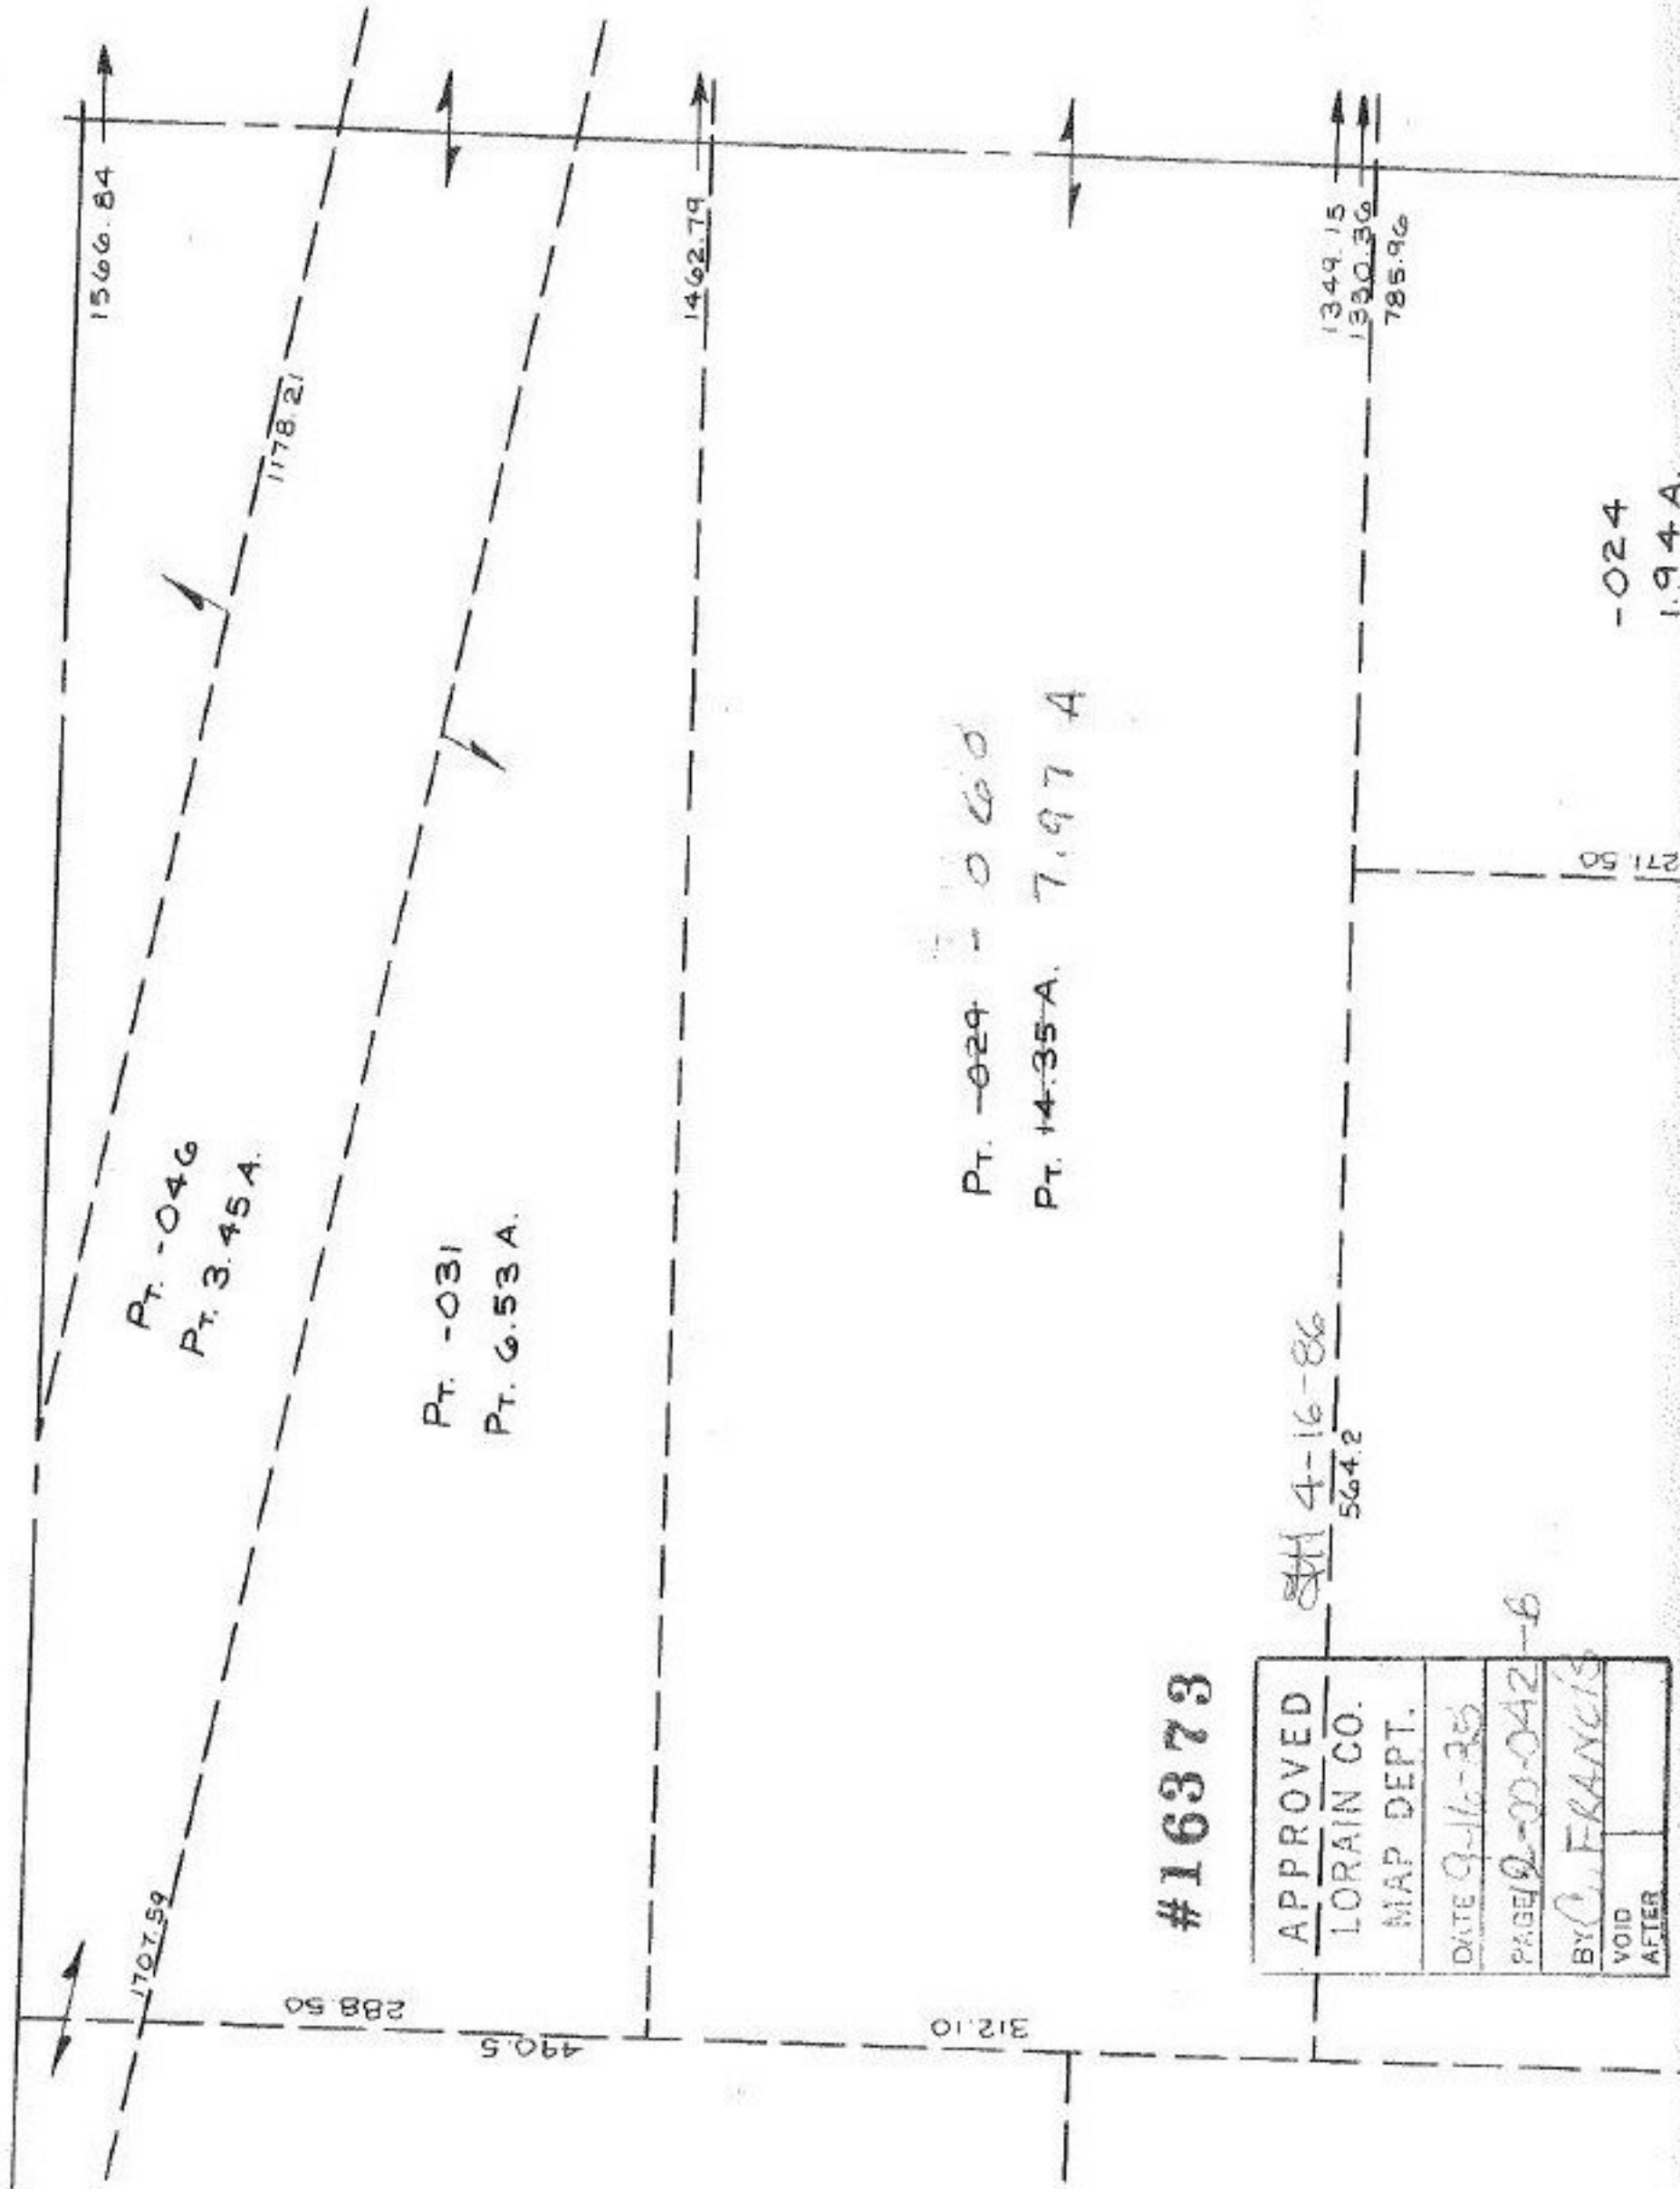

#16373

APPROVED	BY C. FRANCIS
LORAIN CO. MAP DEPT.	
DATE 9-16-86	VOID AFTER
PAGE 12-00-042 -6	

4-16-86  
564.2

-024  
1.94 A.