
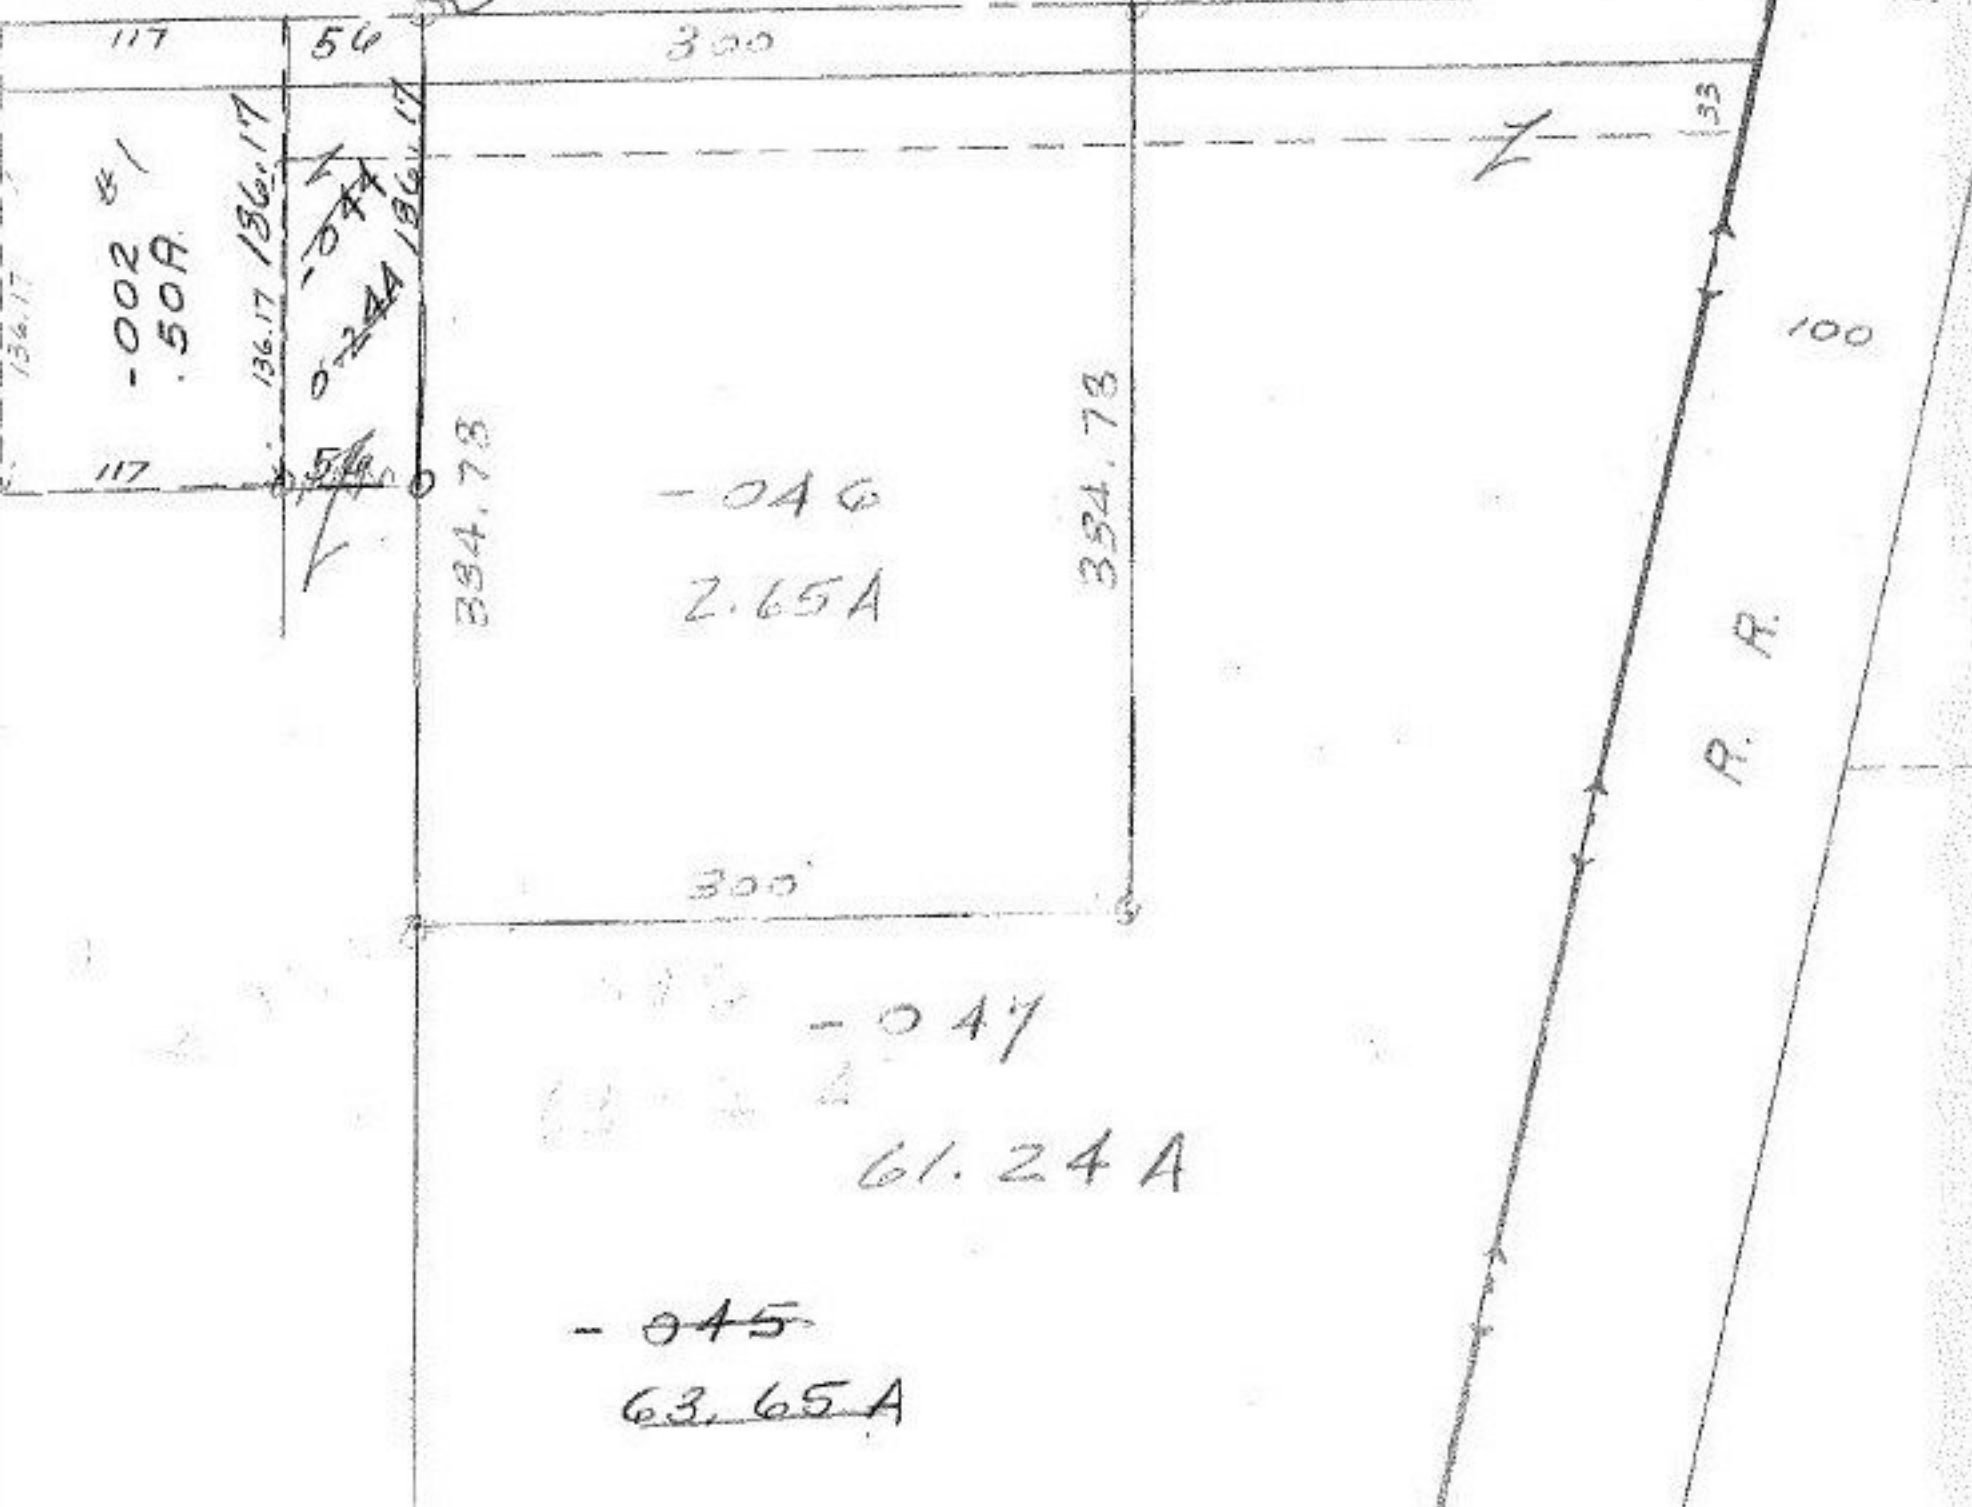


C-073-A

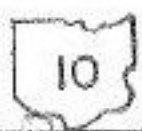

-046
2.65A

-047
61.24A

-045
63.65A

Surveyed by Laundon,
Simon, Calk & Assoc.

FOR See ~~6~~ 16510
Parcel Number
Correction

#16392

APPROVED
LORAIN CO.
MAP DEPT.
DATE 10-22-85
PAGE 9-00-083-A
BY C. FRANCIS
VOID AFTER

4-88
4-8-86