


SEE 3-00-101-B

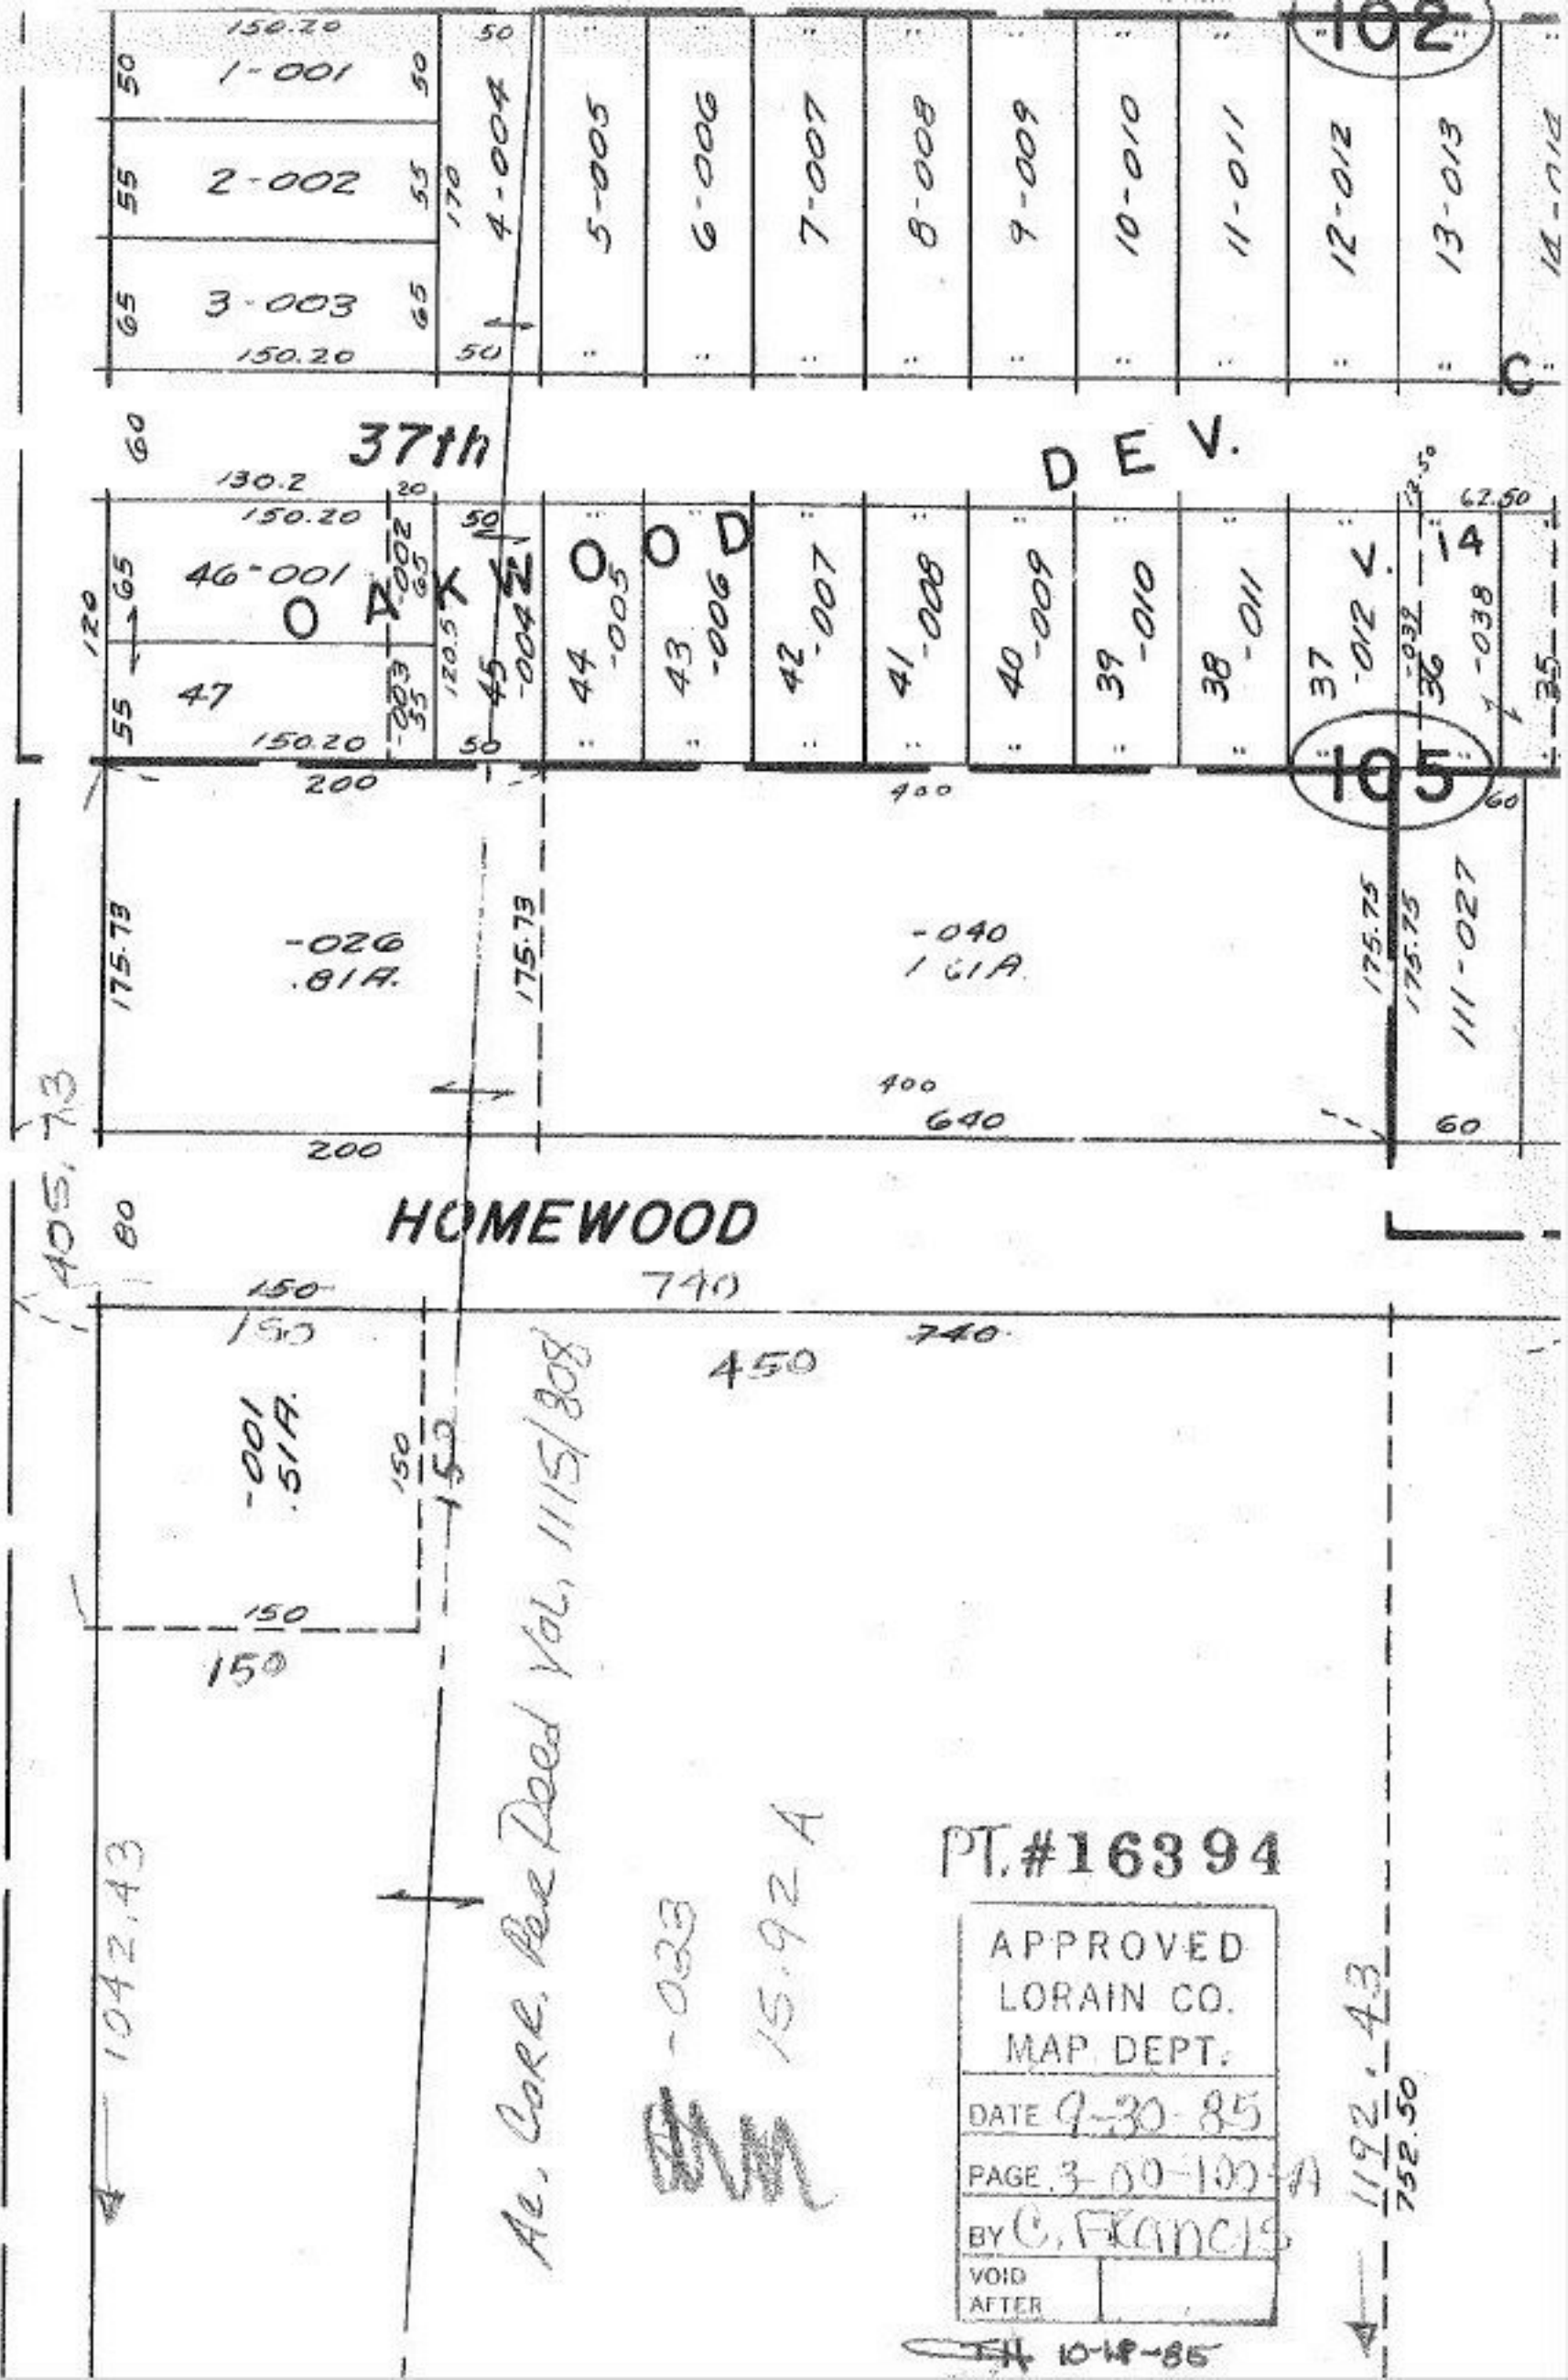

405.73

1042.43

HOMEWOOD

DEV.

Ac. CORRE. Per Deed Vol. 1115/808

~~15.92~~ 15.92 A

PT. #16394

APPROVED
LORAIN CO.
MAP DEPT.
DATE 9-30-85
PAGE 3-00-101-A
BY C. FRANCIS
VOID AFTER

10-18-85

1192.43
752.50

105

102

37th

65	3-003 150.20	65	4-004	50
55	2-002	55	5-005	50
55	1-001	55	6-006	50
55		55	7-007	50
55		55	8-008	50
55		55	9-009	50
55		55	10-010	50
55		55	11-011	50
55		55	12-012	50
55		55	13-013	50

55	47	55	46-001	50
55		55	45-002	50
55		55	44-003	50
55		55	43-004	50
55		55	42-005	50
55		55	41-006	50
55		55	40-007	50
55		55	39-008	50
55		55	38-009	50
55		55	37-010	50
55		55	36-011	50
55		55	35-012	50
55		55	34-013	50

175.73	-026 .81A.	175.73	-040 1.61A.	400
175.73		175.73		640
175.73		175.73		60

80	-001 .51A.	80	740	450
80		80	740	740

150	150	150	150	150
-----	-----	-----	-----	-----

150	150	150	150	150
-----	-----	-----	-----	-----

