


70

71

ST. 5

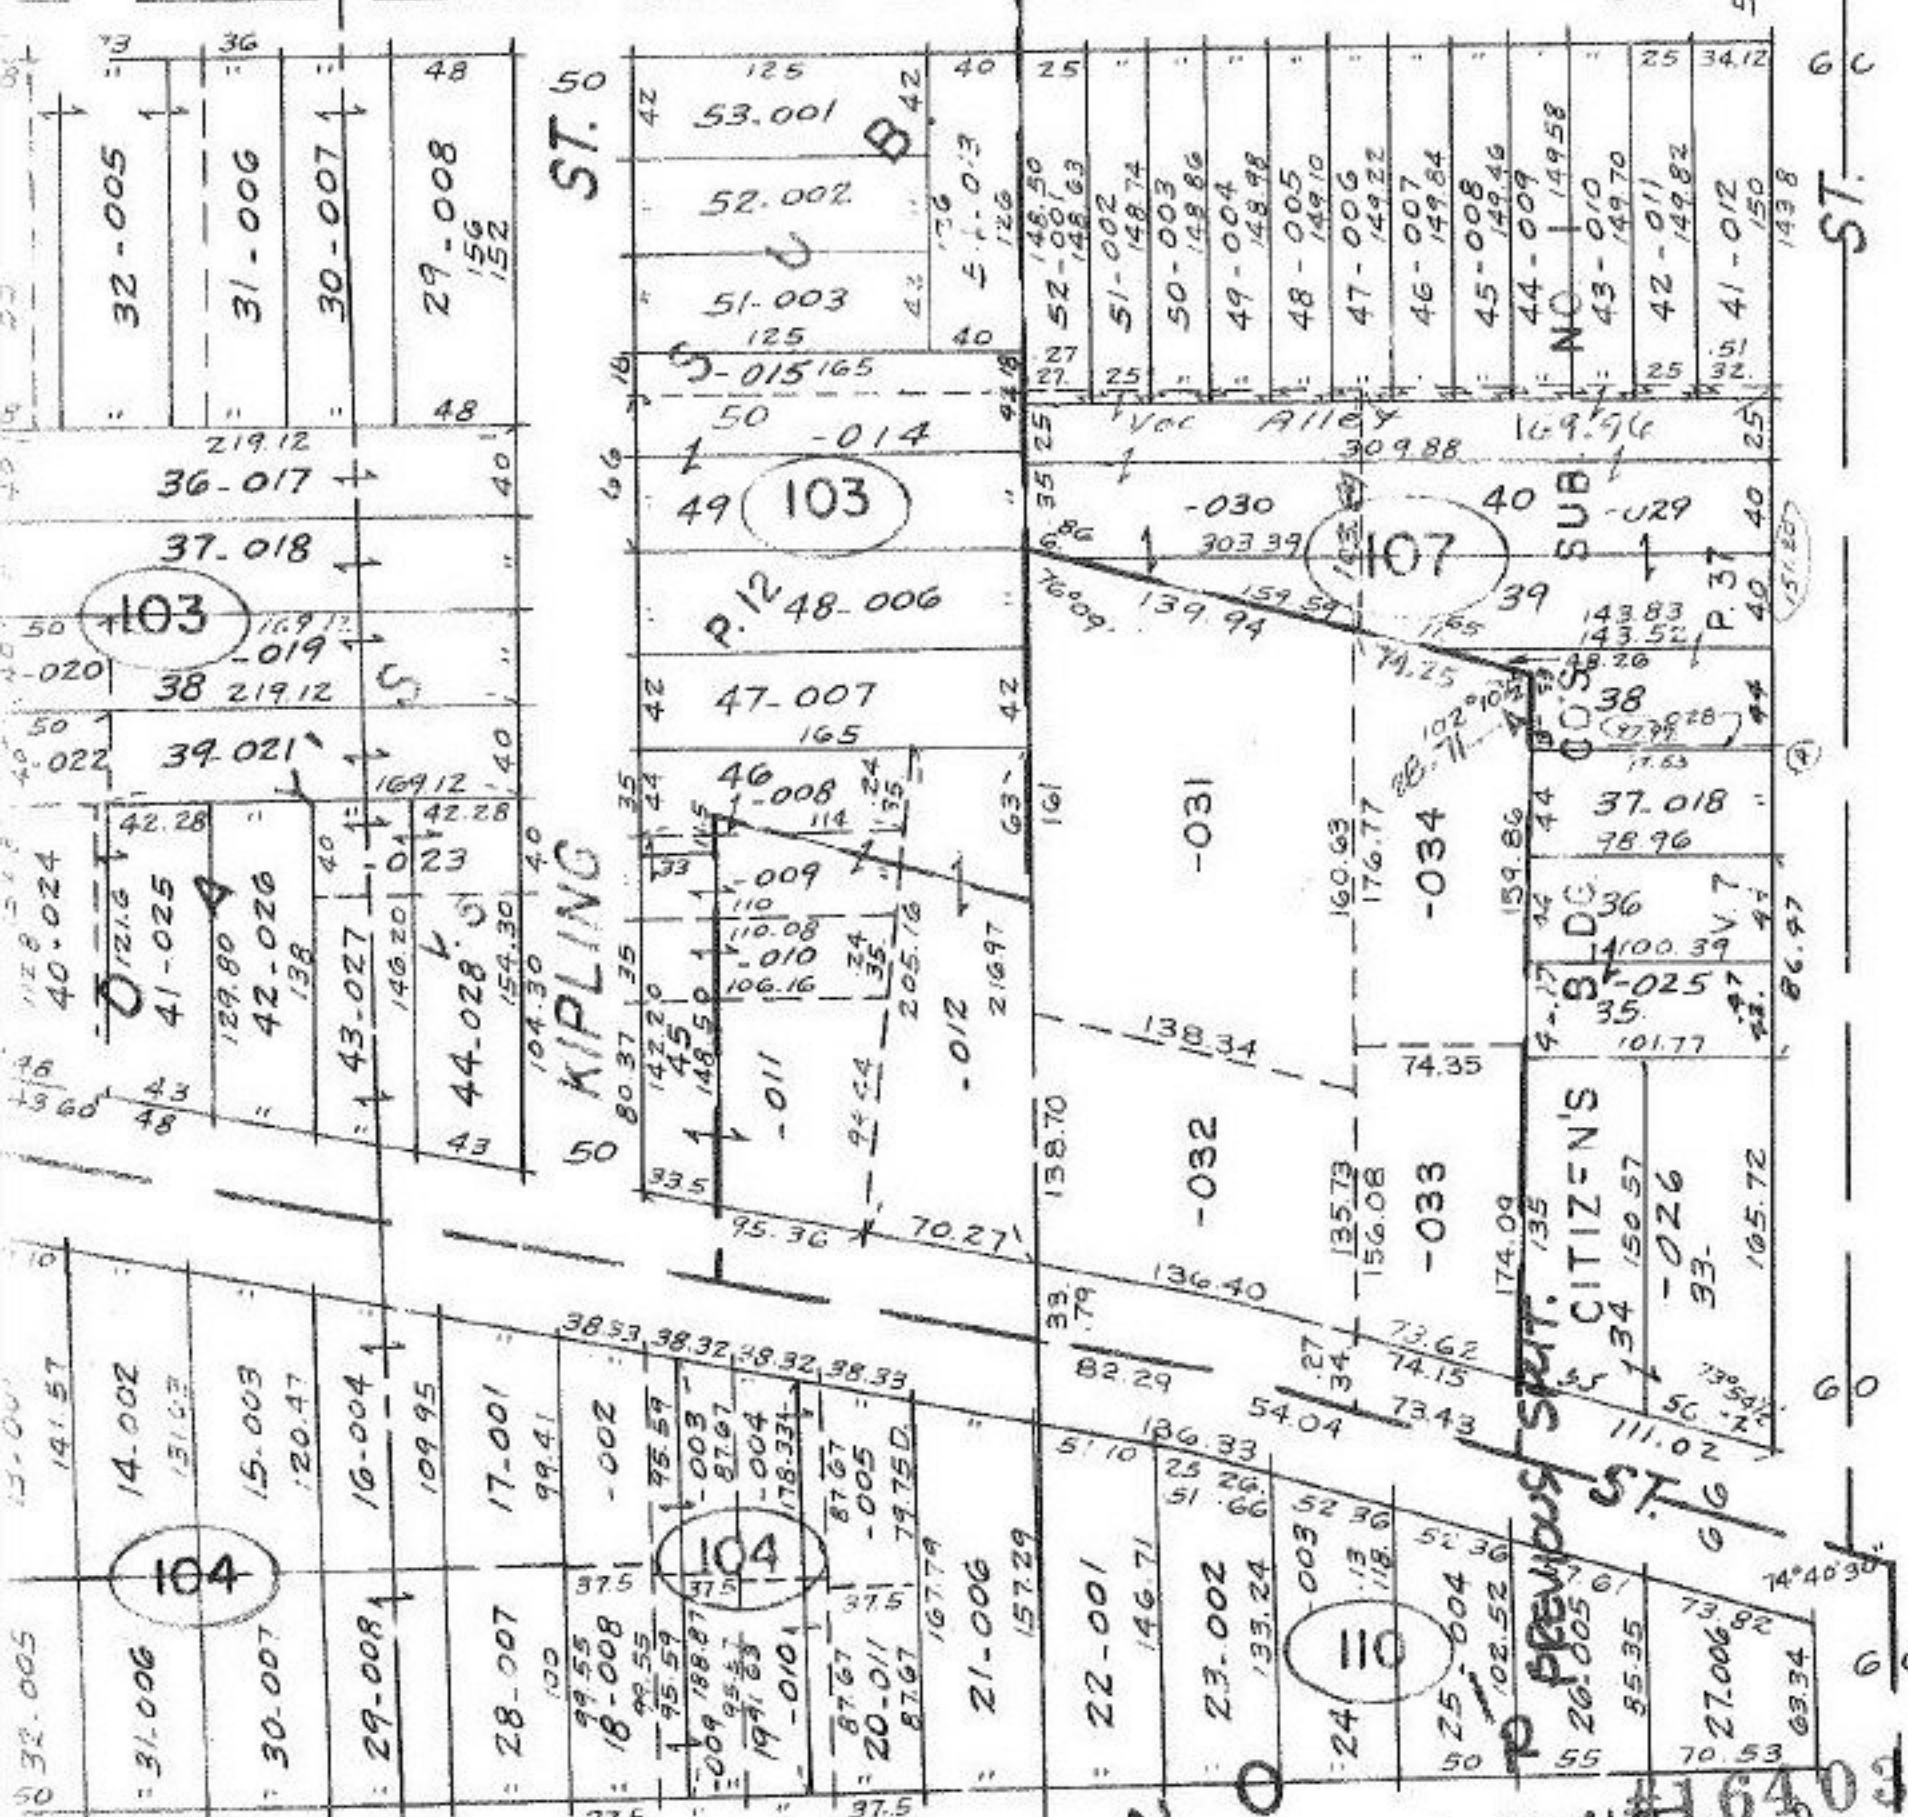

ST. 6

ST. 6

**CORRECTION**  
 ADDS DIMENSIONS  
 APPROVED  
 TO MAP DEPT.  
 DATE 10-10-85  
 PAGE 122  
 BY T. McNeil  
 12-6-85